


Job Number	Date Drilled	Well ID	Drilling Team/Contractor
11677-MRL Red	2019-05-14	U439	Andy civil group
Well Type		Responsible Person	Location
Gas		Leigh Brown	Melbourne Regional Landfi
Well Completion Detail		Approved Drill Depth (mBGL)	Well Casing Diameter (mm)
		30	225
Length of Riser (m)		Waste Stream and Comments	
Ground/Liner Level ↓		1.5	
Well Seal Length (m)	3.5	Plain Pipe Length (m)	4
		0m - 2m damp rubbish	
		2m - 4m damp rubbish	
		4m - 6m damp rubbish	
		6m - 8m damp rubbish	
		8m - 10m damp rubbish	
		10m - 12m damp rubbish	
		12m - 14m damp rubbish	
		16m - 18m damp rubbish	
		18m - 20m damp rubbish	
		20m - 24m damp rubbish	
Length of Gravel Above Last Perforation (m)	0.5	Plastic Seal (Yes/No)	yes
Length of Gravel Below Last Perforation (m)	26	Length of Perforated Pipe (m)	26
End Cap			


Well Completion Summary			
Depths are Measurements of Metres Below Ground Level (mBGL) - Ground Level = 0			
Plain Pipe Start Depth (mBGL)	0	Completed Drilling Depth (mBGL)	Well Seal Type
Plain Pipe End Depth (mBGL)	4	30	Clay/Bentonite
Perf Pipe Start Depth (mBGL)	4	Completed Well Casing Depth (m)	Plastic Seal Type
Perf Pipe End Depth (mBGL)	30	30	Bag
Well Seal Start Depth (mBGL)	0	Well Casing Rating (PN)	End Cap Type
Well Seal End Depth (mBGL)	3.5	11	Butt-Welded
Gravel Start Depth (mBGL)	3.5	Location Left Clean (Yes/No)	Responsible Person Sign Off
Gravel End Depth (mBGL)	30	Yes	

Photo - Take Photo of Completed Well

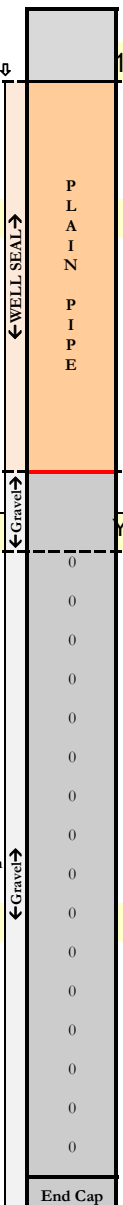