


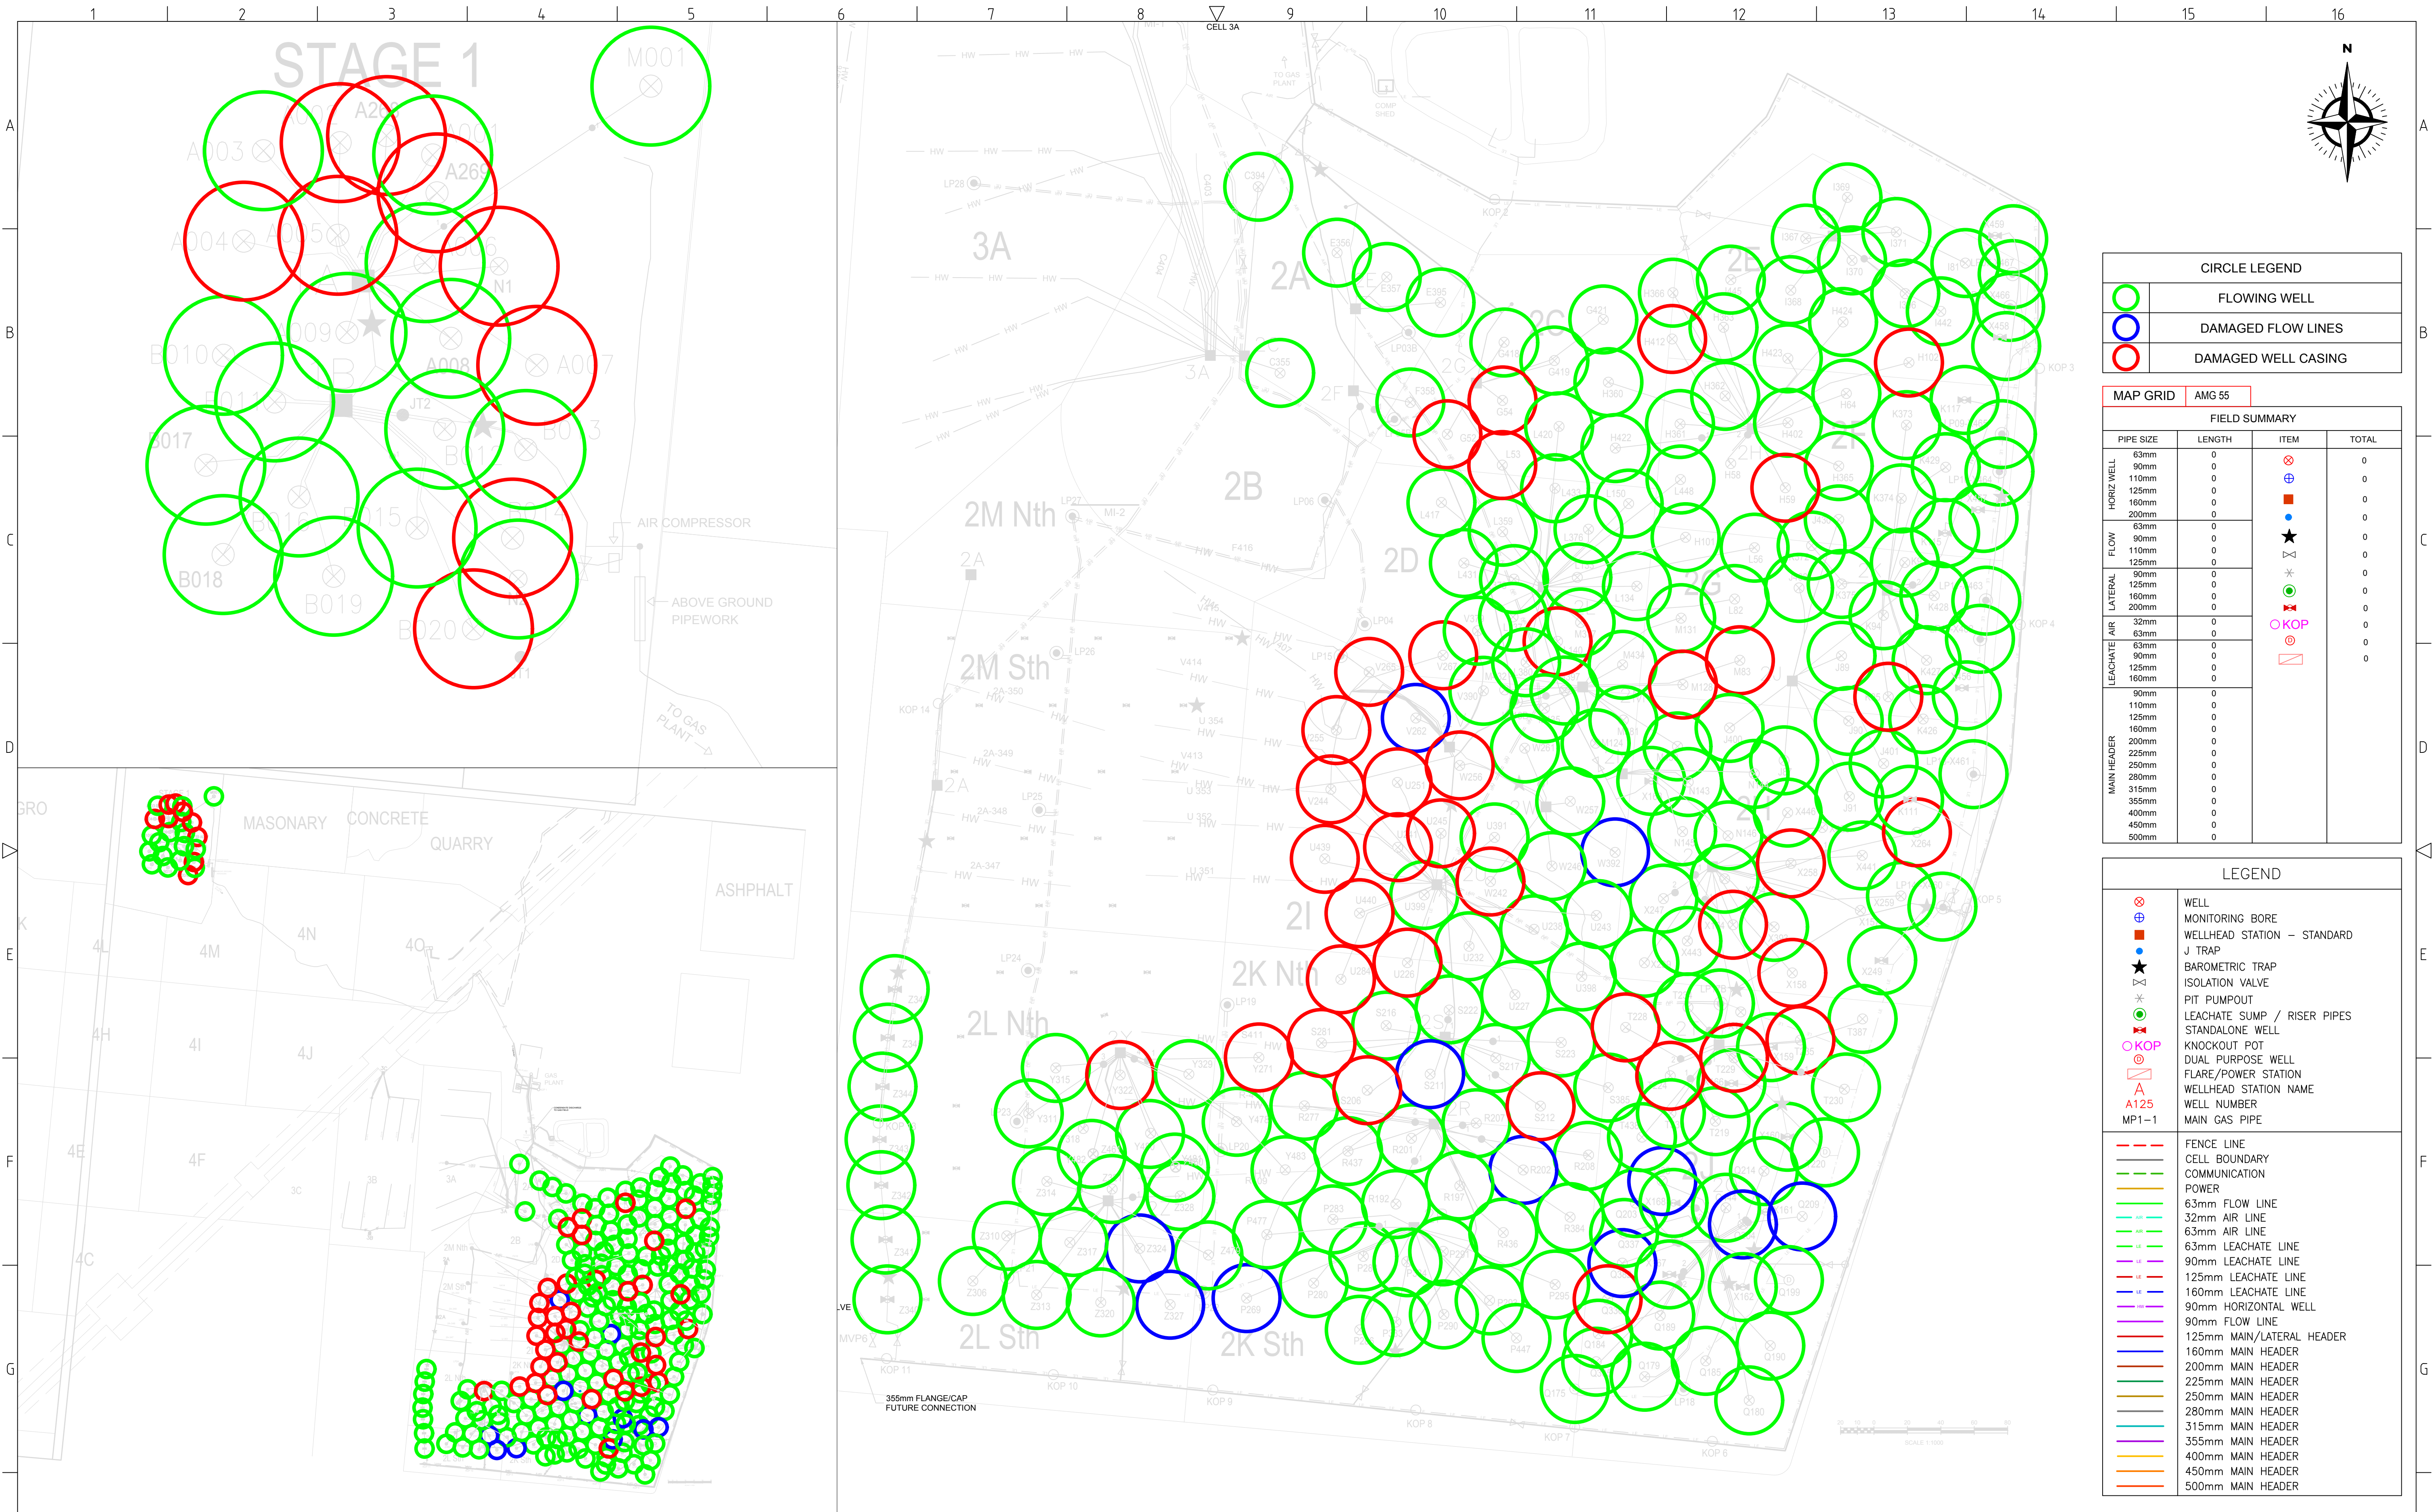

						O	2L CELL REDRILLS			BC	LB	LB	24.5.2018		PROJECT: MELBOURNE REGIONAL LANDFILL	DRAWING No: MRL-GCS-001									
						N	MRL FLOW LINE REPLACEMENTS_9 WELLS			BC	LB	LB	24.5.2018				DRAWING TYPE: AS BUILT								
						M	CELL 3B HORIZONTALS AS BUILT			BC	LB	LB	7.5.2018					DRAWING TITLE: MRL_GCS GAS COLLECTION SYSTEM INFLUENCE RADIUS ZONES							
						L	CELL 3B AIR & LEACHATE AS BUILT			BC	LB	LB	7.5.2018						DRAWN: BCCKD: LH						
						K	3A WELL DESIGN			BC	LB	LB	25.1.2018							DATE: 10.5.2017APP: AD					
P	MRL FLOWLINES ADDED/2L CELL REDRILLS				BC	LB	LB	24.5.2018						DESIGNED: ADAPP DATE: 10.5.2017											
REV	DESCRIPTION				BY	CKD	APP	DATE	REV	DESCRIPTION			BY		CKD	APP	DATE				SCALE: DNSSHEET: 1REV: KSIZE: A1				
REVISION HISTORY									REVISION HISTORY									199C OSBORNE AVE, CLAYTON STH, VIC 3169 PH: (03) 9538 6200 www.runenergy.com				13	14	15	16
1	2	3	4	5	6	7	8	9	10	11	12														