


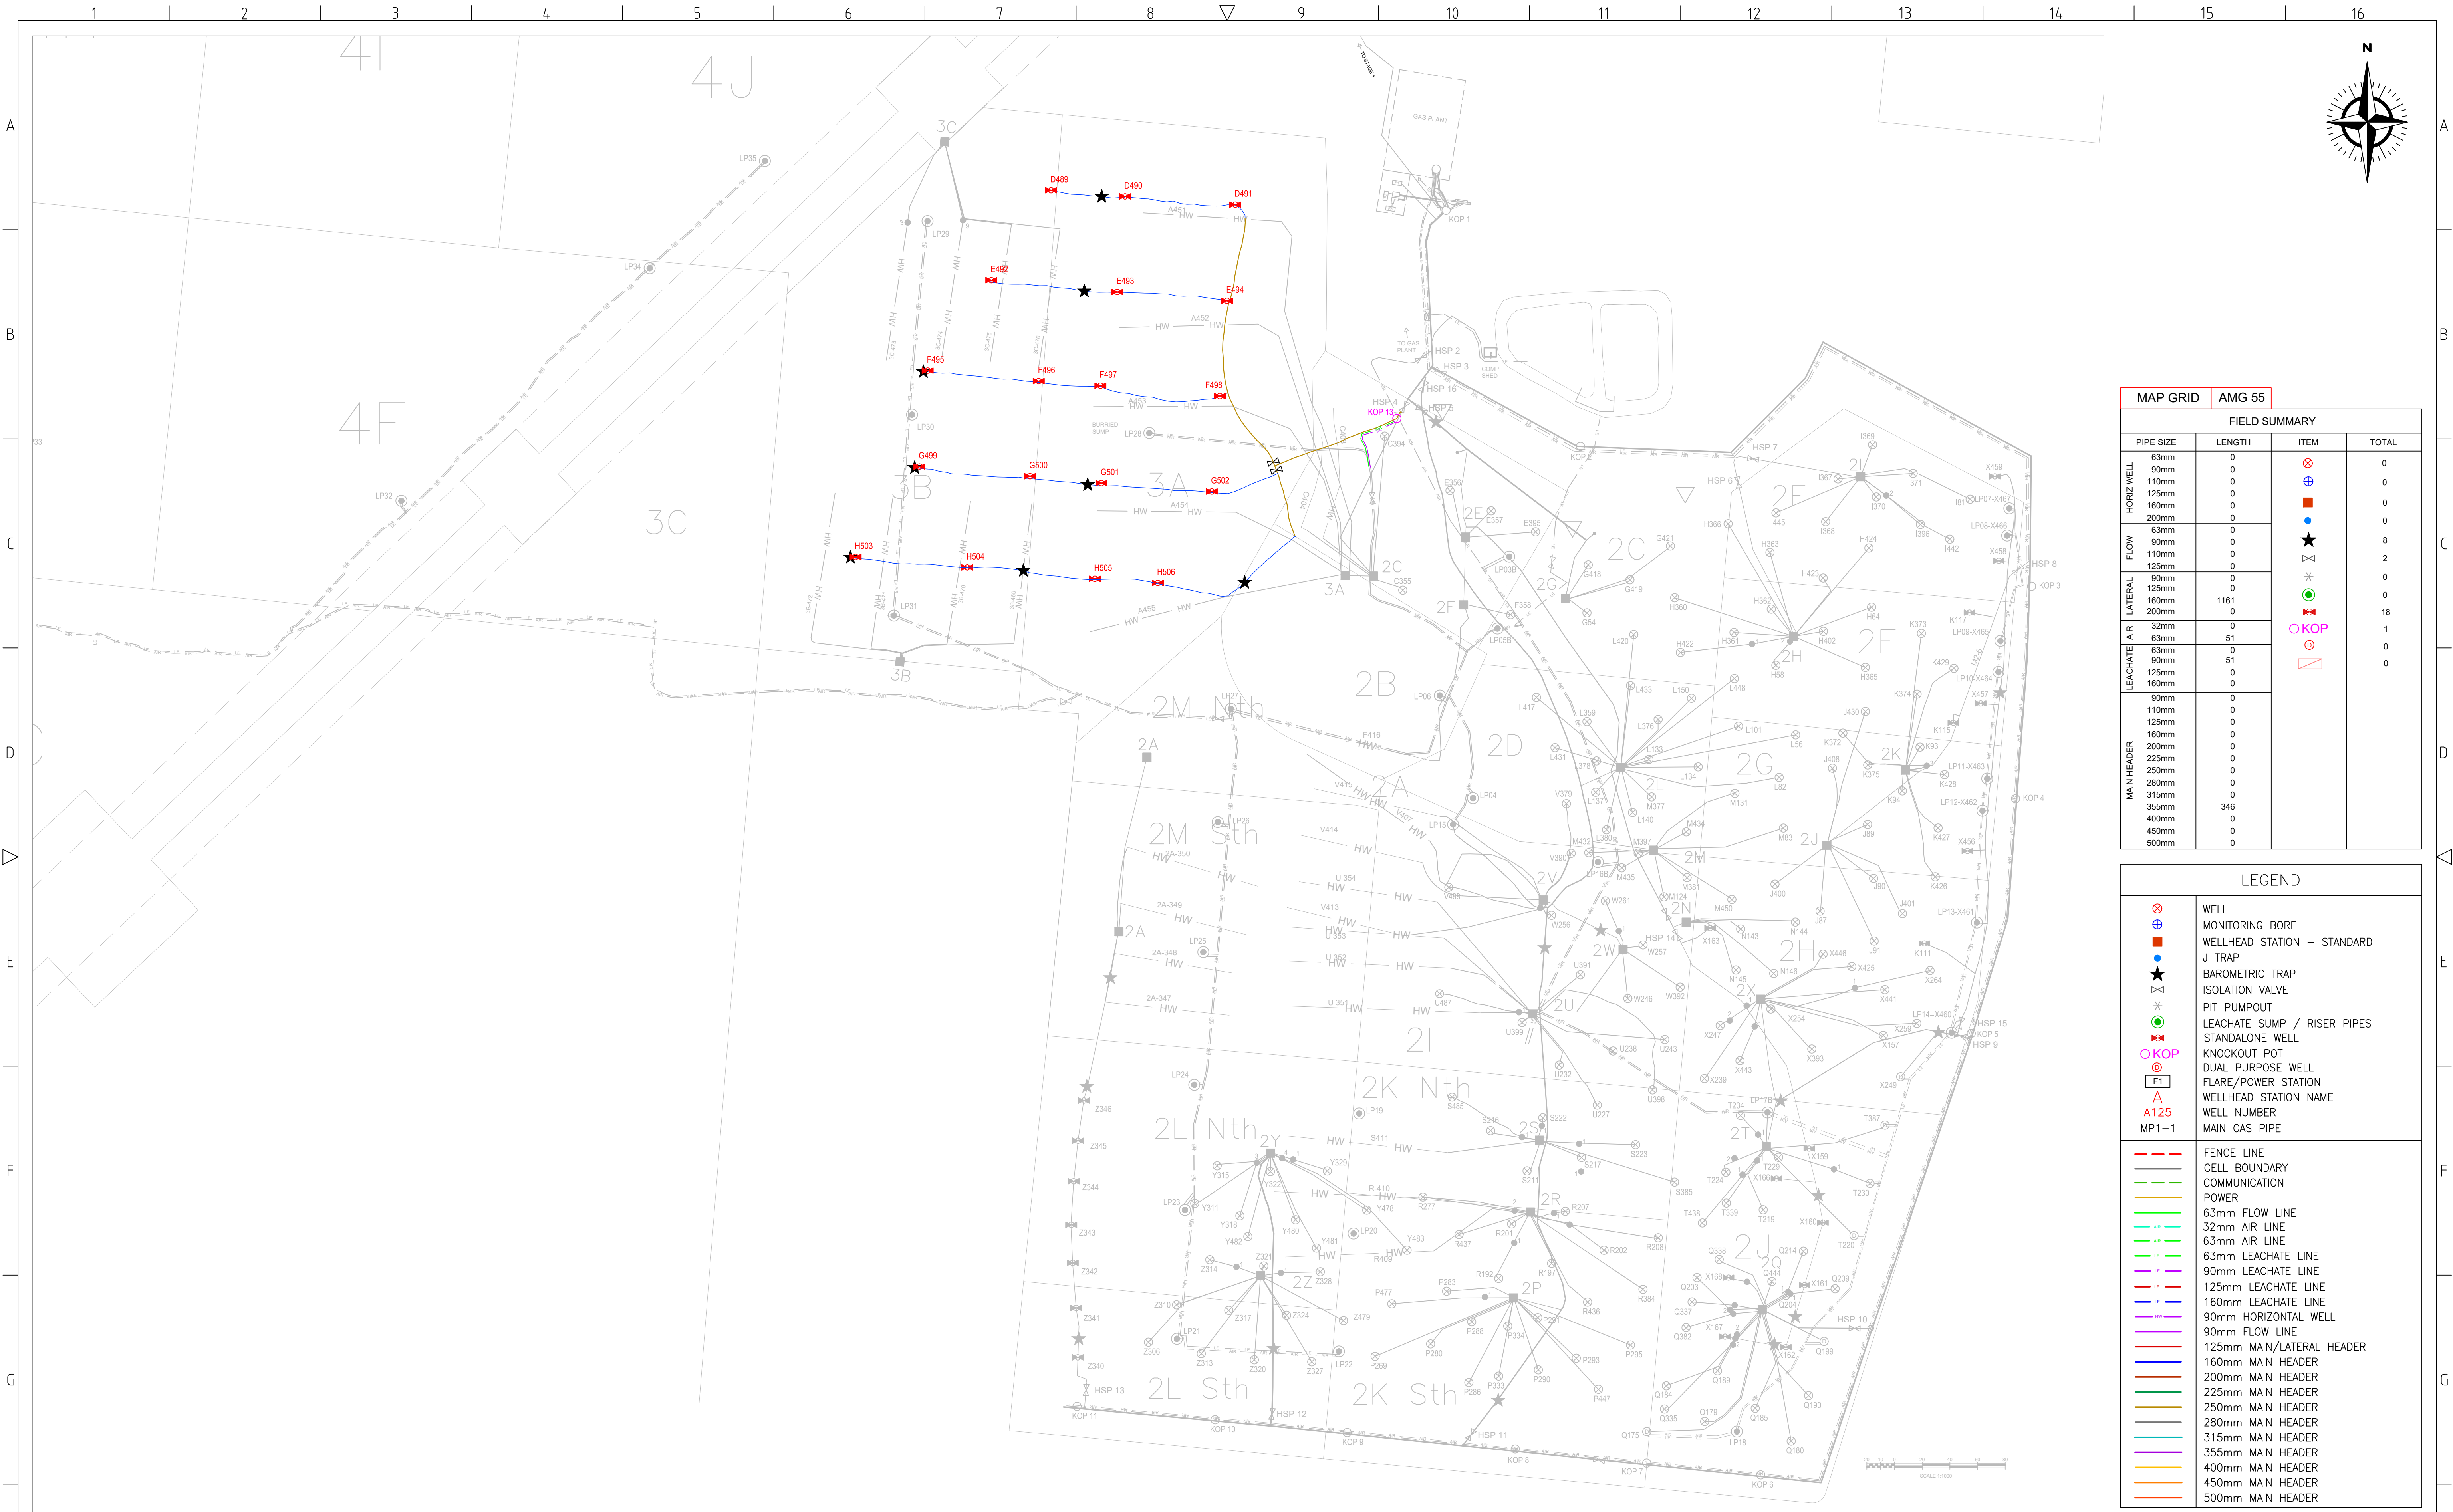

MAP GRID		AMG 55	
FIELD SUMMARY			
PIPE SIZE	LENGTH	ITEM	TOTAL
HORIZ WELL	63mm		0
	90mm		0
	110mm		0
	125mm		0
	160mm		0
FLOW	200mm		0
	63mm		0
	90mm		8
	110mm		2
	125mm		0
LATERAL	160mm		0
	200mm		18
	32mm		1
	63mm		0
	90mm		0
LEACHATE	125mm		0
	160mm		0
	200mm		0
	225mm		0
	250mm		0
MAIN HEADER	280mm		0
	315mm		0
	355mm		346
	400mm		0
	450mm		0
	500mm		0

LEGEND	
	WELL
	MONITORING BORE
	WELLHEAD STATION - STANDARD
	J TRAP
	BAROMETRIC TRAP
	ISOLATION VALVE
	PIT PUMPOUT
	LEACHATE SUMP / RISER PIPES
	STANDALONE WELL
	KNOCKOUT POT
	DUAL PURPOSE WELL
	FLARE/POWER STATION
	WELLHEAD STATION NAME
	WELL NUMBER
	MAIN GAS PIPE
	FENCE LINE
	CELL BOUNDARY
	COMMUNICATION
	POWER
	63mm FLOW LINE
	32mm AIR LINE
	63mm AIR LINE
	63mm LEACHATE LINE
	90mm LEACHATE LINE
	125mm LEACHATE LINE
	160mm LEACHATE LINE
	90mm HORIZONTAL WELL
	90mm FLOW LINE
	125mm MAIN/LATERAL HEADER
	160mm MAIN HEADER
	200mm MAIN HEADER
	225mm MAIN HEADER
	250mm MAIN HEADER
	280mm MAIN HEADER
	315mm MAIN HEADER
	355mm MAIN HEADER
	400mm MAIN HEADER
	450mm MAIN HEADER
	500mm MAIN HEADER

Z						U	4 A CELL DESIGN				RC	RC	RC	21.1.2019
Y						S	AUGUST FLOWLINE REPLACEMENT				BC	LB	LB	21.8.2018
X	MRL CELL 3 GCS INSTALLATION	ZB	RB	RB	03.09.2019	R	GAS MAINS UPDATED				BC	LB	LB	21.8.2018
W	LEACHATE AIR EXTENSION AND REDRILLS	ZB	RB	RB	18.07.2019	Q	MRL CELL 3B HORIZONTAL DESIGN				BC	LB	LB	18.7.2018
V	4 HWELLS, 200 MAIN 1 KOP	KCK	RB	RB	25.1.2018	P	MRL FLOWLINES ADDED/2L CELL REDRILLS				BC	LB	LB	24.5.2018
REV	DESCRIPTION	BY	CKD	APP	DATE	REV	DESCRIPTION	BY	CKD	APP	DATE			
REVISION HISTORY						REVISION HISTORY								

199C OSBORNE AVE, CLAYTON STH, VIC 3169
PH: (03) 9538 6200
www.runenergy.com

PROJECT:	MELBOURNE REGIONAL LANDFILL
DRAWING TITLE:	CELL 3 GCS INSTALLATION

DRAWING No:		MRL-GCS-003	
DRAWING TYPE:			
AS BUILT			
DRAWN:		CKD:	
ZB		RB	
DATE:		APP:	
03.09.2019		RB	
DESIGNED:		APP DATE:	
RB		03.09.2019	
SCALE:	SHEET:	REV:	SIZE:
DNS	1	X	A1