


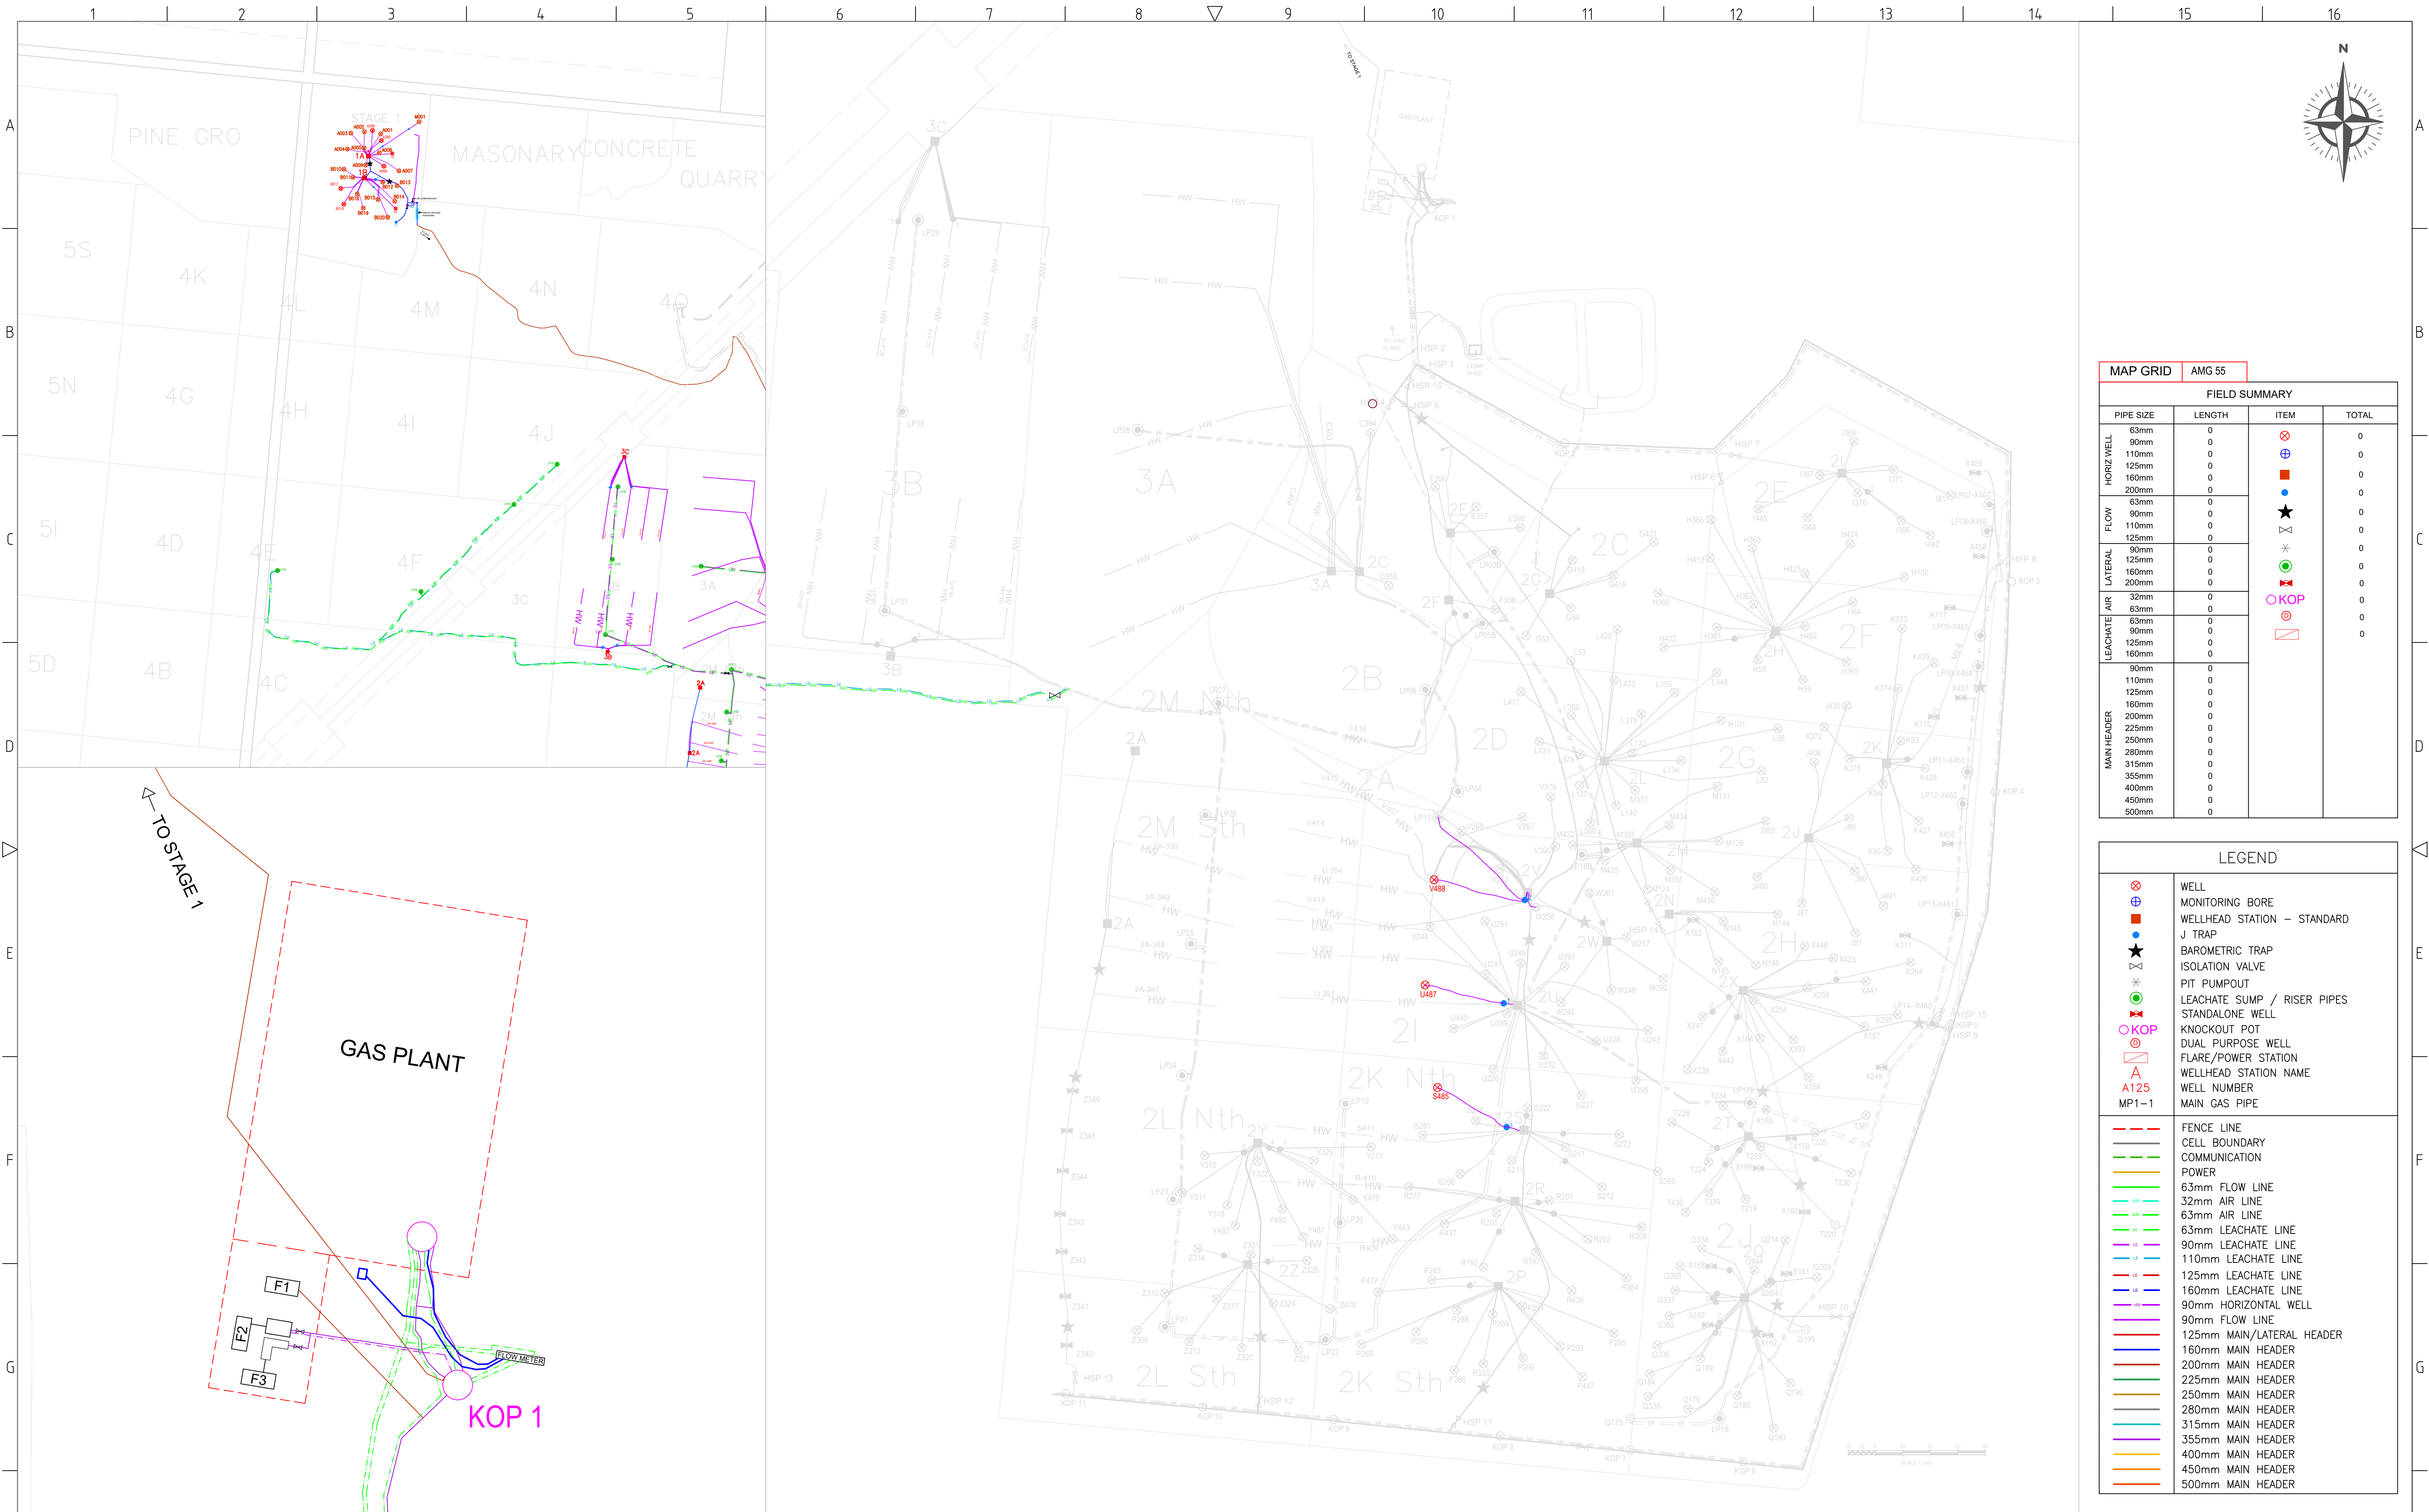

MAP GRID		AMG 55		
FIELD SUMMARY				
PIPE SIZE		LENGTH	ITEM	TOTAL
HORIZ WELL	63mm	0	⊗	0
	90mm	0	⊕	0
	110mm	0	⊕	0
	125mm	0	■	0
	160mm	0	■	0
FLOW	200mm	0	●	0
	63mm	0	★	0
	90mm	0	★	0
	110mm	0	⌞	0
	125mm	0	✱	0
LATERAL	90mm	0	✱	0
	125mm	0	⊙	0
	160mm	0	⊙	0
	200mm	0	⊙	0
	32mm	0	⊗	0
AIR	63mm	0	⊗	0
	90mm	0	⊗	0
LEACHATE	125mm	0	⊗	0
	160mm	0	⊗	0
	90mm	0	⊗	0
	110mm	0	⊗	0
	125mm	0	⊗	0
MAIN HEADER	200mm	0	⊗	0
	225mm	0	⊗	0
	250mm	0	⊗	0
	280mm	0	⊗	0
	315mm	0	⊗	0
	355mm	0	⊗	0
	400mm	0	⊗	0
	450mm	0	⊗	0
	500mm	0	⊗	0

LEGEND	
⊗	WELL
⊕	MONITORING BORE
■	WELLHEAD STATION - STANDARD
●	J TRAP
★	BAROMETRIC TRAP
⊗	ISOLATION VALVE
★	PIT PUMPOUT
●	LEACHATE SUMP / RISER PIPES
○	STANDALONE WELL
○	KNOCKOUT POT
○	DUAL PURPOSE WELL
○	FLARE/POWER STATION
A	WELLHEAD STATION NAME
A125	WELL NUMBER
MP1-1	MAIN GAS PIPE
---	FENCE LINE
---	CELL BOUNDARY
---	COMMUNICATION
---	POWER
---	63mm FLOW LINE
---	32mm AIR LINE
---	63mm AIR LINE
---	63mm LEACHATE LINE
---	90mm LEACHATE LINE
---	110mm LEACHATE LINE
---	125mm LEACHATE LINE
---	160mm LEACHATE LINE
---	90mm HORIZONTAL WELL
---	90mm FLOW LINE
---	125mm MAIN/LATERAL HEADER
---	160mm MAIN HEADER
---	200mm MAIN HEADER
---	225mm MAIN HEADER
---	250mm MAIN HEADER
---	280mm MAIN HEADER
---	315mm MAIN HEADER
---	355mm MAIN HEADER
---	400mm MAIN HEADER
---	450mm MAIN HEADER
---	500mm MAIN HEADER

H						T	CELL 3 PRELIMINARY DESIGN			ZB	RB	RB	30.5.2019		PROJECT: MELBOURNE REGIONAL LANDFILL		DRAWING No: MRL-GCS-001												
						S	AUGUST FLOWLINE REPLACEMENT			BC	LB	LB	21.8.2018				DRAWING TYPE: AS BUILT												
						R	GAS MAINS UPDATED			BC	LB	LB	21.8.2018		DRAWING TITLE: MRL_GCS GAS COLLECTION SYSTEM		DRAWN: BC		CKD: LH										
						Q	MRL CELL 3B HORIZONTAL DESIGN			BC	LB	LB	18.7.2018				DATE: 10.5.2017		APP: AD										
	U	AS BUILT - LEACHATE / AIR EXENSION AND REDRILLS				ZB	RB	RB	18.07.2019	P	MRL FLOWLINES ADDED/2L CELL REDRILLS						BC	LB	LB	24.5.2018	DESIGNED: AD		APP DATE: 10.5.2017						
	REV	DESCRIPTION				BY	CKD	APP	DATE	REV	DESCRIPTION						BY	CKD	APP	DATE	SCALE: DNS		SHEET: 1		REV: U		SIZE: A1		
REVISION HISTORY										REVISION HISTORY										199C OSBORNE AVE, CLAYTON STH, VIC 3169 PH: (03) 9538 6200 www.runenergy.com		13		14		15		16	
1	2	3	4	5	6	7	8	9	10	11	12																		