


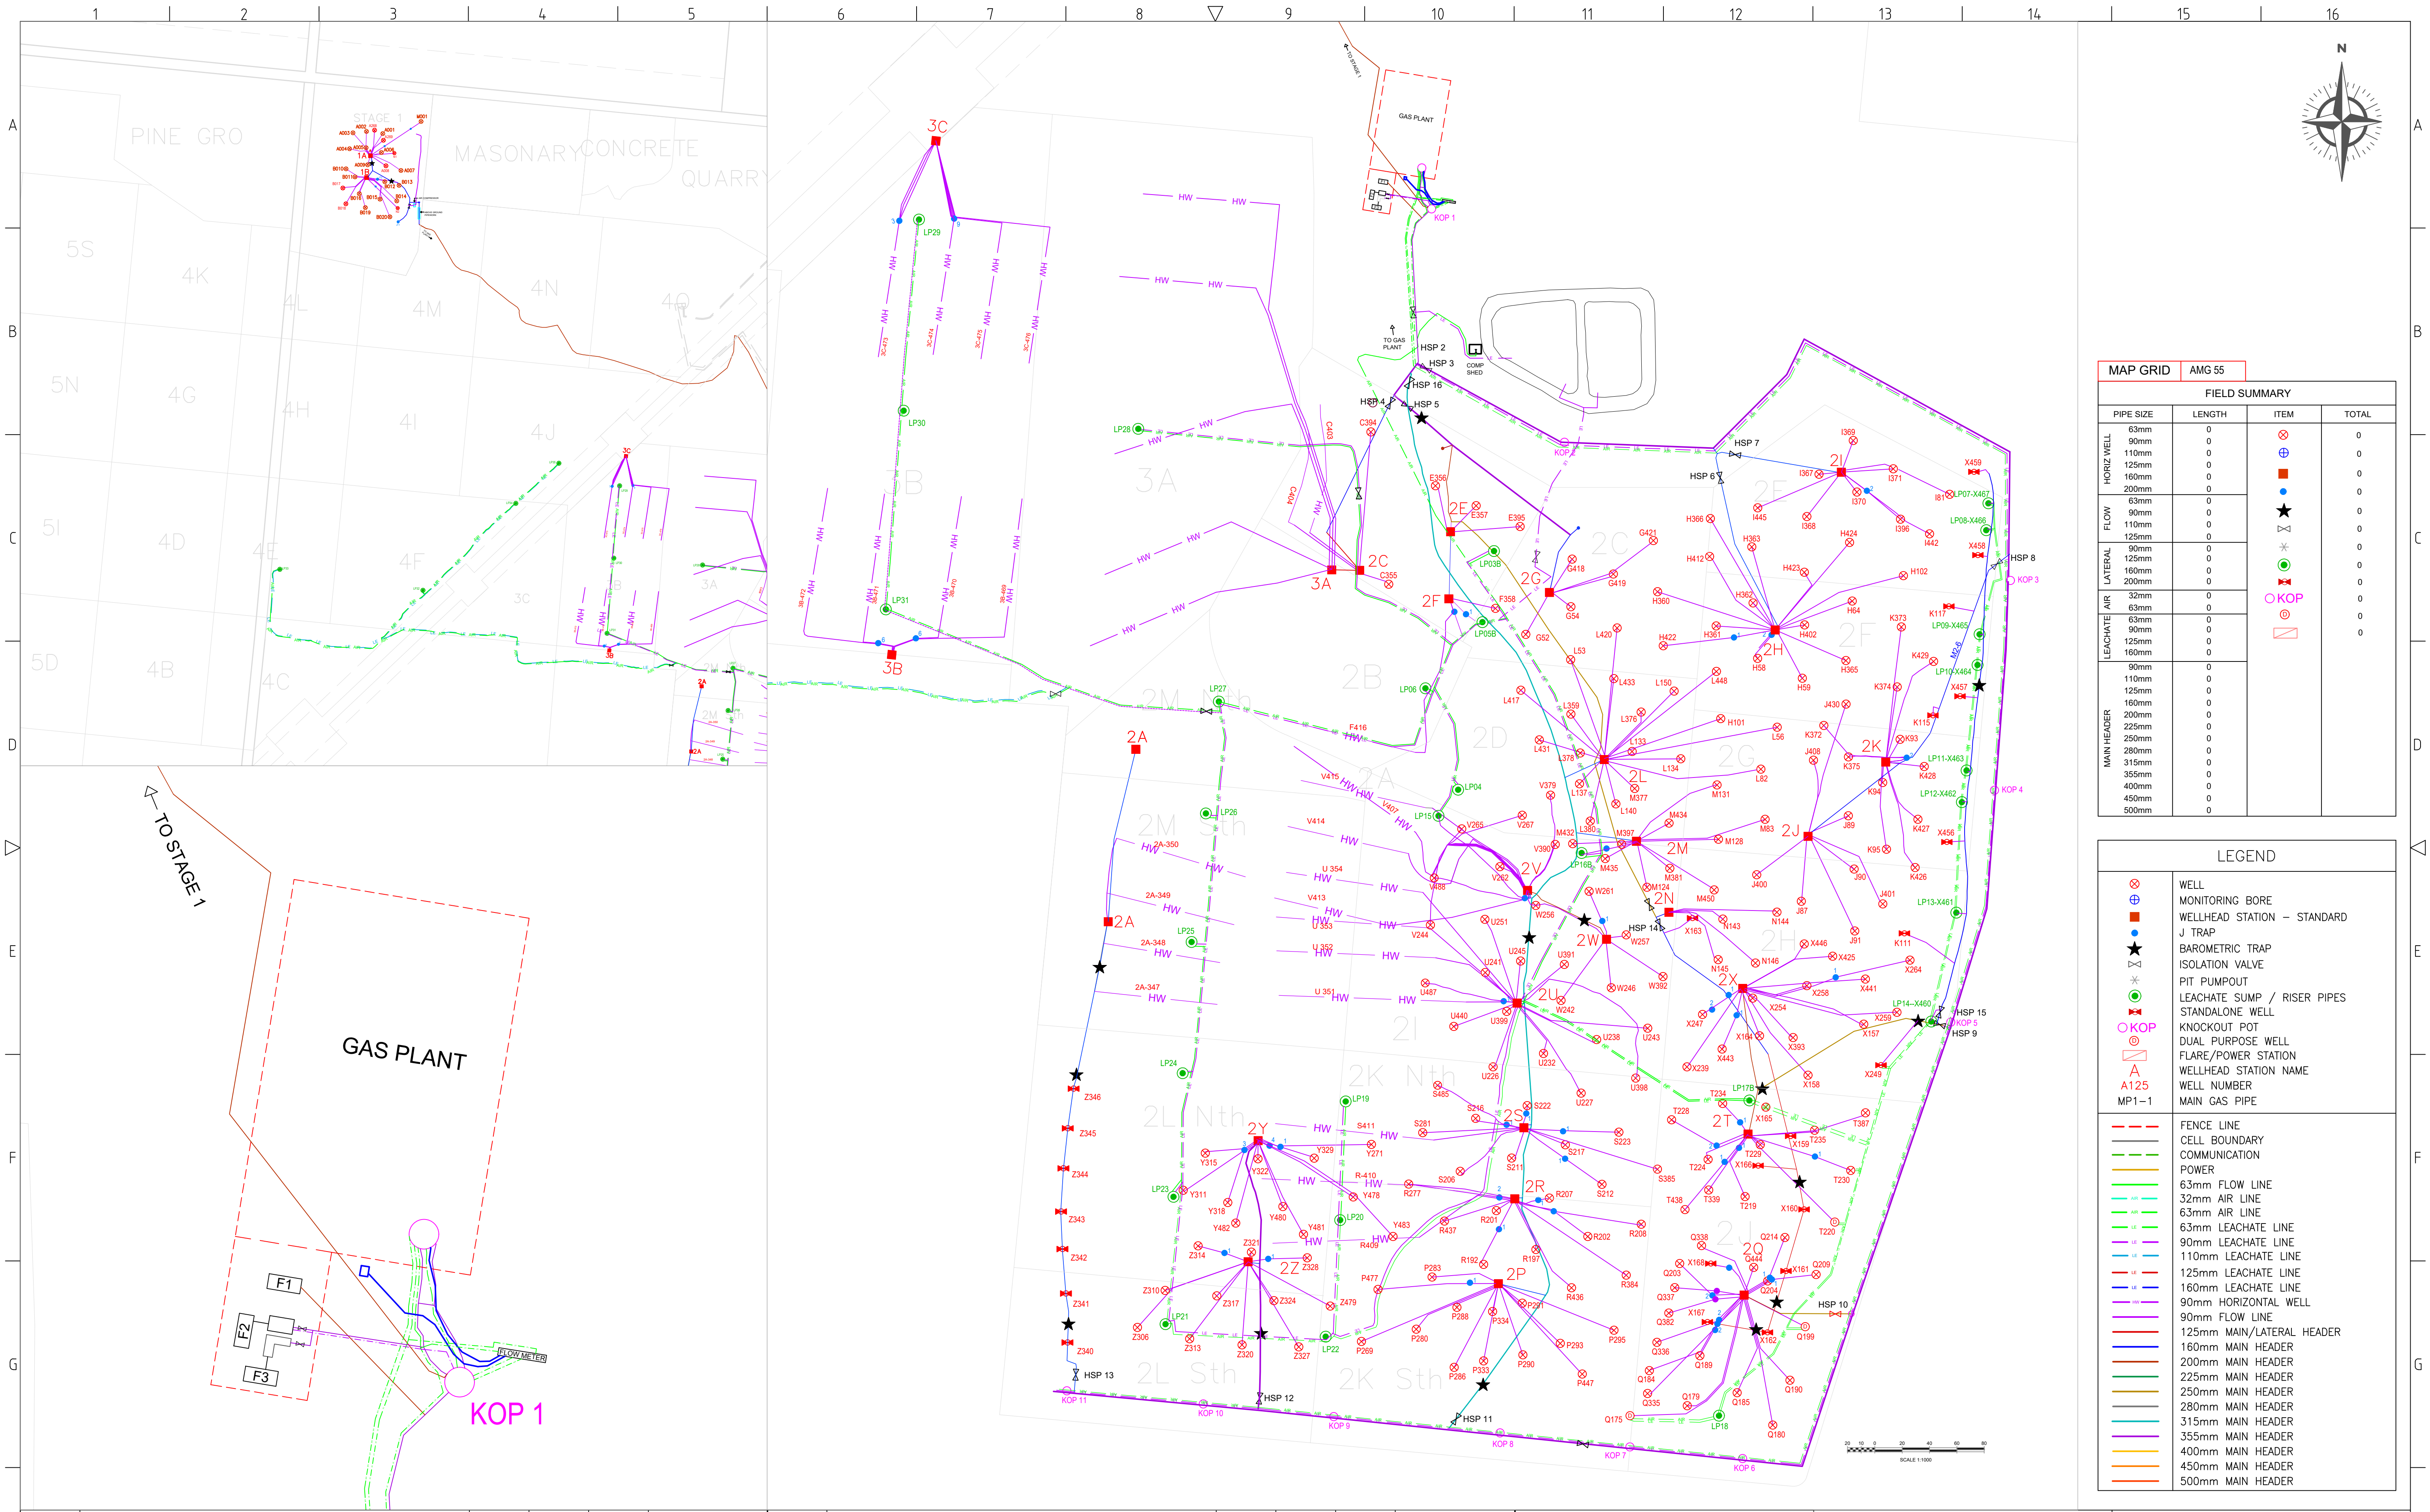

MAP GRID		AMG 55	
FIELD SUMMARY			
PIPE SIZE	LENGTH	ITEM	TOTAL
HORIZ WEL	63mm	⊗	0
	90mm	⊕	0
	110mm	⊗	0
	125mm	⊗	0
	160mm	⊗	0
FLOW	200mm	●	0
	63mm	★	0
	90mm	⊗	0
	110mm	⊗	0
LATERAL	125mm	⊗	0
	90mm	⊗	0
	125mm	⊗	0
	160mm	⊗	0
AIR	200mm	⊗	0
	32mm	⊗	0
	63mm	⊗	0
	63mm	⊗	0
LEACHATE	90mm	⊗	0
	125mm	⊗	0
	160mm	⊗	0
	90mm	⊗	0
MAIN HEADER	110mm	⊗	0
	125mm	⊗	0
	160mm	⊗	0
	200mm	⊗	0
	225mm	⊗	0
	250mm	⊗	0
	280mm	⊗	0
	315mm	⊗	0
	355mm	⊗	0
	400mm	⊗	0
	450mm	⊗	0
	500mm	⊗	0

LEGEND	
⊗	WELL
⊕	MONITORING BORE
⊗	WELLHEAD STATION - STANDARD
★	J TRAP
⊗	BAROMETRIC TRAP
⊗	ISOLATION VALVE
⊗	PIT PUMPOUT
⊗	LEACHATE SUMP / RISER PIPES
⊗	STANDALONE WELL
⊗	KNOCKOUT POT
⊗	DUAL PURPOSE WELL
⊗	FLARE/POWER STATION
A	WELLHEAD STATION NAME
A125	WELL NUMBER
MP1-1	MAIN GAS PIPE
---	FENCE LINE
---	CELL BOUNDARY
---	COMMUNICATION
---	POWER
---	63mm FLOW LINE
---	32mm AIR LINE
---	63mm AIR LINE
---	63mm LEACHATE LINE
---	90mm LEACHATE LINE
---	110mm LEACHATE LINE
---	125mm LEACHATE LINE
---	160mm LEACHATE LINE
---	90mm HORIZONTAL WELL
---	90mm FLOW LINE
---	125mm MAIN/LATERAL HEADER
---	160mm MAIN HEADER
---	200mm MAIN HEADER
---	225mm MAIN HEADER
---	250mm MAIN HEADER
---	280mm MAIN HEADER
---	315mm MAIN HEADER
---	355mm MAIN HEADER
---	400mm MAIN HEADER
---	450mm MAIN HEADER
---	500mm MAIN HEADER

											PROJECT: MELBOURNE REGIONAL LANDFILL	DRAWING TITLE: MRL_GCS GAS COLLECTION SYSTEM	DRAWING No: MRL-GCS-001											
														DRAWING TYPE: AS BUILT										
															DRAWN: BC	CKD: LH								
																	DATE: 10.5.2017	APP: AD						
																			DESIGNED: AD	APP DATE: 10.5.2017				
																					SCALE: DNS	SHEET: 1	REV: U	SIZE: A1
										199C OSBORNE AVE, CLAYTON STH, VIC 3169 PH: (03) 9538 6200 www.runenergy.com	11	12	13	14										