


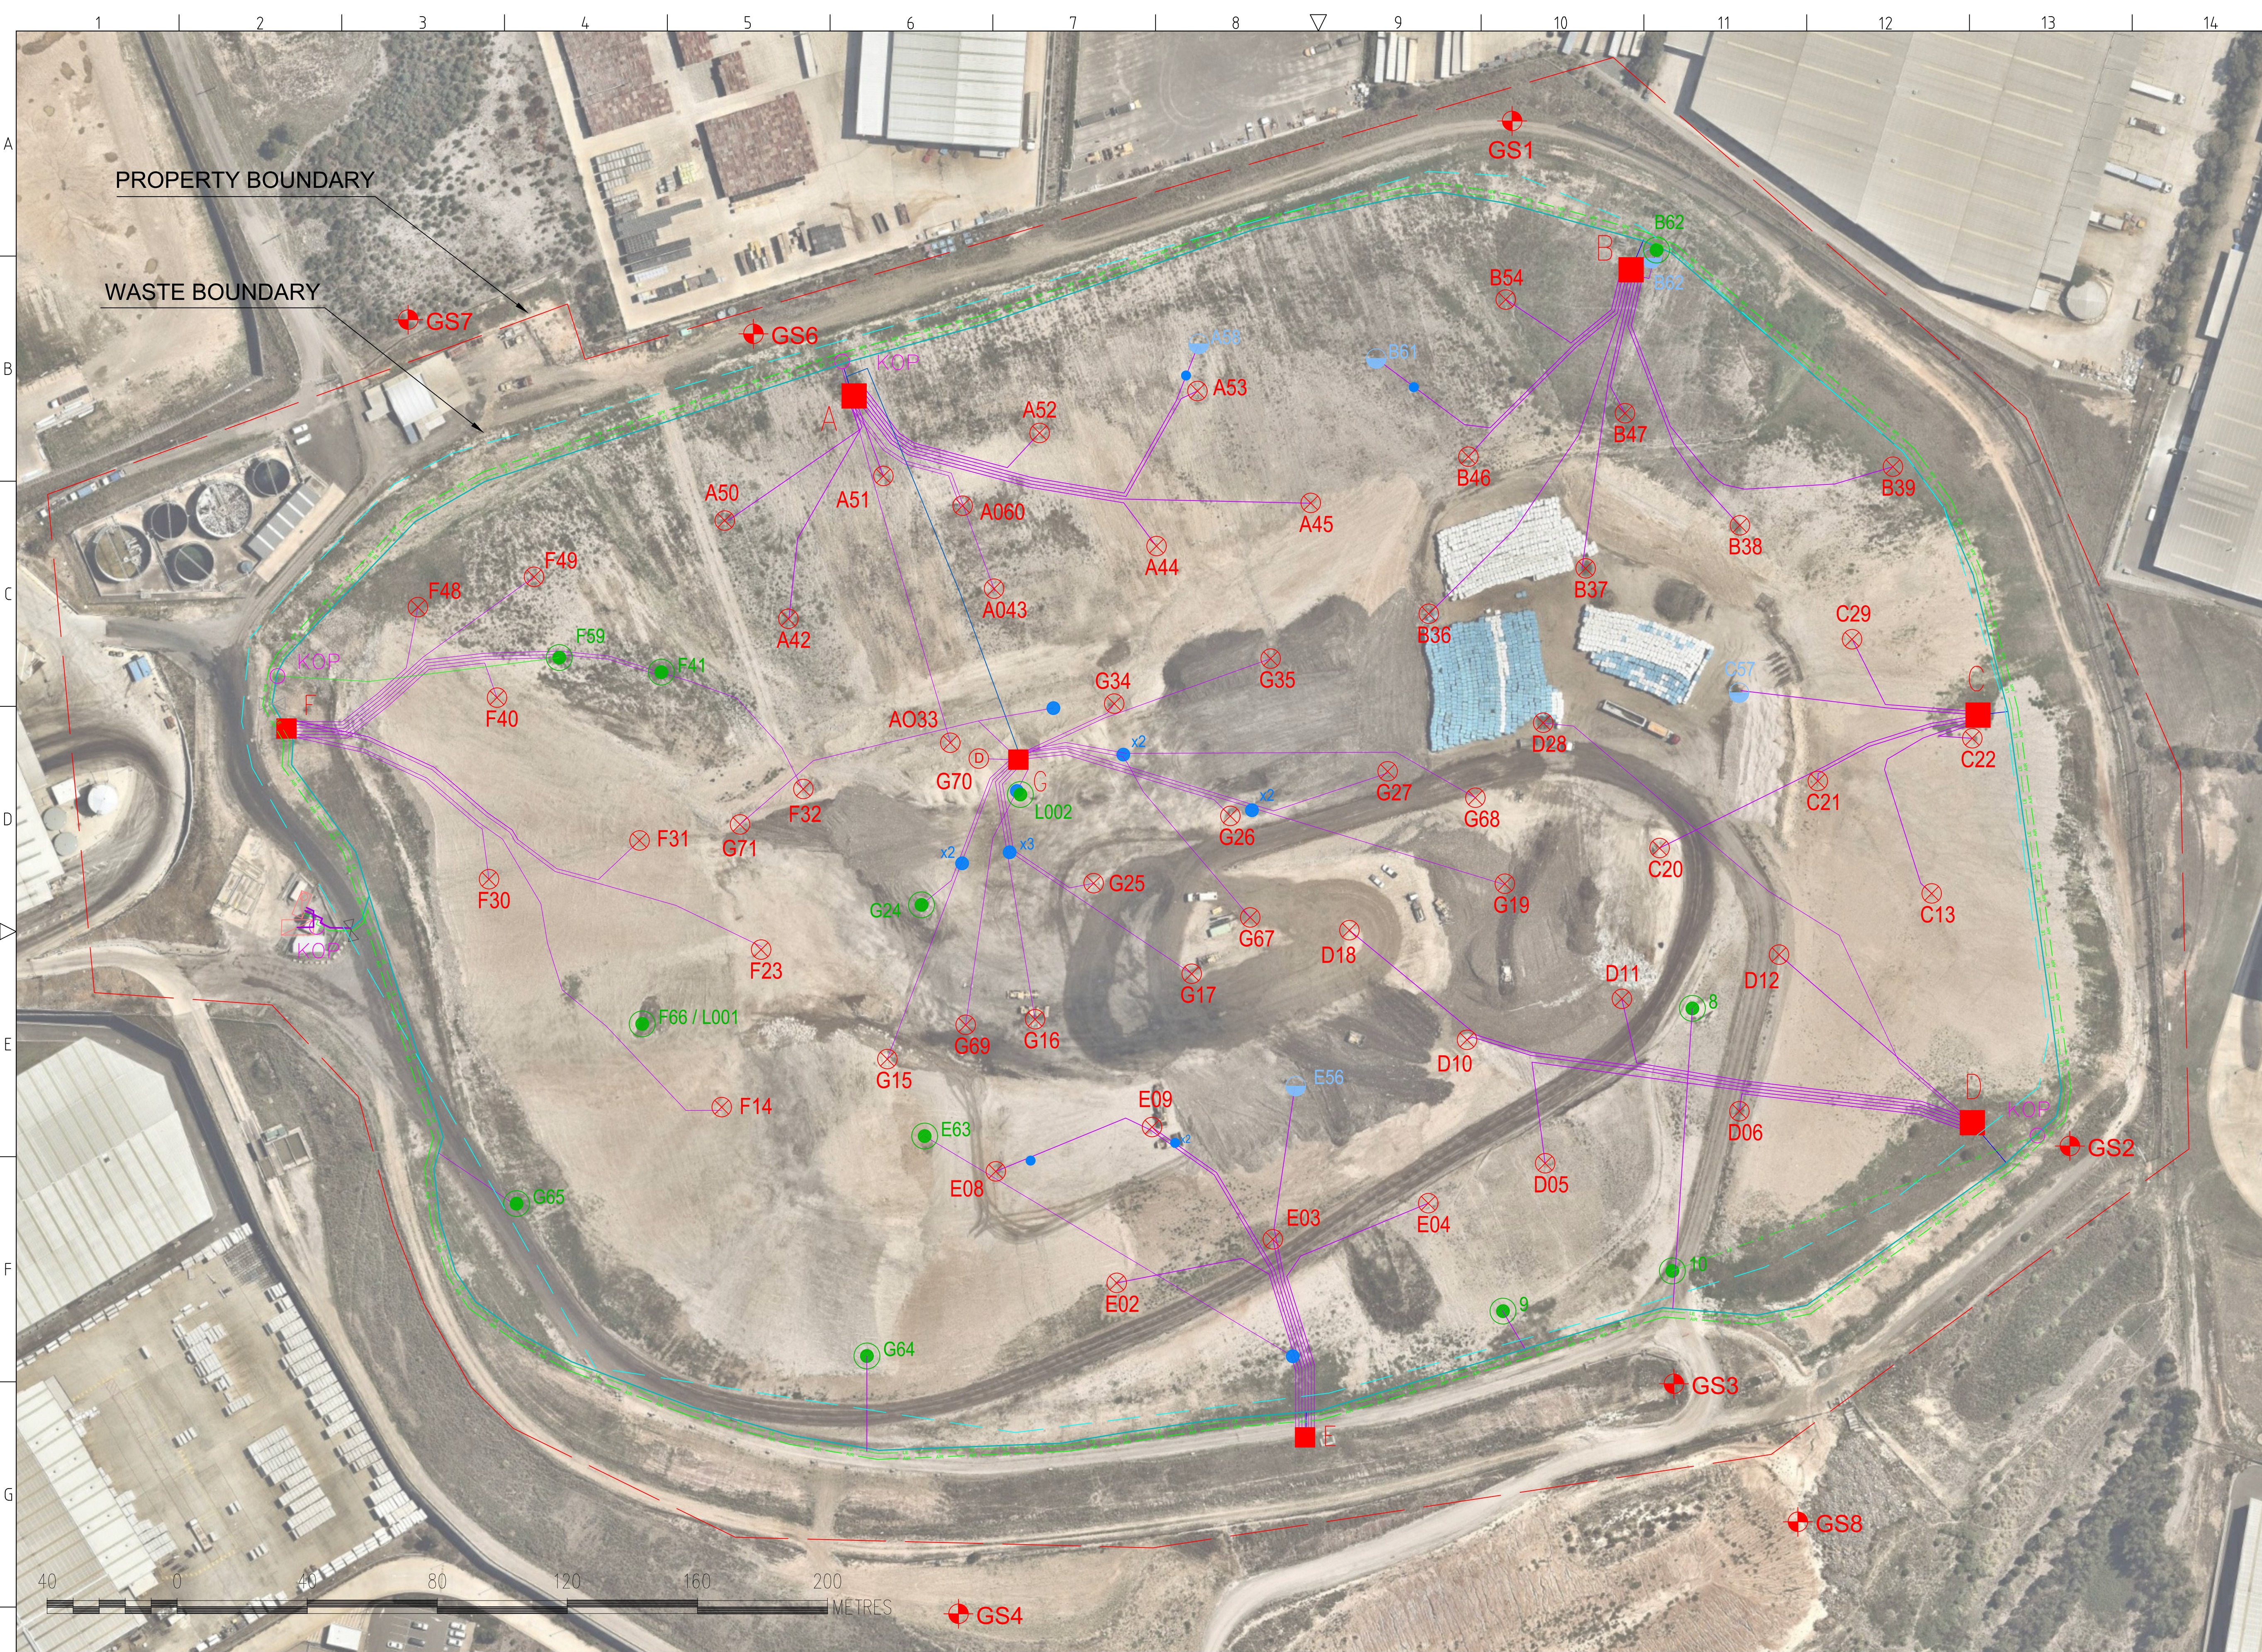

MAP GRID	MGA 56
----------	--------

FIELD SUMMARY			
PIPE SIZE	LENGTH	ITEM	TOTAL
HORIZ WEL			
63mm	0	⊗	0
90mm	0	⊕	0
110mm	0	⊕	0
125mm	0	⊕	0
160mm	0	⊕	0
200mm	0	⊕	0
FLOW			
63mm	0	★	0
90mm	0	★	0
110mm	0	★	0
125mm	0	★	0
LATERAL			
90mm	0	⊗	0
125mm	0	⊗	0
160mm	0	⊗	0
200mm	0	⊗	0
AIR			
32mm	0	⊗	0
63mm	0	⊗	0
LEACHATE			
63mm	0	⊗	0
90mm	0	⊗	0
125mm	0	⊗	0
160mm	0	⊗	0
MAIN HEADER			
90mm	0	⊗	0
110mm	0	⊗	0
125mm	0	⊗	0
160mm	0	⊗	0
200mm	0	⊗	0
225mm	0	⊗	0
250mm	0	⊗	0
280mm	0	⊗	0
315mm	0	⊗	0
355mm	0	⊗	0
400mm	0	⊗	0
450mm	0	⊗	0
500mm	0	⊗	0

LEGEND	
⊗	WELL
⊕	MONITORING BORE
⊕	WELLHEAD STATION - STANDARD
⊕	J TRAP
★	BAROMETRIC TRAP
⊕	ISOLATION VALVE
⊕	PIT PUMPOUT
⊕	LEACHATE SUMP / RISER PIPES
⊕	STANDALONE WELL
⊕	KNOCKOUT POT
⊕	DUAL PURPOSE WELL
⊕	FLARE/POWER STATION
⊕	WELLHEAD STATION NAME
A	WELL NUMBER
A125	MAIN GAS PIPE
MP1-1	GAS MONITORING BORE
⊕	LEACHATE RISER

---	FENCE LINE
---	CELL BOUNDARY
---	COMMUNICATION
---	POWER
---	63mm FLOW LINE
---	32mm AIR LINE
---	63mm AIR LINE
---	63mm LEACHATE LINE
---	90mm LEACHATE LINE
---	125mm LEACHATE LINE
---	160mm LEACHATE LINE
---	90mm HORIZONTAL WELL
---	90mm MAIN LATERAL HEADER
---	125mm MAIN/LATERAL HEADER
---	160mm MAIN HEADER
---	200mm MAIN HEADER
---	225mm MAIN HEADER
---	250mm MAIN HEADER
---	280mm MAIN HEADER
---	315mm MAIN HEADER
---	355mm MAIN HEADER
---	400mm MAIN HEADER
---	450mm MAIN HEADER
---	500mm MAIN HEADER

Aerial photography from Nearmap Pty Ltd taken on 22nd January, 2020.

REV	DESCRIPTION	BY	CKD	APP	DATE
3	UPDATED AERIAL IMAGE	ZB	AD	AD	25.02.2020
2	REVISED ASBUILT	ZB	AD	AD	08.01.2020
1	AS BUILT	BC	LH	LH	20.7.2017
REV	DESCRIPTION	BY	CKD	APP	DATE
REVISION HISTORY					



199C OSBORNE AVE, CLAYTON STH, VIC 3169
PH: (03) 9538 6200
www.runenergy.com

PROJECT:	ERSKINE PARK LANDFILL GAS PROJECT
DRAWING TITLE:	GAS COLLECTION SYSTEM SITE LAYOUT

T	DRAWING No:		RE-ERSKINE-001	
	DRAWING TYPE:			
	AS BUILT			
	DRAWN:		CKD:	
	BC		AD	
DATE:		APP:		
25.02.2020		AD		
DESIGNED:		APP DATE:		
LH		25.02.2020		
SCALE:		SHEET:	REV:	SIZE:
1:1000		1 of 1	A	A1