


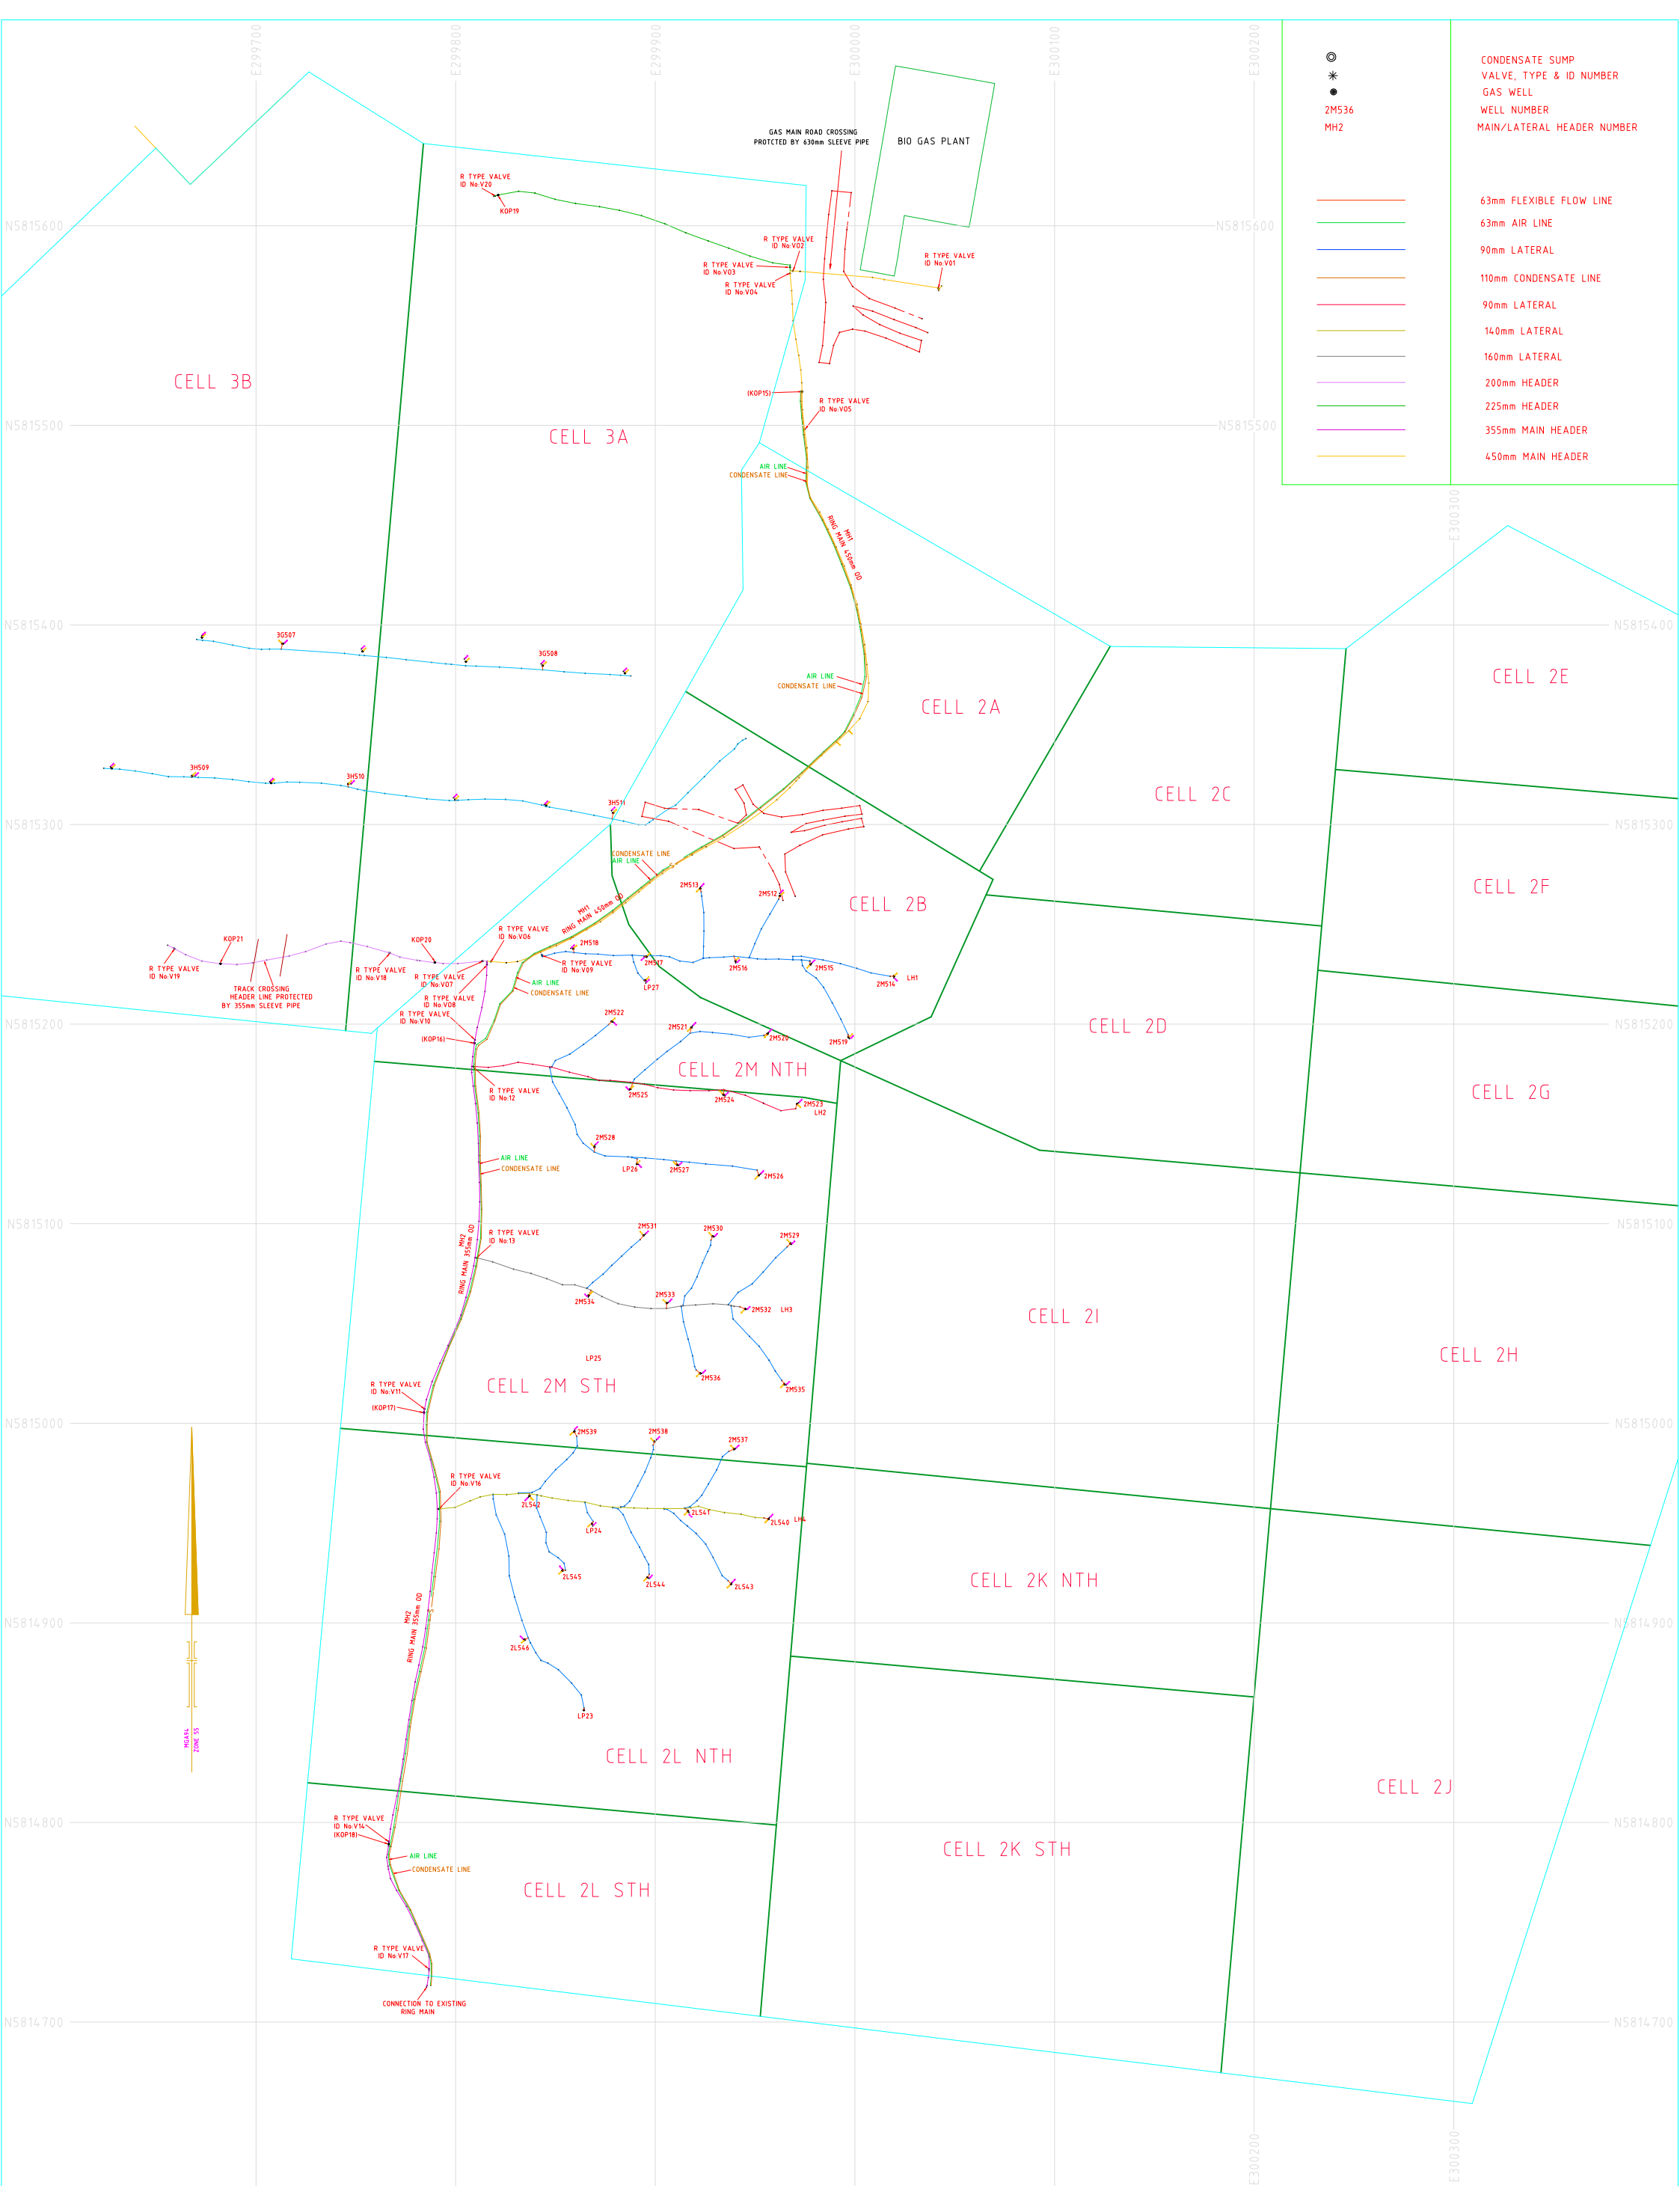

PLAN OF SURVEY

FIG 1
STAGE 2 LFG EXTRACTION SYSTEM AND
STAGES 3A & 3B GAS MAIN WORKS
MELBOURNE REGIONAL LANDFILL
CHRISTIES ROAD, RAVENHALL, 3023

Bearing & Grid Datum:MGA94	Height Datum:AHD
MELWAY REF:358-E12	SCALE 1:1500 @A0
SURVEYOR:AA, FS DRAWN:FS CHECKED	15 0 15 30 45 60 LENGTHS ARE IN METRES

CHARTER.
KECK CRAMER

Level 19/8 Exhibition Street, Melbourne, Victoria 3000
Telephone 03 8102 8888 Facsimile 03 8102 8844

REF No:J042370

DATE OF SURVEY:03-11-19 & 05-12-19
VERSION:2 19/12/19

MRI Resolve Stage 2 As Built Gas Field 13-12-19 Ver 2-dwg