



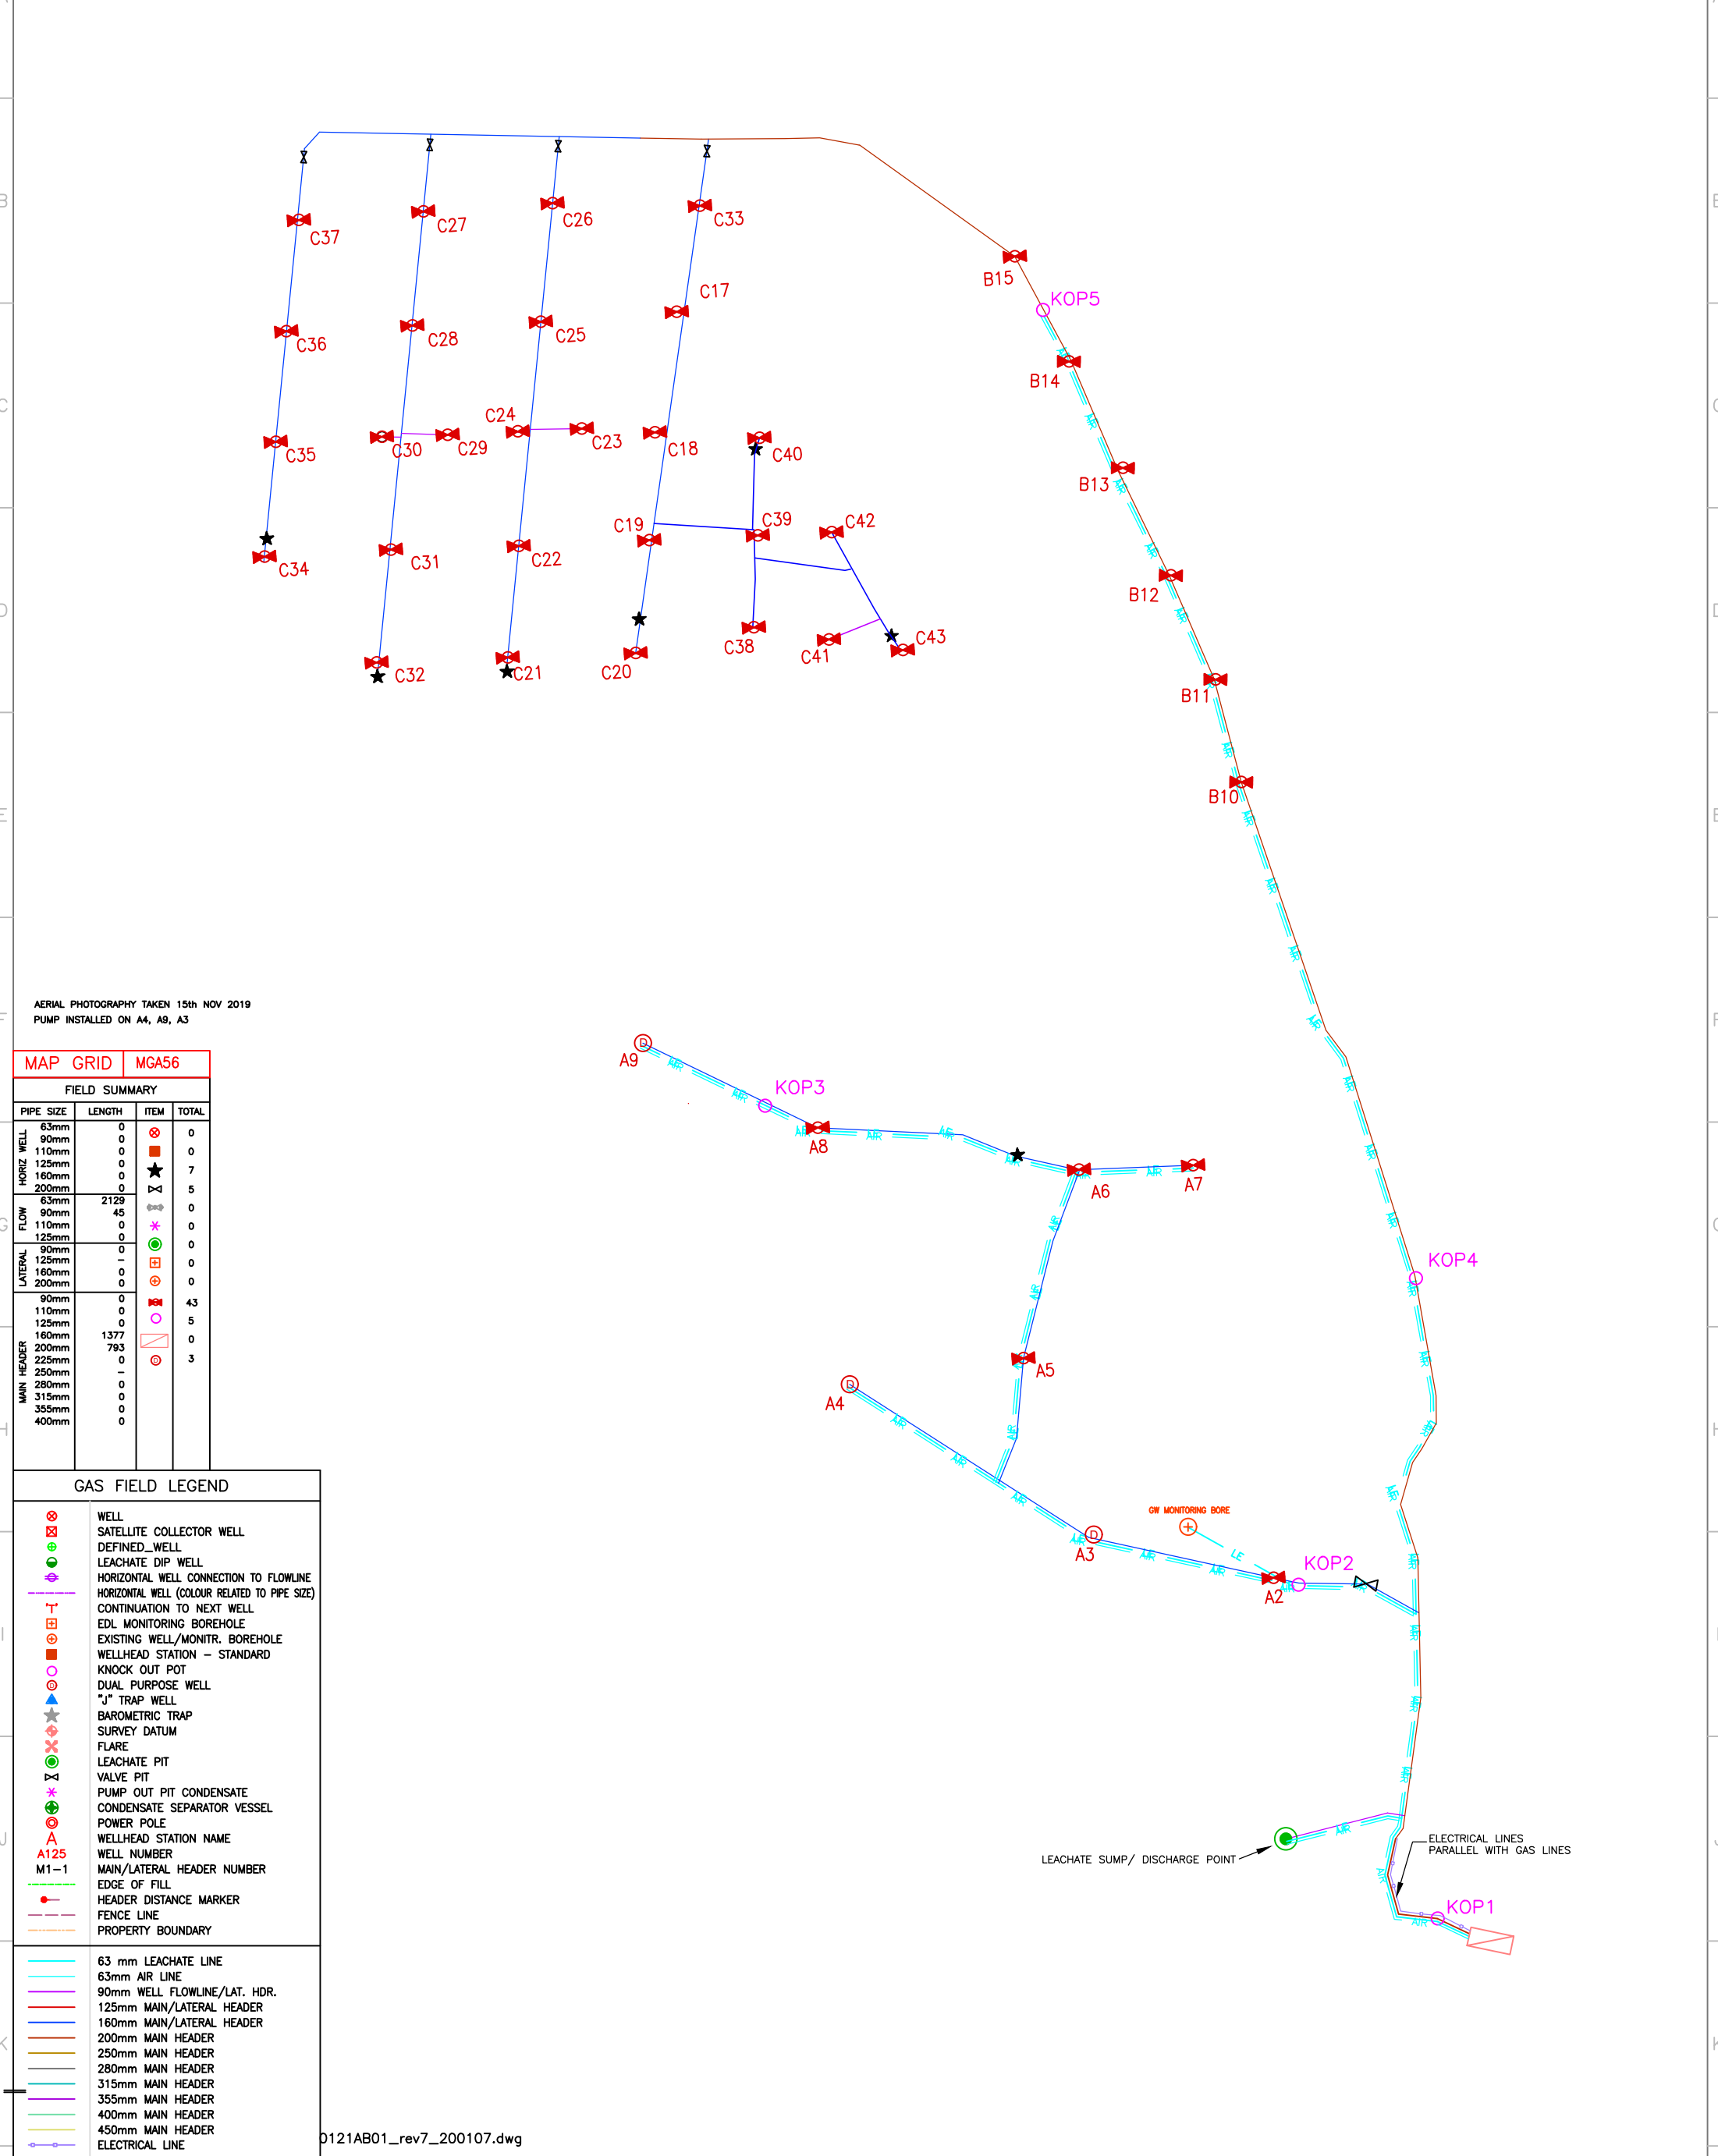

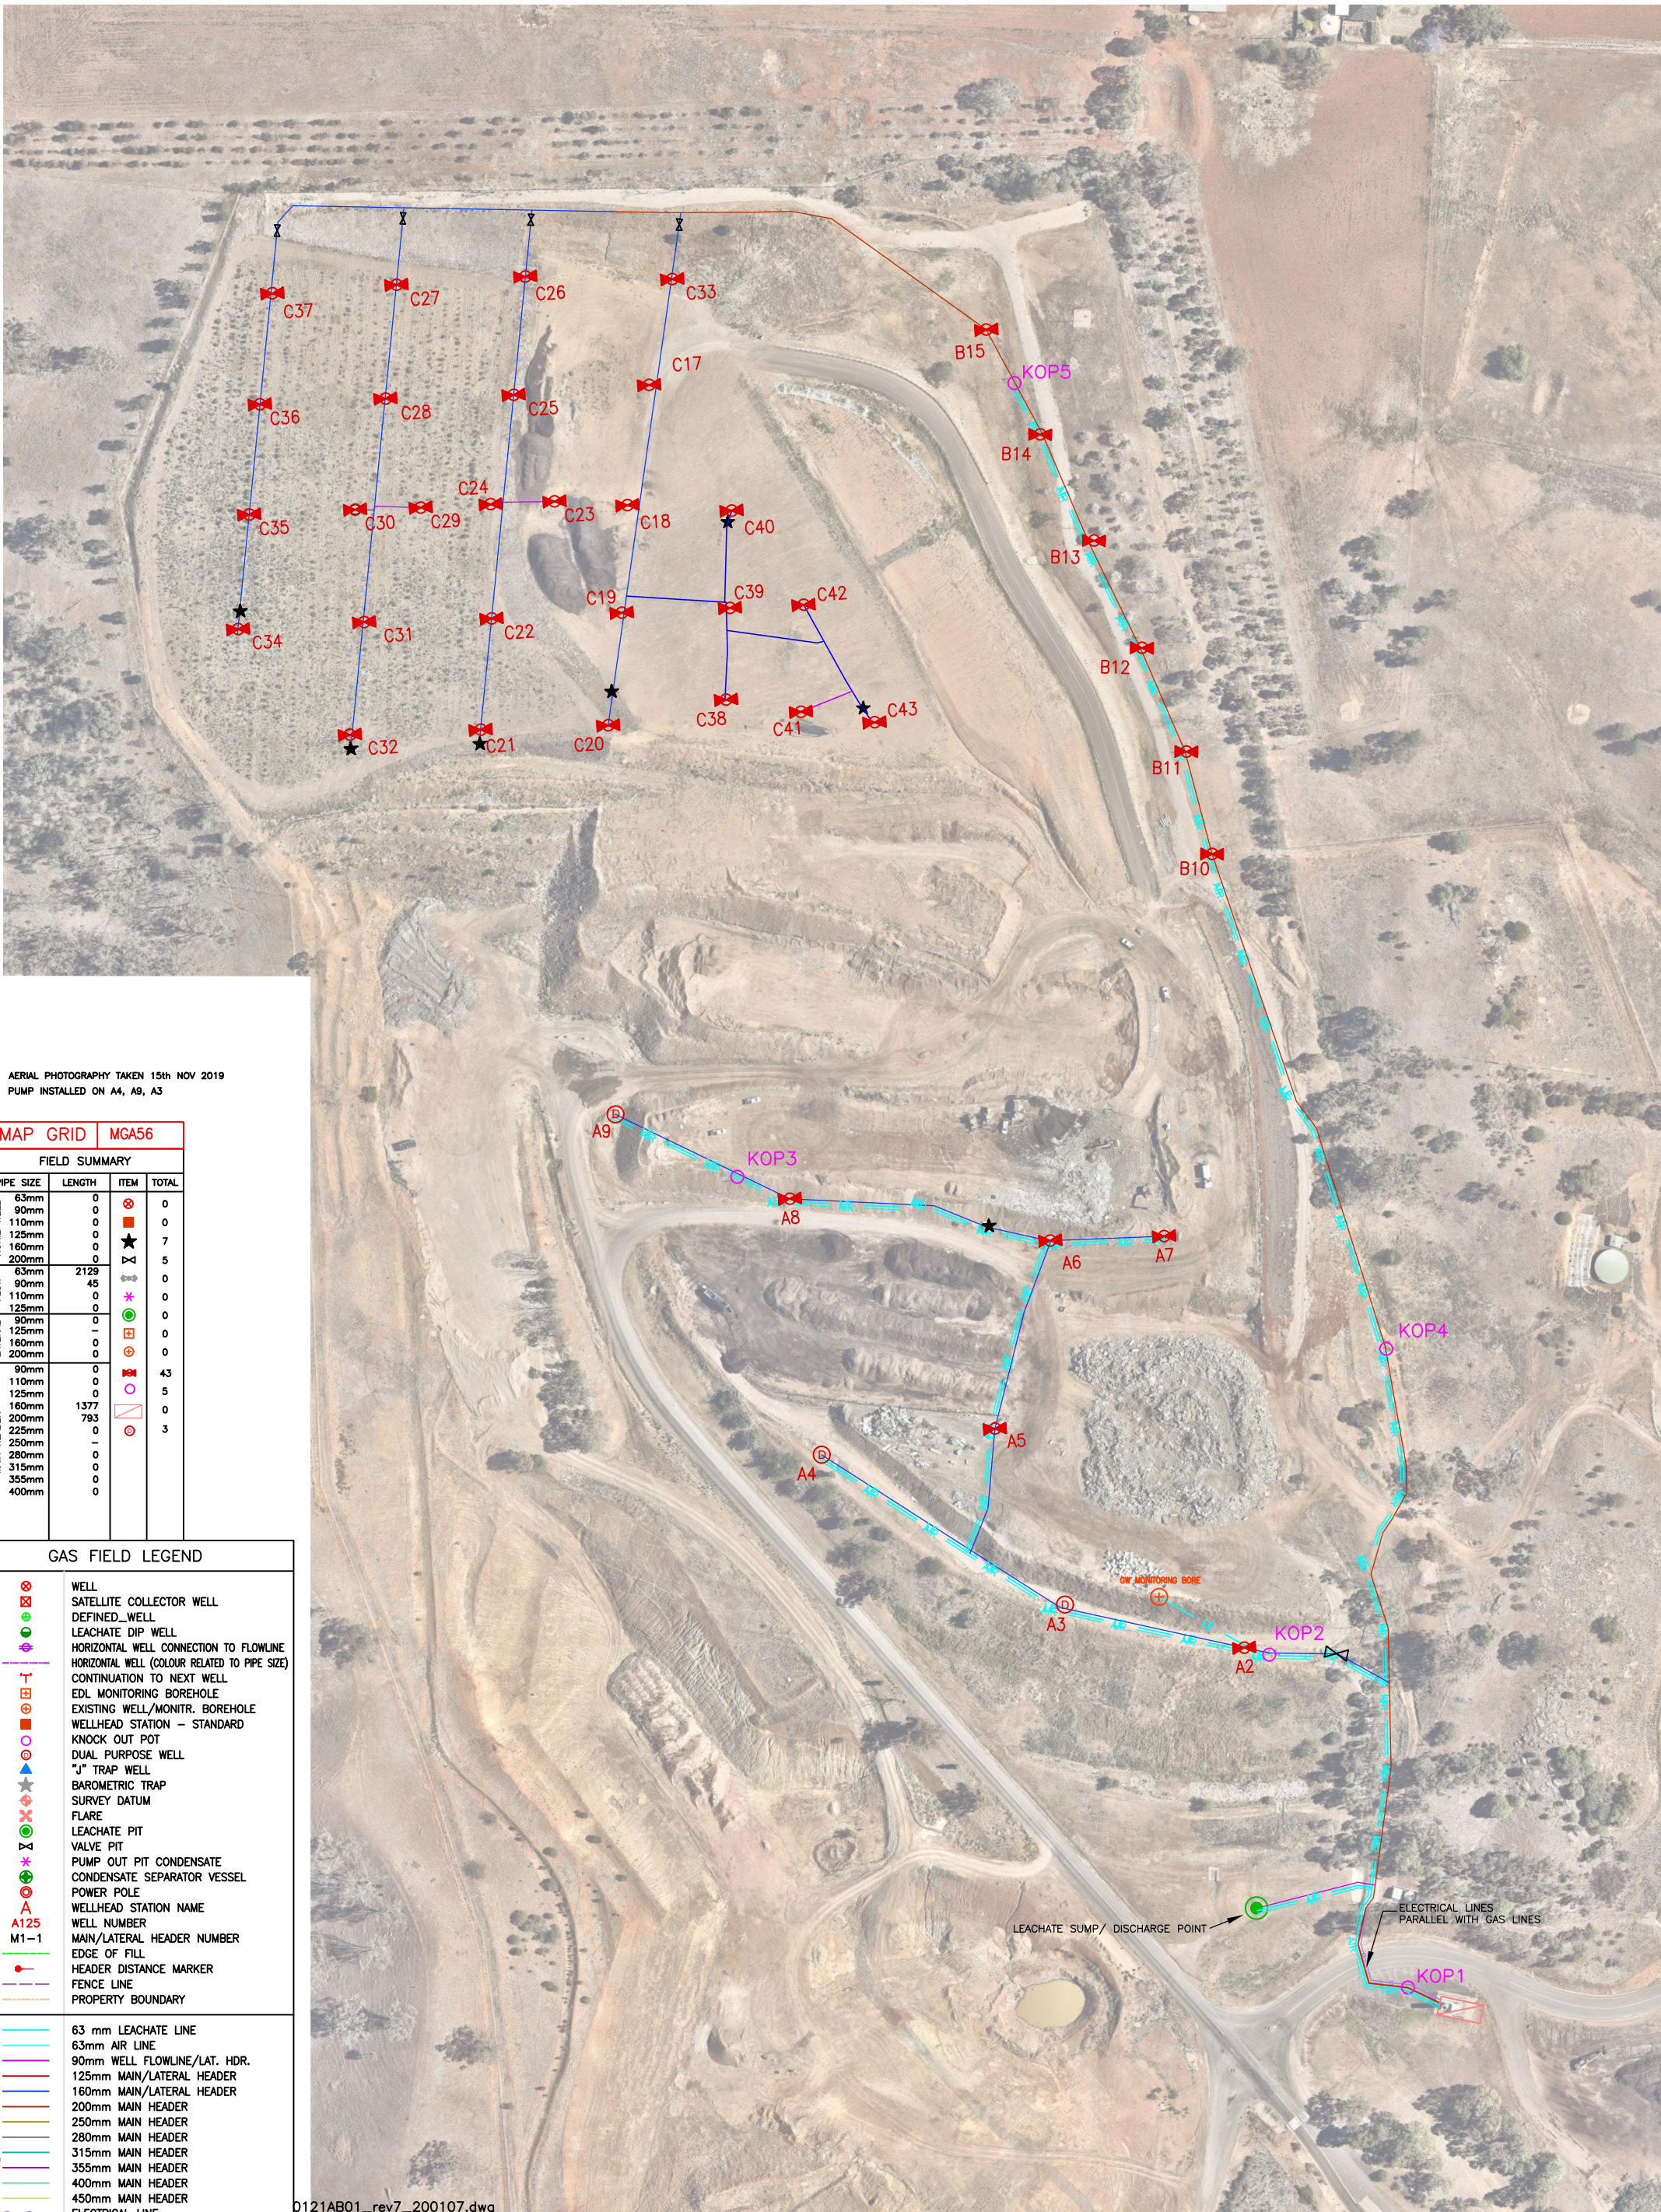

AERIAL PHOTOGRAPHY TAKEN 15th NOV 2019
PUMP INSTALLED ON A4, A9, A3

MAP GRID		MGA56		
FIELD SUMMARY				
PIPE SIZE	LENGTH	ITEM	TOTAL	
HORIZ. WELL	63mm	0	0	
	90mm	0	0	
	110mm	0	0	
	125mm	0	7	
	160mm	0	0	
	200mm	0	5	
FLOW	63mm	2129	0	
	90mm	45	0	
	110mm	0	0	
	125mm	0	0	
LATERAL	90mm	0	0	
	125mm	0	0	
	160mm	0	0	
	200mm	0	0	
	90mm	0	43	
	110mm	0	0	
MAIN HEADER	125mm	0	5	
	160mm	1377	0	
	200mm	793	0	
	225mm	0	3	
	250mm	0	0	
	280mm	0	0	
	315mm	0	0	
	355mm	0	0	
400mm	0	0		

GAS FIELD LEGEND

	WELL
	SATELLITE COLLECTOR WELL
	DEFINED WELL
	LEACHATE DIP WELL
	HORIZONTAL WELL CONNECTION TO FLOWLINE
	HORIZONTAL WELL (COLOUR RELATED TO PIPE SIZE)
	CONTINUATION TO NEXT WELL
	EDL MONITORING BOREHOLE
	EXISTING WELL/MONITR. BOREHOLE
	WELLHEAD STATION - STANDARD
	KNOCK OUT POT
	DUAL PURPOSE WELL
	"J" TRAP WELL
	BAROMETRIC TRAP
	SURVEY DATUM
	FLARE
	LEACHATE PIT
	VALVE PIT
	PUMP OUT PIT CONDENSATE
	CONDENSATE SEPARATOR VESSEL
	POWER POLE
	WELLHEAD STATION NAME
	WELL NUMBER
	MAIN/LATERAL HEADER NUMBER
	EDGE OF FILL
	HEADER DISTANCE MARKER
	FENCE LINE
	PROPERTY BOUNDARY
	63 mm LEACHATE LINE
	63mm AIR LINE
	90mm WELL FLOWLINE/LAT. HDR.
	125mm MAIN/LATERAL HEADER
	160mm MAIN/LATERAL HEADER
	200mm MAIN HEADER
	250mm MAIN HEADER
	280mm MAIN HEADER
	315mm MAIN HEADER
	355mm MAIN HEADER
	400mm MAIN HEADER
	450mm MAIN HEADER
	ELECTRICAL LINE

0121AB01_rev7_200107.dwg

THIS DRAWING AND DESIGN CONTAINS PROPRIETARY INFORMATION. IT SHALL NOT BE USED OR REPRODUCED OR ANY OF ITS CONTENTS DISCLOSED IN WHOLE OR PART WITHOUT THE PRIOR WRITTEN CONSENT OF RUN ENERGY					07.01.20
7	ASBUILT UPDATE - ADDED IDS TO KOPS AND WELLS	ZB	AD	AD	09.10.18
F	AS BUILT DATA ADDED	KCK	RC	RC	
E	BARO TRAPS ADDED/MOVED	KK	RB	RB	2.11.17
D	DRAWING UPDATED	KK	RB	RB	9.5.17
C	FIELD SUMMARY UPDATED	KK	RB	RB	1.5.17
B	UPDATED TO SITE SURVEY	KK	RB	RB	24.4.17
A	D.J.P. - ORIGINAL ISSUE				
REV	AMENDMENTS	DRAWN	DESIGNED	CHECKED	APPROVED
1					
2					
3					
4					
5					



PROJECT		TAMWORTH FOREST RD LANDFILL GAS PROJECT			
DRAWING TITLE		GASFIELD COLLECTION SYSTEM AS BUILT			SAVE DATE 1/8/2020
SCALE	DRAWING NUMBER	PAGE	REV	SIZE	
N.T.S.	121-TAMWORTH	2 OF 2	7	A1	
LAST PLOTTED TIME: 1/8/2020 8:58 AM		DATE:		LAST MODIFIED TIME:	
				DATE: 01/01/97	