


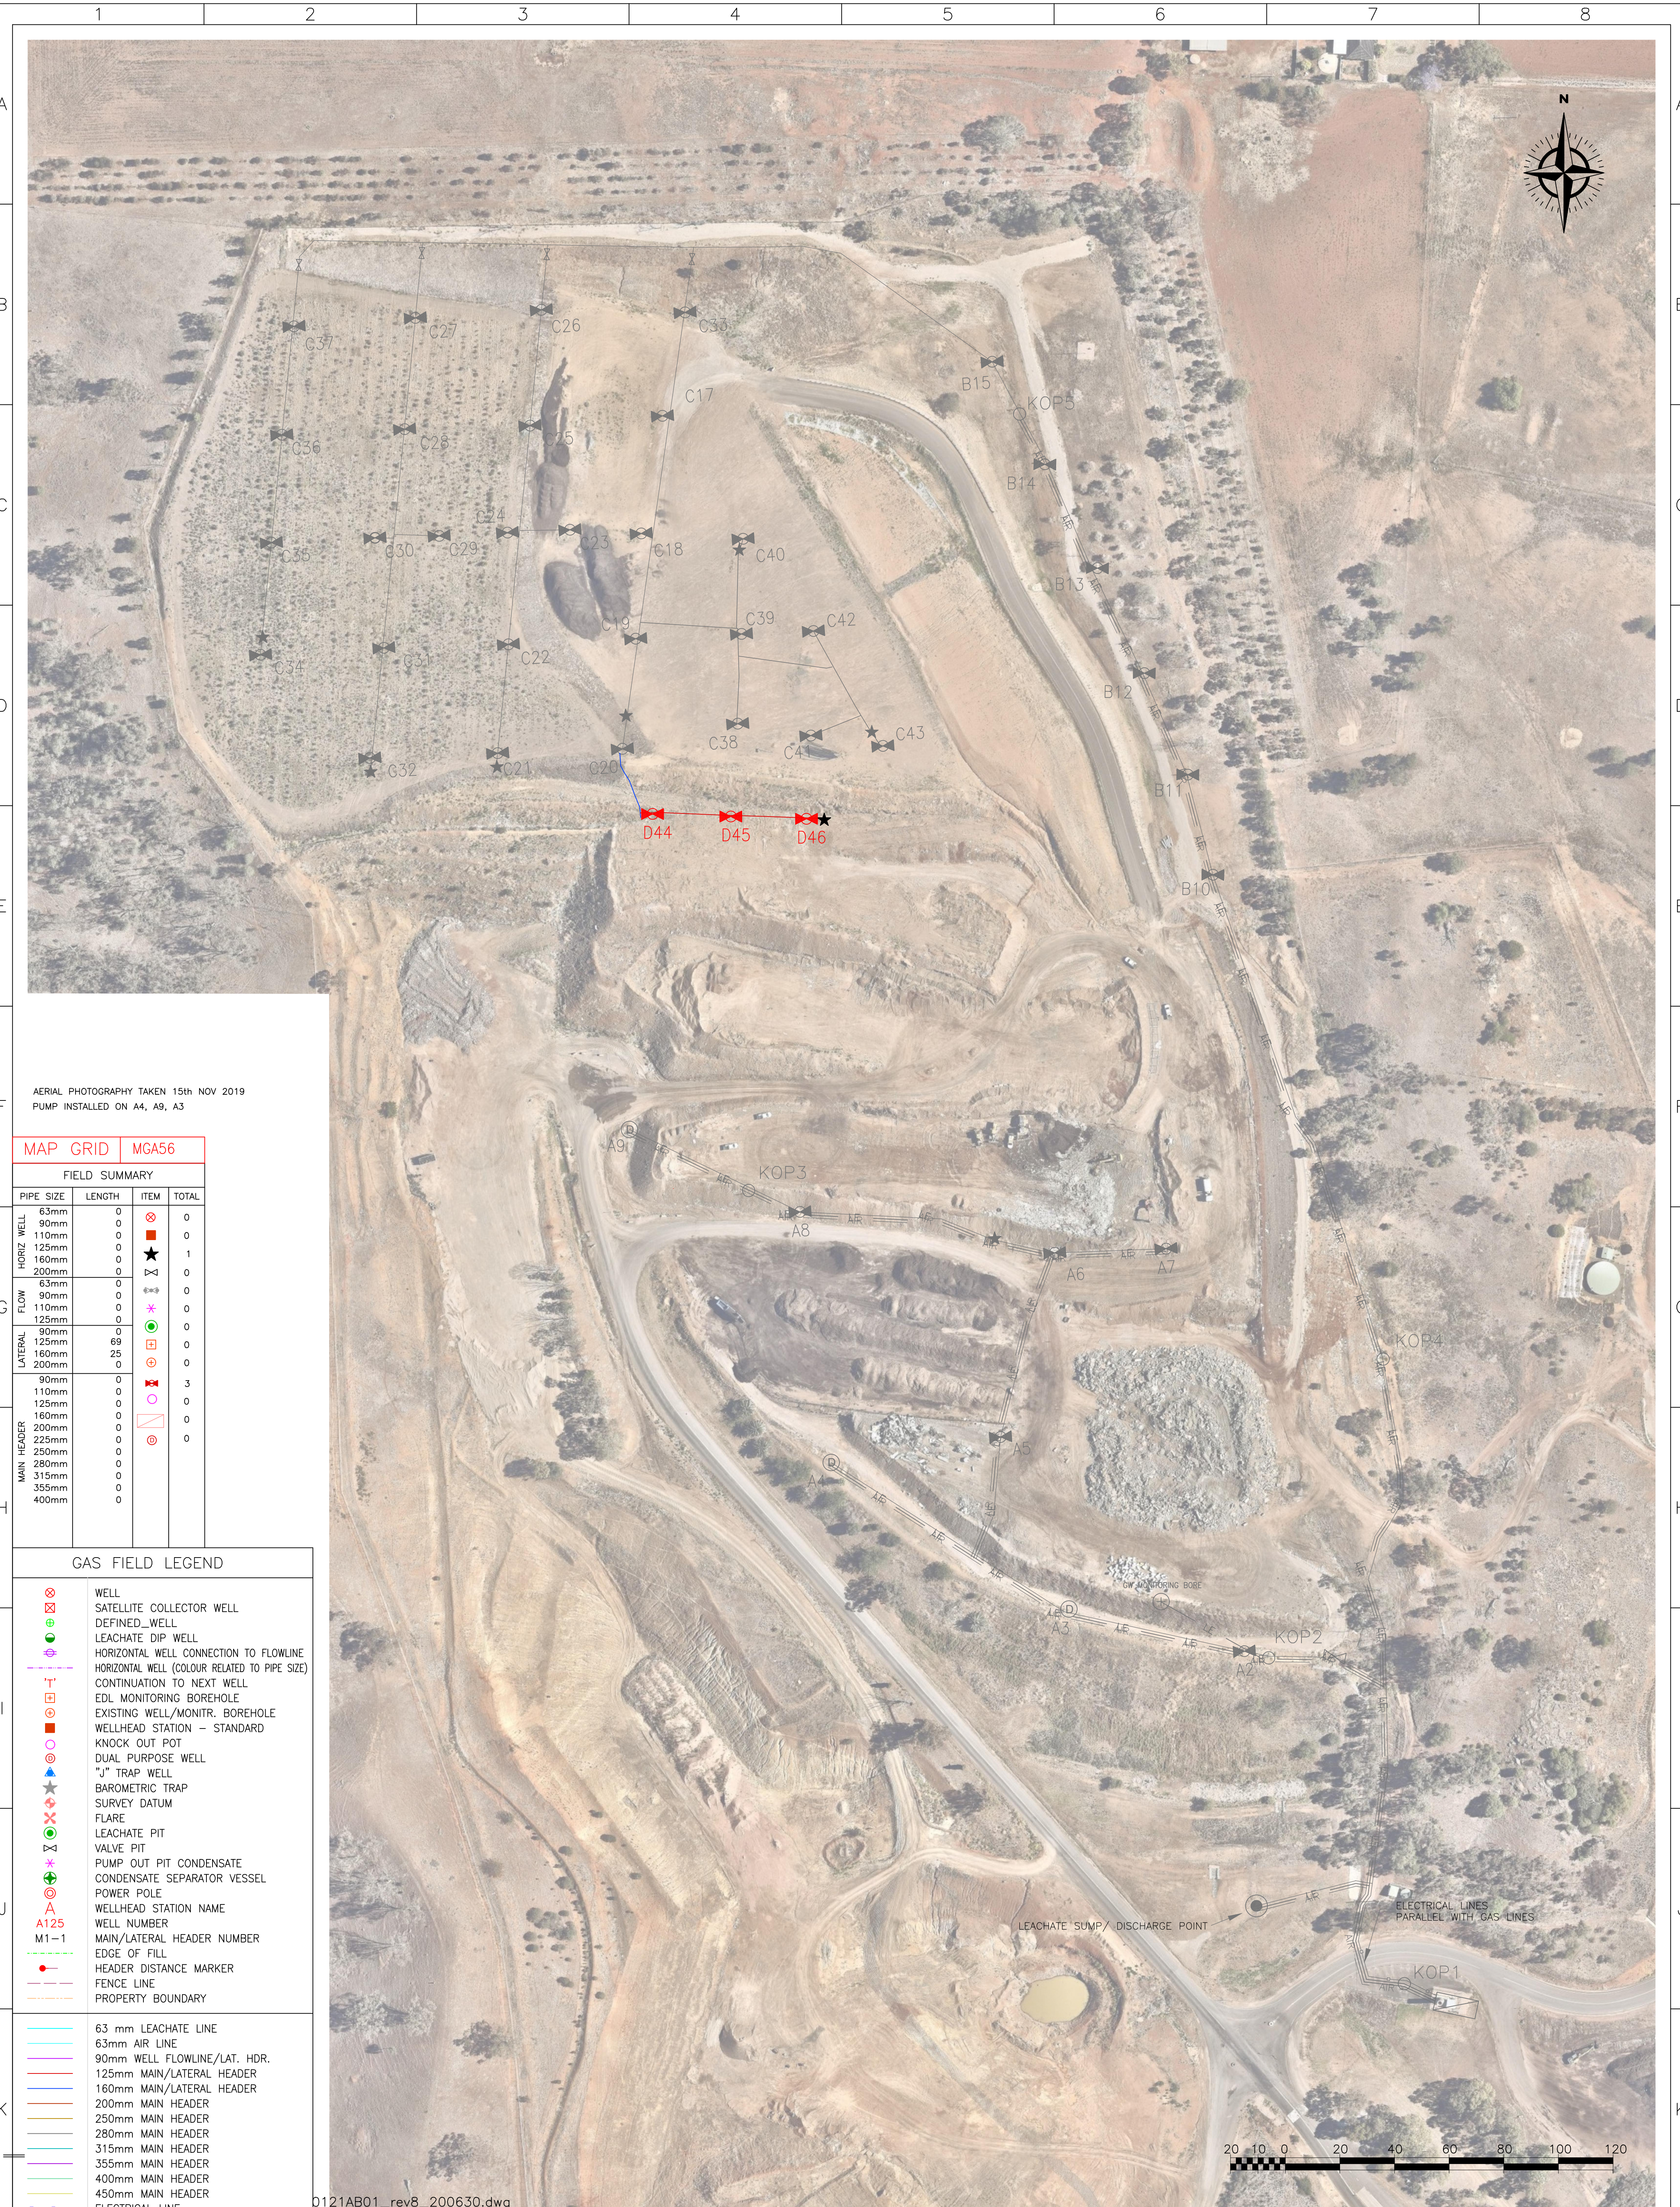

AERIAL PHOTOGRAPHY TAKEN 15th NOV 2019
PUMP INSTALLED ON A4, A9, A3

MAP GRID		MGA56			
FIELD SUMMARY					
	PIPE SIZE	LENGTH	ITEM	TOTAL	
G	HORIZ. WELL	63mm	0	⊗	0
		90mm	0	⊗	0
		110mm	0	⊗	0
		125mm	0	★	1
		160mm	0	⊗	0
	FLOW	200mm	0	⊗	0
		63mm	0	⊗	0
		90mm	0	⊗	0
		110mm	0	✱	0
		125mm	0	⊗	0
LATERAL	90mm	0	⊗	0	
	125mm	6	⊗	0	
	160mm	25	⊗	0	
	200mm	0	⊗	0	
	90mm	0	⊗	3	
MAIN HEADER	110mm	0	⊗	0	
	125mm	0	⊗	0	
	160mm	0	⊗	0	
	200mm	0	⊗	0	
	225mm	0	⊗	0	
	250mm	0	⊗	0	
	280mm	0	⊗	0	
	315mm	0	⊗	0	
355mm	0	⊗	0		
400mm	0	⊗	0		

GAS FIELD LEGEND	
	WELL
	SATELLITE COLLECTOR WELL
	DEFINED WELL
	LEACHATE DIP WELL
	HORIZONTAL WELL CONNECTION TO FLOWLINE
	HORIZONTAL WELL (COLOUR RELATED TO PIPE SIZE)
	CONTINUATION TO NEXT WELL
	EDL MONITORING BOREHOLE
	EXISTING WELL/MONITR. BOREHOLE
	WELLHEAD STATION - STANDARD
	KNOCK OUT POT
	DUAL PURPOSE WELL
	"J" TRAP WELL
	BAROMETRIC TRAP
	SURVEY DATUM
	FLARE
	LEACHATE PIT
	VALVE PIT
	PUMP OUT PIT CONDENSATE
	CONDENSATE SEPARATOR VESSEL
	POWER POLE
	WELLHEAD STATION NAME
	WELL NUMBER
	MAIN/LATERAL HEADER NUMBER
	EDGE OF FILL
	HEADER DISTANCE MARKER
	FENCE LINE
	PROPERTY BOUNDARY
	63 mm LEACHATE LINE
	63mm AIR LINE
	90mm WELL FLOWLINE/LAT. HDR.
	125mm MAIN/LATERAL HEADER
	160mm MAIN/LATERAL HEADER
	200mm MAIN HEADER
	250mm MAIN HEADER
	280mm MAIN HEADER
	315mm MAIN HEADER
	355mm MAIN HEADER
	400mm MAIN HEADER
	450mm MAIN HEADER
	ELECTRICAL LINE

REV	AMENDMENTS	DRAWN	DESIGNED	CHECKED	APPROVED	DATE	ASSOCIATED DRAWING	DRAWING NUMBER
8	ASBUILT UPDATE - D044, D045 AND D046	ZB	RC	RC	RC	30.06.20		
7	ASBUILT UPDATE - ADDED IDS TO KOPS AND WELLS	ZB	AD	AD	AD	07.01.20		
F	AS BUILT DATA ADDED	KCK	RC	RC	RC	09.10.18		
E	BARO TRAPS ADDED/MOVED	KK	RB	RB	RB	2.11.17		
D	DRAWING UPDATED	KK	RB	RB	RB	9.5.17		
C	FIELD SUMMARY UPDATED	KK	RB	RB	RB	1.5.17		
B	UPDATED TO SITE SURVEY	KK	RB	RB	RB	24.4.17		
A	D.I.P. - ORIGINAL ISSUE							

199C OSBORNE AVE, CLAYTON STH, VIC 3169
PH: (03) 9538 6200
www.runenergy.com

PROJECT TAMWORTH FOREST RD LANDFILL GAS PROJECT		
DRAWING TITLE GASFIELD COLLECTION SYSTEM JOB AS BUILT		
SCALE N.T.S.	DRAWING NUMBER 121-TAMWORTH	SAVE DATE 6/30/2020
DRAWN DATE	DESIGN DATE	APPRVD DATE
LAST PLOTTED TIME: 6/30/2020 2:59 PM DATE:		LAST MODIFIED TIME: DATE: 01/01/97