


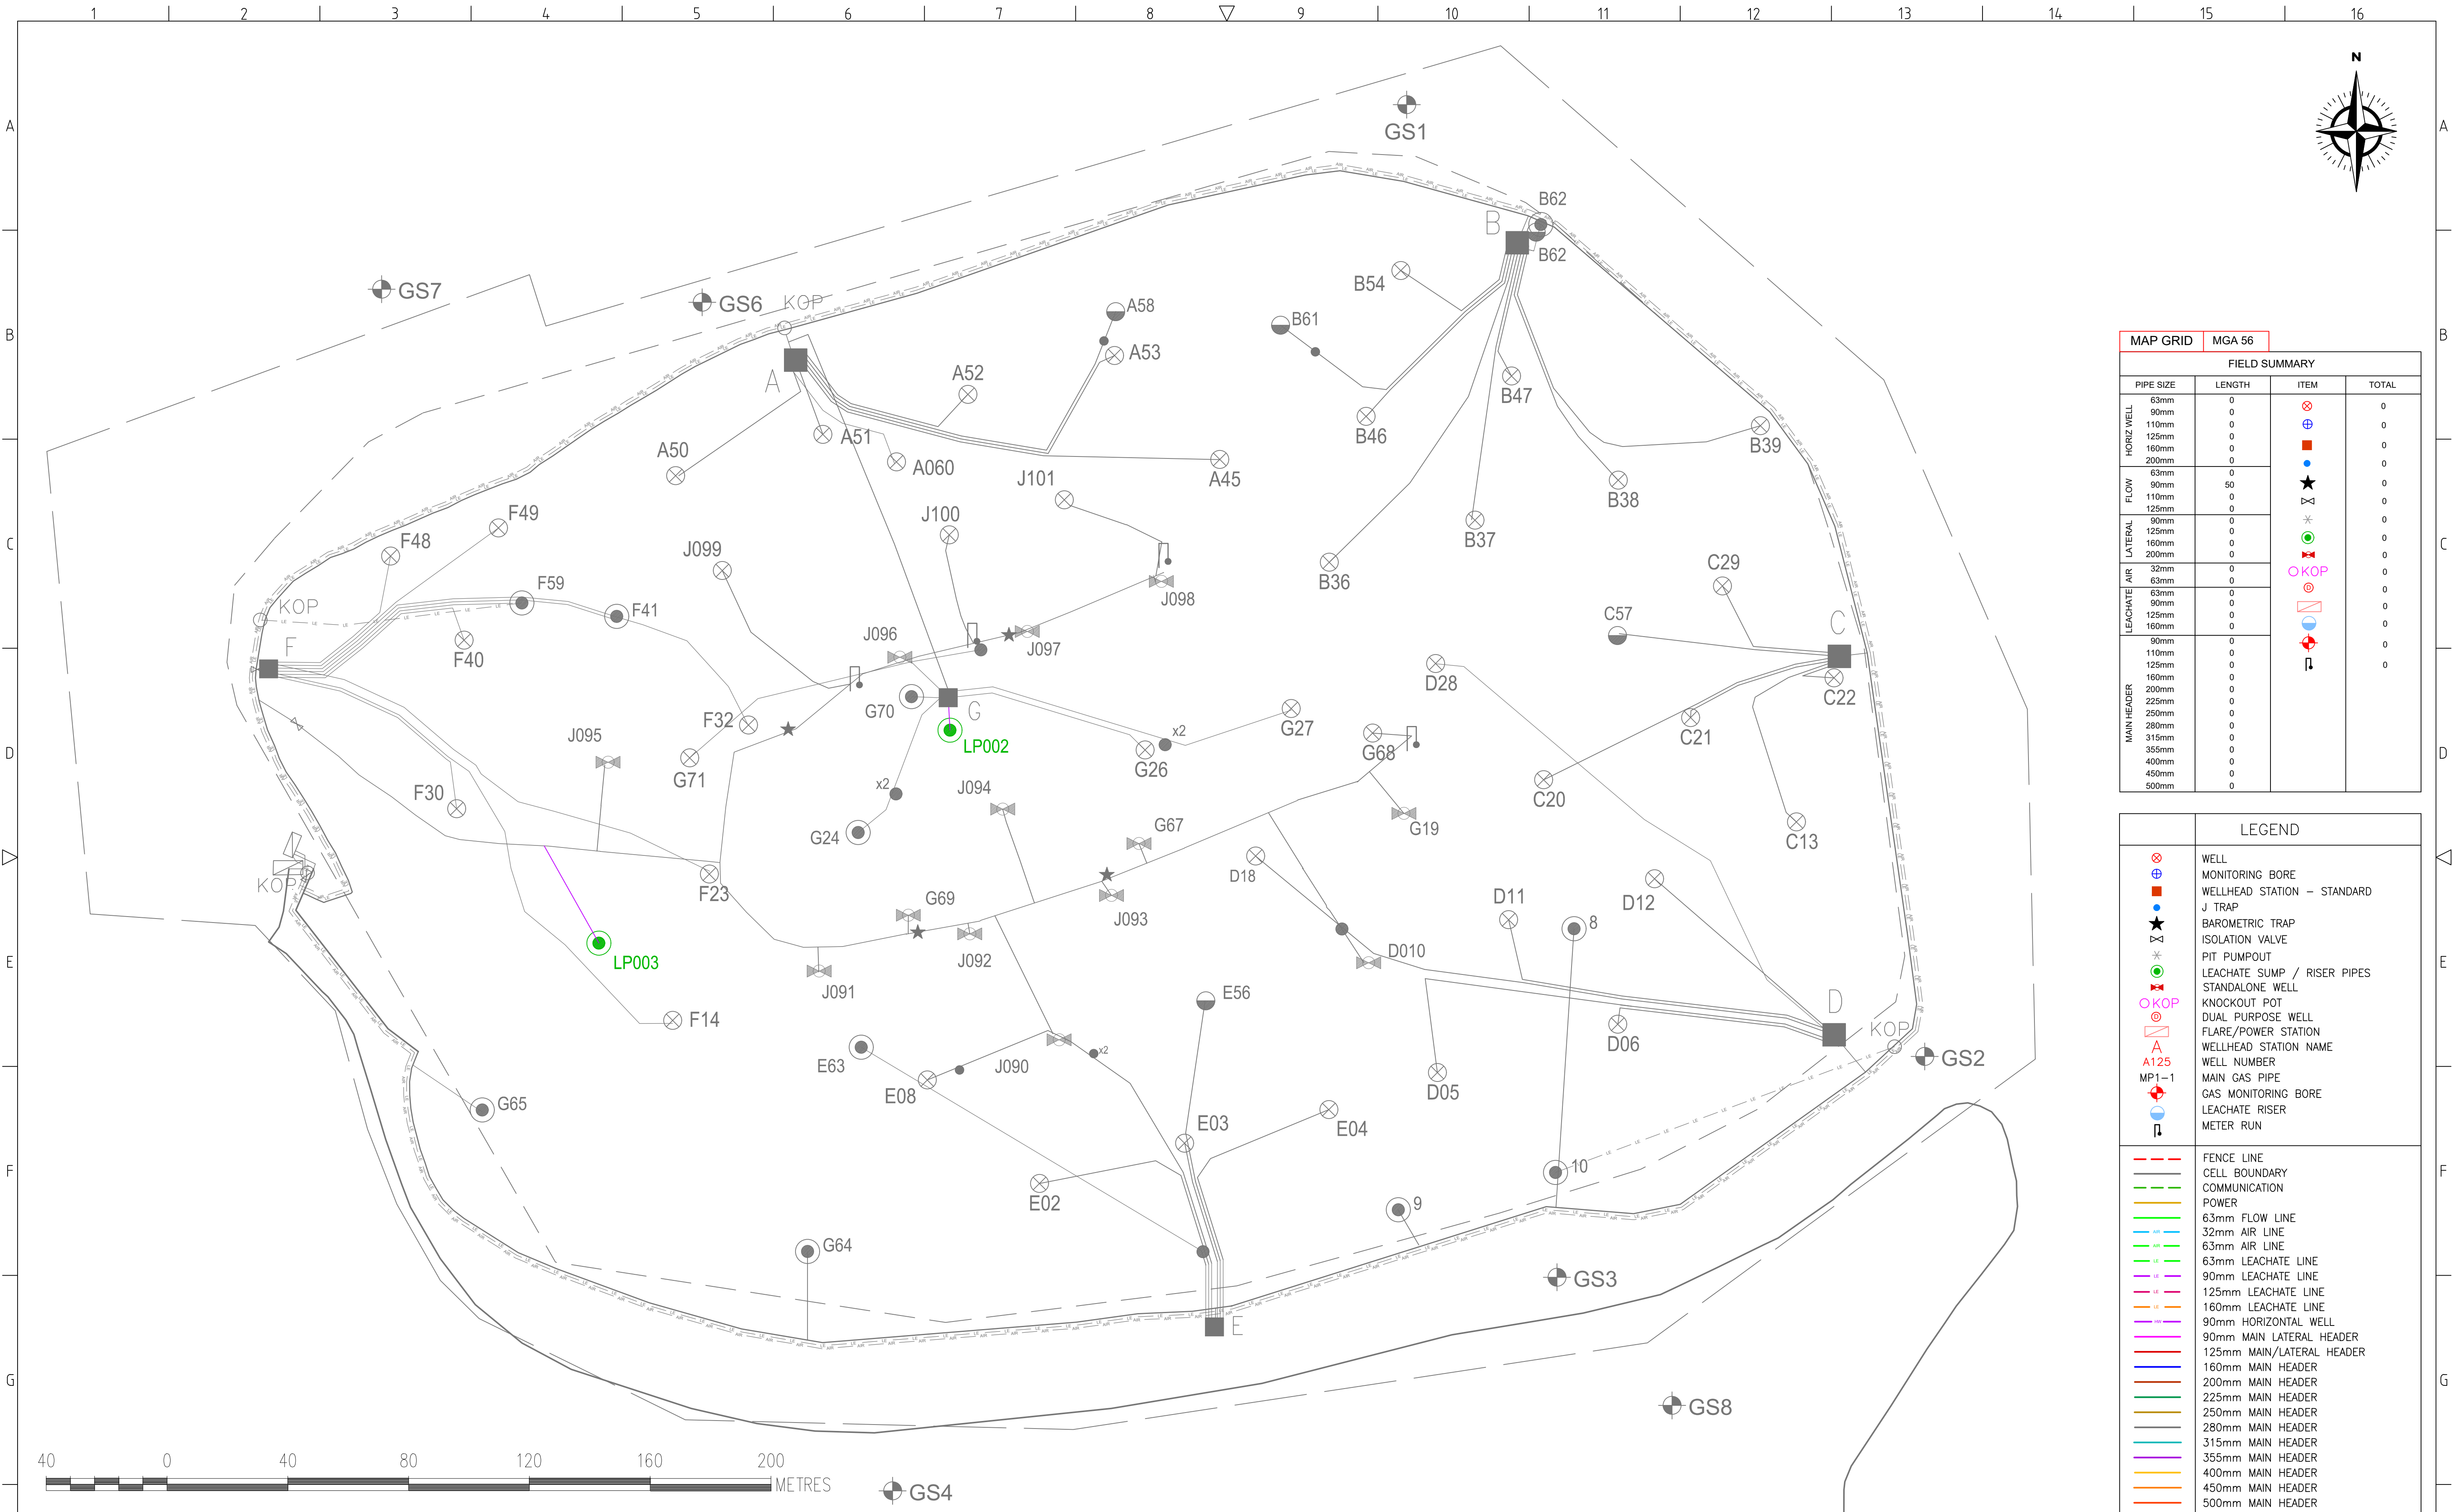

MAP GRID		MGA 56			
FIELD SUMMARY					
	PIPE SIZE	LENGTH	ITEM	TOTAL	
HORIZ WELL	63mm	0		0	
	90mm	0			
	110mm	0			
	125mm	0			
	160mm	0			
FLOW	200mm	0		0	
	63mm	0			
	90mm	50			0
	110mm	0			0
	125mm	0			0
LATERAL	90mm	0		0	
	125mm	0			
	160mm	0			
	200mm	0			
	32mm	0			
AIR	63mm	0		0	
	63mm	0			
	90mm	0			
	125mm	0			
	160mm	0			
LEACHATE	90mm	0		0	
	110mm	0			
	125mm	0			
	160mm	0			
	90mm	0			
MAIN HEADER	110mm	0	           	0	
	125mm	0			
	160mm	0			
	200mm	0			
	225mm	0			
	250mm	0			
	280mm	0			
	315mm	0			
	355mm	0			
	400mm	0			
	450mm	0			
	500mm	0			

LEGEND	
⊗	WELL
⊕	MONITORING BORE
⊕	WELLHEAD STATION - STANDARD
●	J TRAP
★	BAROMETRIC TRAP
⊗	ISOLATION VALVE
⊗	PIT PUMPOUT
⊗	LEACHATE SUMP / RISER PIPES
⊗	STANDALONE WELL
⊗	KNOCKOUT POT
⊗	DUAL PURPOSE WELL
⊗	FLARE/POWER STATION
⊗	WELLHEAD STATION NAME
A125	WELL NUMBER
MP1-1	MAIN GAS PIPE
⊗	GAS MONITORING BORE
⊗	LEACHATE RISER
⊗	METER RUN
---	FENCE LINE
---	CELL BOUNDARY
---	COMMUNICATION
---	POWER
---	63mm FLOW LINE
---	32mm AIR LINE
---	63mm AIR LINE
---	63mm LEACHATE LINE
---	90mm LEACHATE LINE
---	125mm LEACHATE LINE
---	160mm LEACHATE LINE
---	90mm HORIZONTAL WELL
---	90mm MAIN LATERAL HEADER
---	125mm MAIN/LATERAL HEADER
---	160mm MAIN HEADER
---	200mm MAIN HEADER
---	225mm MAIN HEADER
---	250mm MAIN HEADER
---	280mm MAIN HEADER
---	315mm MAIN HEADER
---	355mm MAIN HEADER
---	400mm MAIN HEADER
---	450mm MAIN HEADER
---	500mm MAIN HEADER

						6	GCS INSTALLATION. MIGRATION WELLS	ZB	RC	RC	14.08.2020
						5	GCS INSTALLATION. REDRILLS / FLOW LINES	ZB	RC	RC	14.08.2020
9	REVISED RING MAIN HEADER LOCATION	ZB	AD	AD	17.09.2020	4	LP003 AND LP002 GCS CONNECTION	ZB	RC	RC	09.06.2020
8	ADDED AUSTRAL HEADER LINE	ZB	AD	AD	25.08.2020	3	UPDATED AERIAL IMAGE	ZB	AD	AD	25.02.2020
7	REVISED WELL ID LP001. CHANGED TO LP003	ZB	AD	AD	17.08.2020	2	REVISED ASBUILT	ZB	AD	AD	08.01.2020
REV	DESCRIPTION	BY	CKD	APP	DATE	REV	DESCRIPTION	BY	CKD	APP	DATE
REVISION HISTORY						REVISION HISTORY					



199C OSBORNE AVE, CLAYTON STH, VIC 3169
PH: (03) 9538 6200
www.runenergy.com

PROJECT:	ERSKINE PARK LANDFILL GAS PROJECT
DRAWING TITLE:	GAS COLLECTION SYSTEM INSTALLATION

DRAWING No:		RE-ERSKINE-001	
DRAWING TYPE:			
JOB ASBUILT			
DRAWN: ZB		CKD: RC	
DATE: 09.06.2020		APP: RC	
DESIGNED: RC		APP DATE: 09.06.2020	
SCALE: 1:1000	SHEET: 1 of 1	REV: 4	SIZE: A1
15		16	