



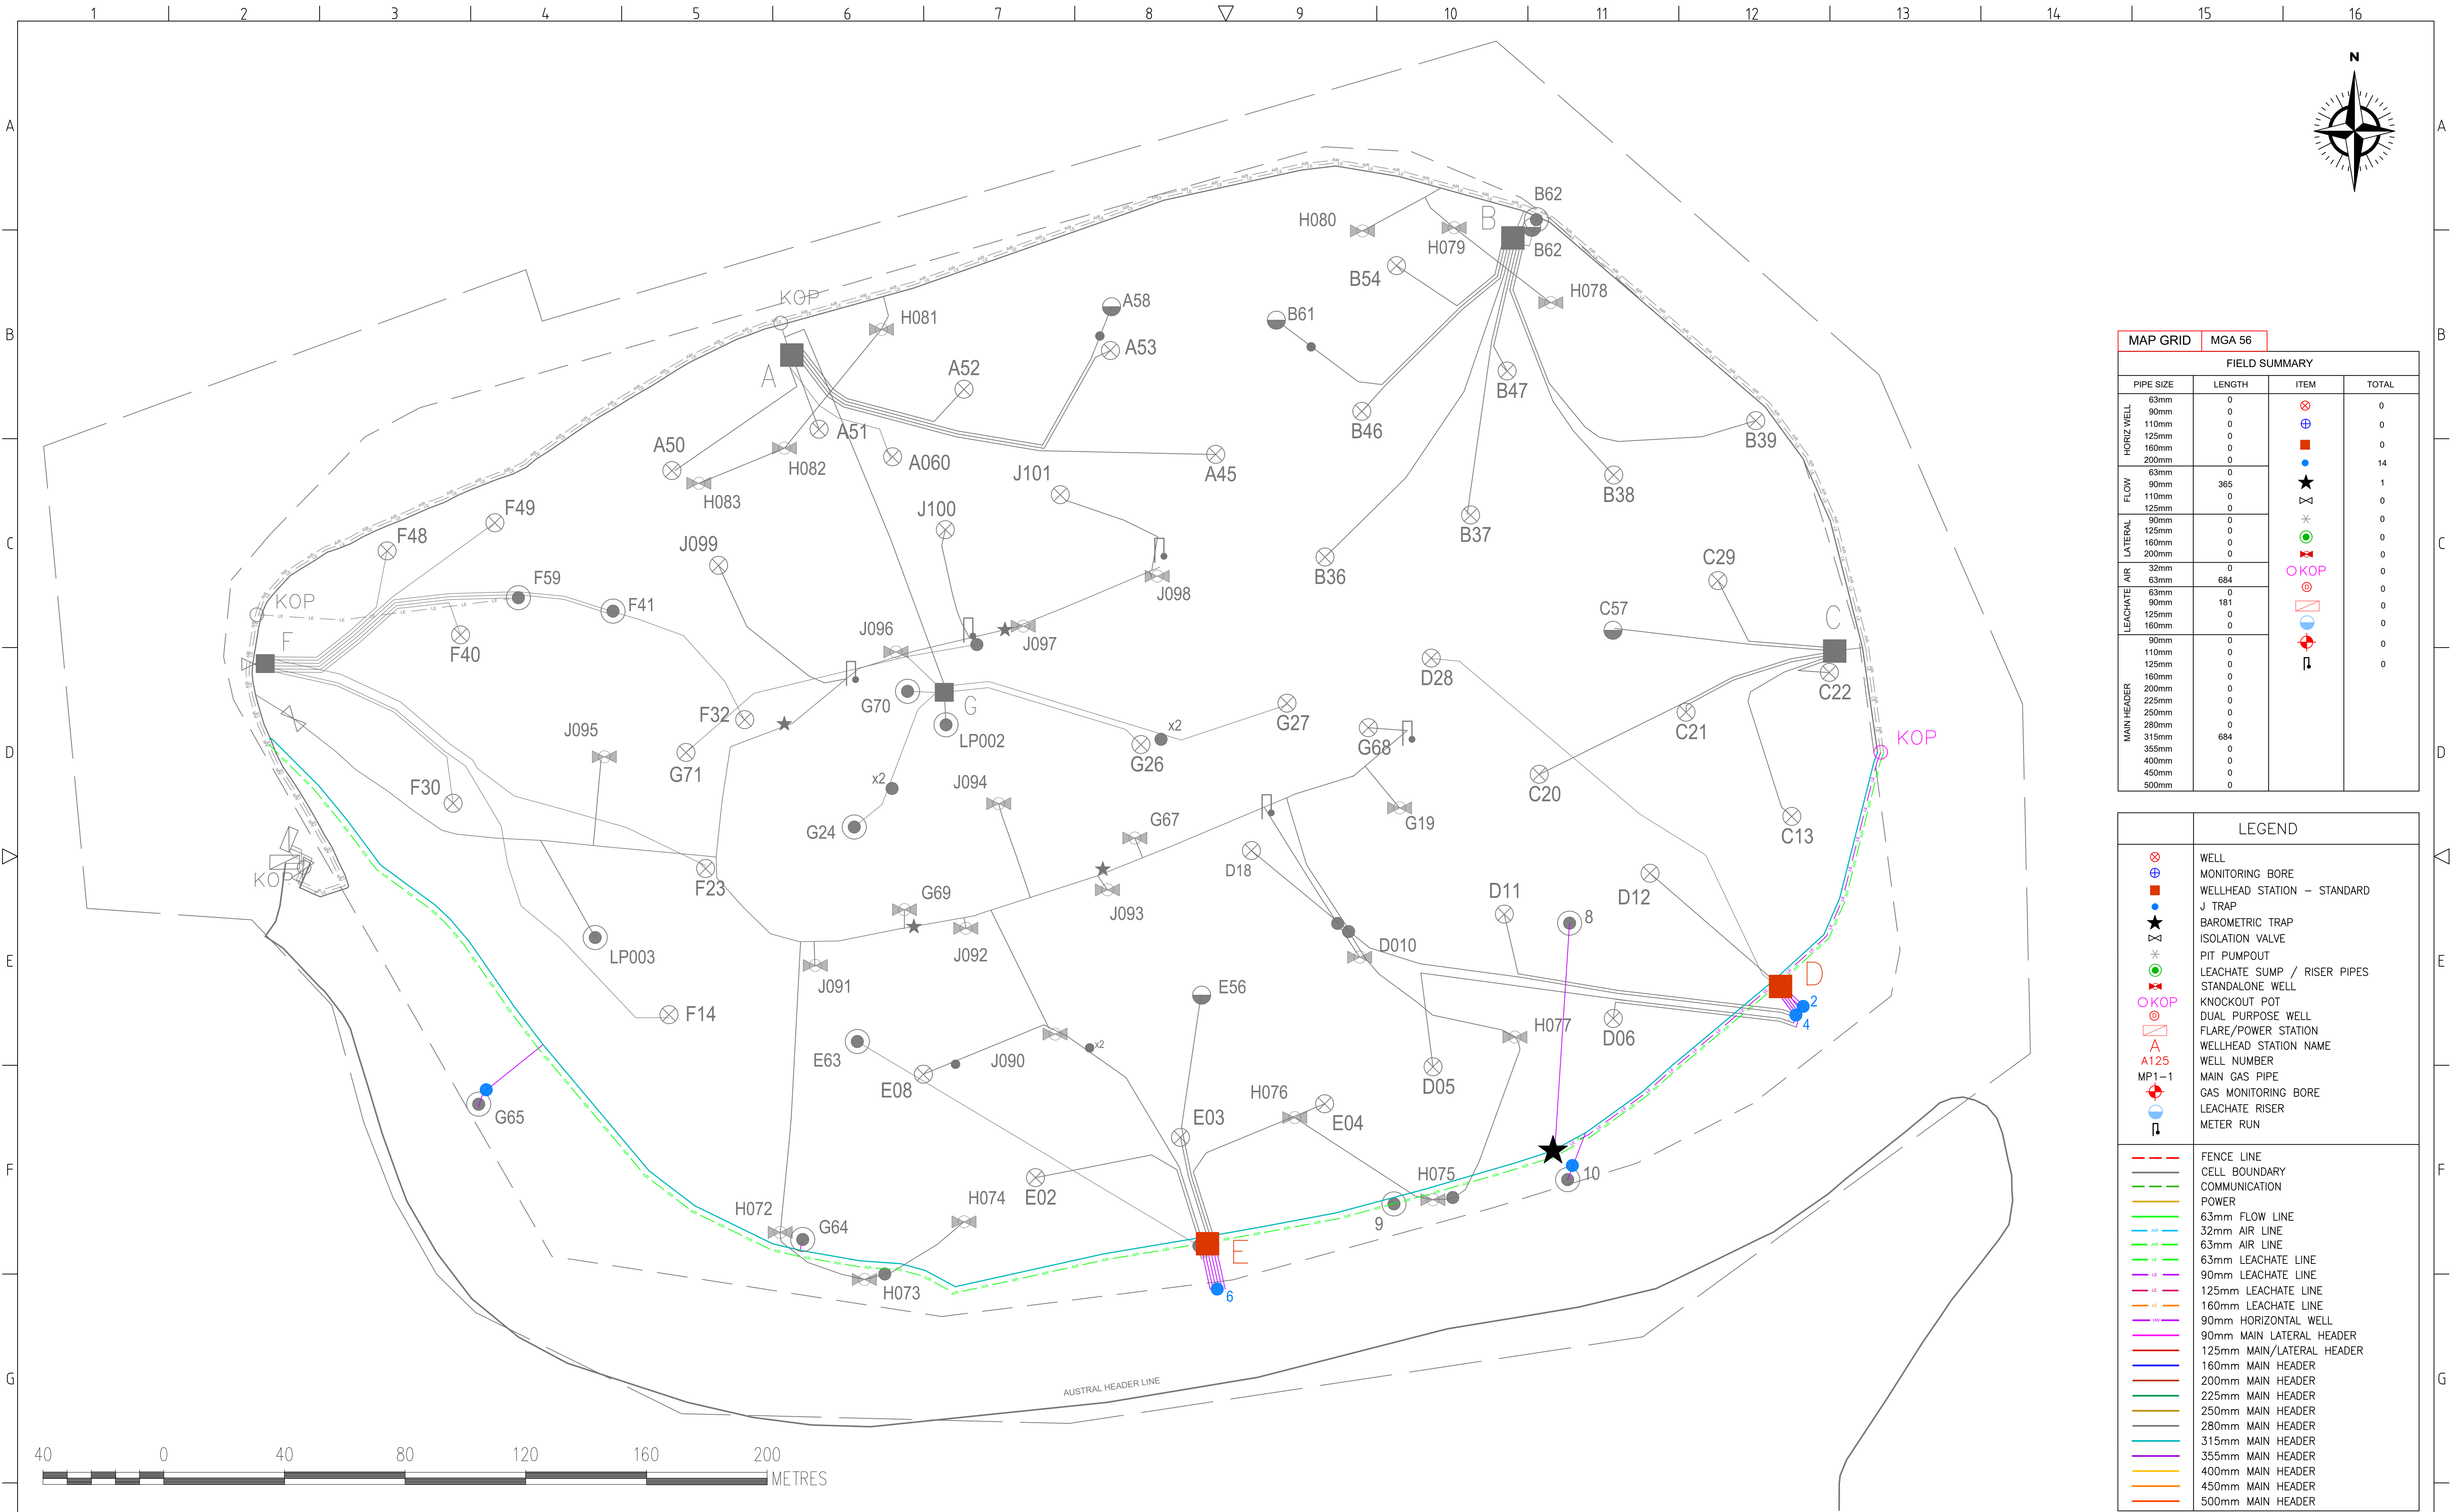

REV	DESCRIPTION	BY	CKD	APP	DATE	REV	DESCRIPTION	BY	CKD	APP	DATE
10	SOUTHERN MAIN HEADER RELOCATED.	ZB	RC	RC	17.11.2020	6	GCS INSTALLATION. MIGRATION WELLS	ZB	RC	RC	14.08.2020
9	REVISED RING MAIN HEADER LOCATION	ZB	AD	AD	17.09.2020	5	GCS INSTALLATION. REDRILLS / FLOW LINES	ZB	RC	RC	14.08.2020
8	ADDED AUSTRAL HEADER LINE	ZB	AD	AD	25.08.2020	4	LP003 AND LP002 GCS CONNECTION	ZB	RC	RC	09.06.2020
7	REVISED WELL ID LP001. CHANGED TO LP003	ZB	AD	AD	17.08.2020	3	UPDATED AERIAL IMAGE	ZB	AD	AD	25.02.2020
6	ADDED AUSTRAL HEADER LINE	ZB	AD	AD	25.08.2020	2	REVISED ASBUILT	ZB	AD	AD	08.01.2020
5	REVISED WELL ID LP001. CHANGED TO LP003	ZB	AD	AD	17.08.2020	1	REVISED ASBUILT	ZB	AD	AD	08.01.2020
4	ADDED AUSTRAL HEADER LINE	ZB	AD	AD	25.08.2020	0	REVISED ASBUILT	ZB	AD	AD	08.01.2020
3	ADDED AUSTRAL HEADER LINE	ZB	AD	AD	25.08.2020	0	REVISED ASBUILT	ZB	AD	AD	08.01.2020
2	ADDED AUSTRAL HEADER LINE	ZB	AD	AD	25.08.2020	0	REVISED ASBUILT	ZB	AD	AD	08.01.2020
1	ADDED AUSTRAL HEADER LINE	ZB	AD	AD	25.08.2020	0	REVISED ASBUILT	ZB	AD	AD	08.01.2020

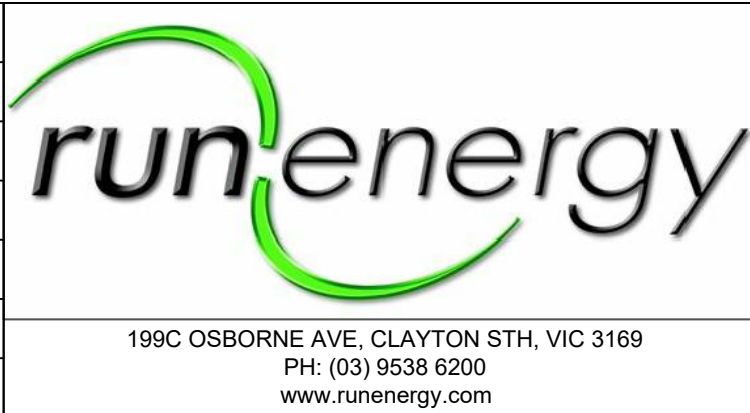

PROJECT: ERSKINE PARK LANDFILL GAS PROJECT
DRAWING TITLE: GAS COLLECTION SYSTEM SITE LAYOUT

DRAWING No:	RE-ERSKINE-001
DRAWING TYPE:	JOB ASBUILT
DRAWN:	ZB
DATE:	17.11.2020
DESIGNED:	RC
SCALE:	1:1000
SHEET:	1 of 1
REV:	10
SIZE:	A1