


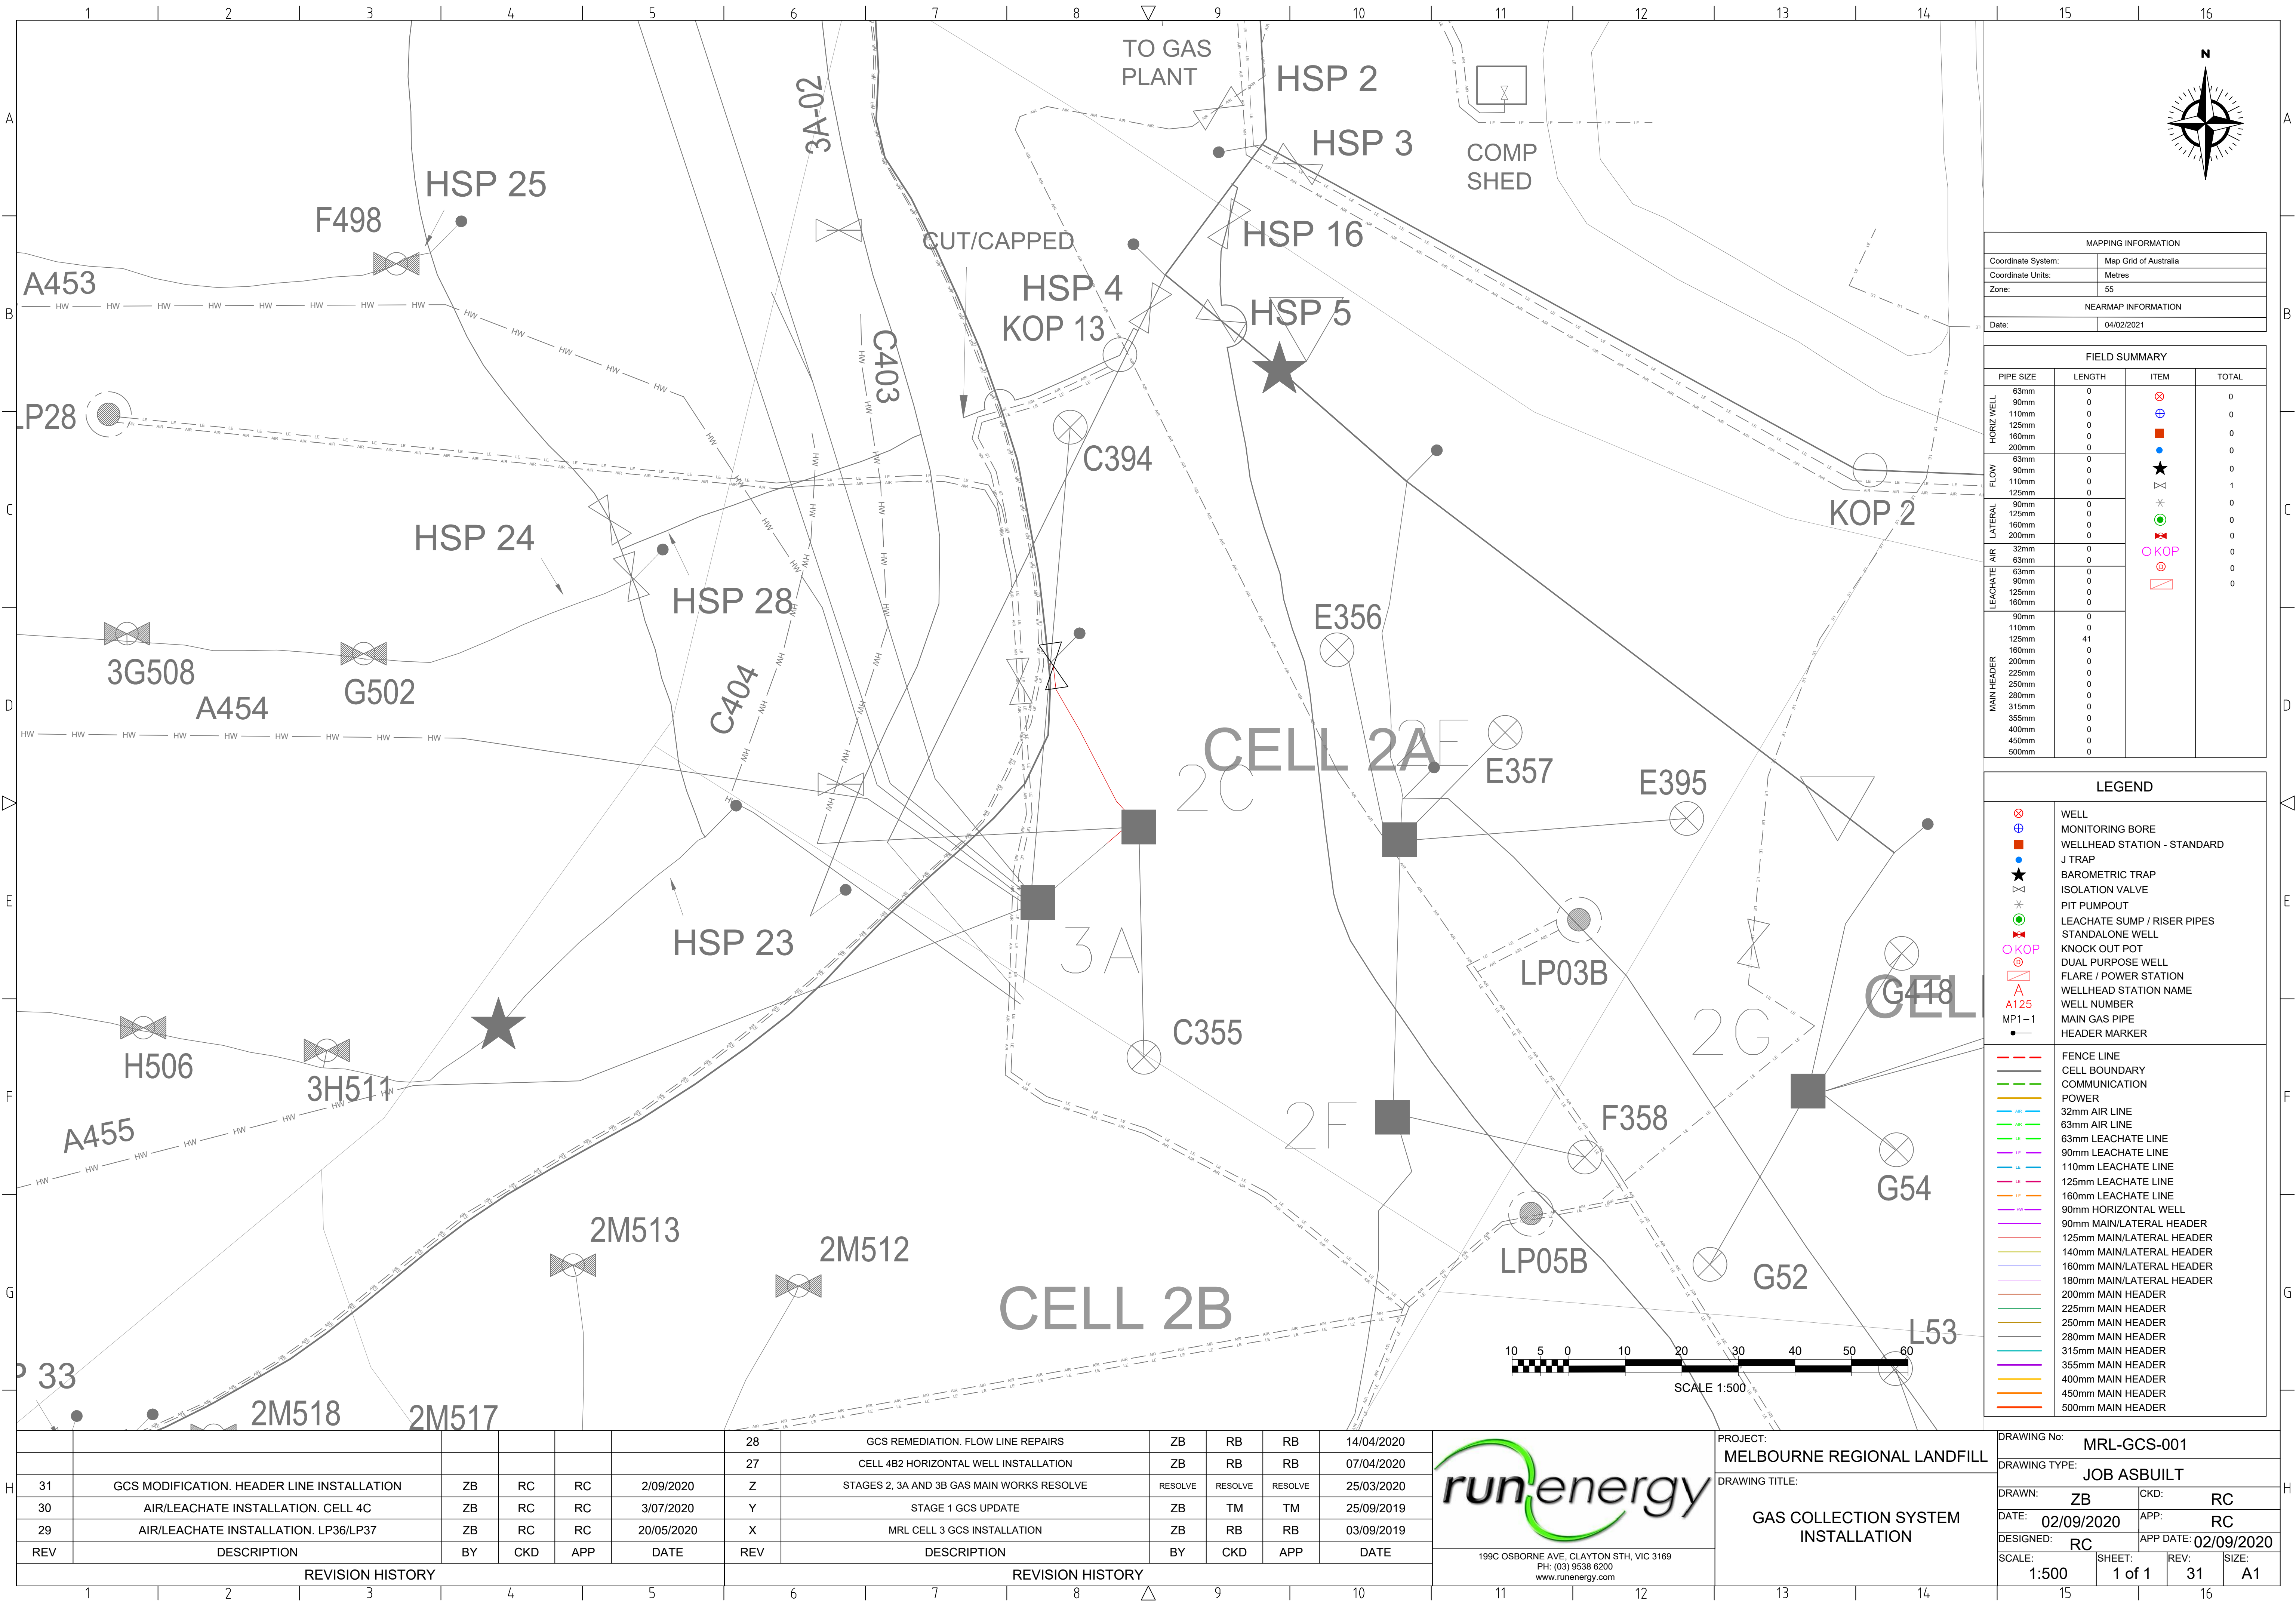

MAPPING INFORMATION	
Coordinate System:	Map Grid of Australia
Coordinate Units:	Metres
Zone:	55
NEARMAP INFORMATION	
Date:	04/02/2021

FIELD SUMMARY			
PIPE SIZE	LENGTH	ITEM	TOTAL
HORIZ WELL	63mm	0	0
	90mm	0	0
	110mm	0	0
	125mm	0	0
	160mm	0	0
FLOW	63mm	0	0
	90mm	0	0
	110mm	0	1
	125mm	0	0
	160mm	0	0
LATERAL	90mm	0	0
	125mm	0	0
	160mm	0	0
	200mm	0	0
	32mm	0	0
AIR	63mm	0	0
	90mm	0	0
	125mm	0	0
	160mm	0	0
	200mm	0	0
LEACHATE	63mm	0	0
	90mm	0	0
	125mm	0	0
	160mm	0	0
	200mm	0	0
MAIN HEADER	90mm	0	0
	110mm	0	0
	125mm	41	0
	160mm	0	0
	200mm	0	0
	225mm	0	0
	250mm	0	0
	280mm	0	0
	315mm	0	0
	355mm	0	0
	400mm	0	0
	450mm	0	0
	500mm	0	0

LEGEND	
	WELL
	MONITORING BORE
	WELLHEAD STATION - STANDARD
	J TRAP
	BAROMETRIC TRAP
	ISOLATION VALVE
	PIT PUMPOUT
	LEACHATE SUMP / RISER PIPES
	STANDALONE WELL
	KNOCK OUT POT
	DUAL PURPOSE WELL
	FLARE / POWER STATION
	WELLHEAD STATION NAME
	WELL NUMBER
	MAIN GAS PIPE
	HEADER MARKER
	FENCE LINE
	CELL BOUNDARY
	COMMUNICATION
	POWER
	32mm AIR LINE
	63mm AIR LINE
	63mm LEACHATE LINE
	90mm LEACHATE LINE
	110mm LEACHATE LINE
	125mm LEACHATE LINE
	160mm LEACHATE LINE
	90mm HORIZONTAL WELL
	90mm MAIN/LATERAL HEADER
	125mm MAIN/LATERAL HEADER
	140mm MAIN/LATERAL HEADER
	160mm MAIN/LATERAL HEADER
	180mm MAIN/LATERAL HEADER
	200mm MAIN HEADER
	225mm MAIN HEADER
	250mm MAIN HEADER
	280mm MAIN HEADER
	315mm MAIN HEADER
	355mm MAIN HEADER
	400mm MAIN HEADER
	450mm MAIN HEADER
	500mm MAIN HEADER

						28	GCS REMEDIATION. FLOW LINE REPAIRS	ZB	RB	RB	14/04/2020
						27	CELL 4B2 HORIZONTAL WELL INSTALLATION	ZB	RB	RB	07/04/2020
						Z	STAGES 2, 3A AND 3B GAS MAIN WORKS RESOLVE	RESOLVE	RESOLVE	RESOLVE	25/03/2020
31	GCS MODIFICATION. HEADER LINE INSTALLATION	ZB	RC	RC	2/09/2020	Y	STAGE 1 GCS UPDATE	ZB	TM	TM	25/09/2019
30	AIR/LEACHATE INSTALLATION. CELL 4C	ZB	RC	RC	3/07/2020	X	MRL CELL 3 GCS INSTALLATION	ZB	RB	RB	03/09/2019
29	AIR/LEACHATE INSTALLATION. LP36/LP37	ZB	RC	RC	20/05/2020						
REV	DESCRIPTION	BY	CKD	APP	DATE	REV	DESCRIPTION	BY	CKD	APP	DATE

REVISION HISTORY

REVISION HISTORY

runenergy

199C OSBORNE AVE, CLAYTON STH, VIC 3169
PH: (03) 9538 6200
www.runenergy.com

PROJECT:
MELBOURNE REGIONAL LANDFILL

DRAWING TITLE:
**GAS COLLECTION SYSTEM
INSTALLATION**

DRAWING No:	MRL-GCS-001			
DRAWING TYPE:	JOB ASBUILT			
DRAWN:	ZB	CKD:	RC	
DATE:	02/09/2020	APP:	RC	
DESIGNED:	RC	APP DATE:	02/09/2020	
SCALE:	1:500	SHEET:	1 of 1	REV: 31
				SIZE: A1