
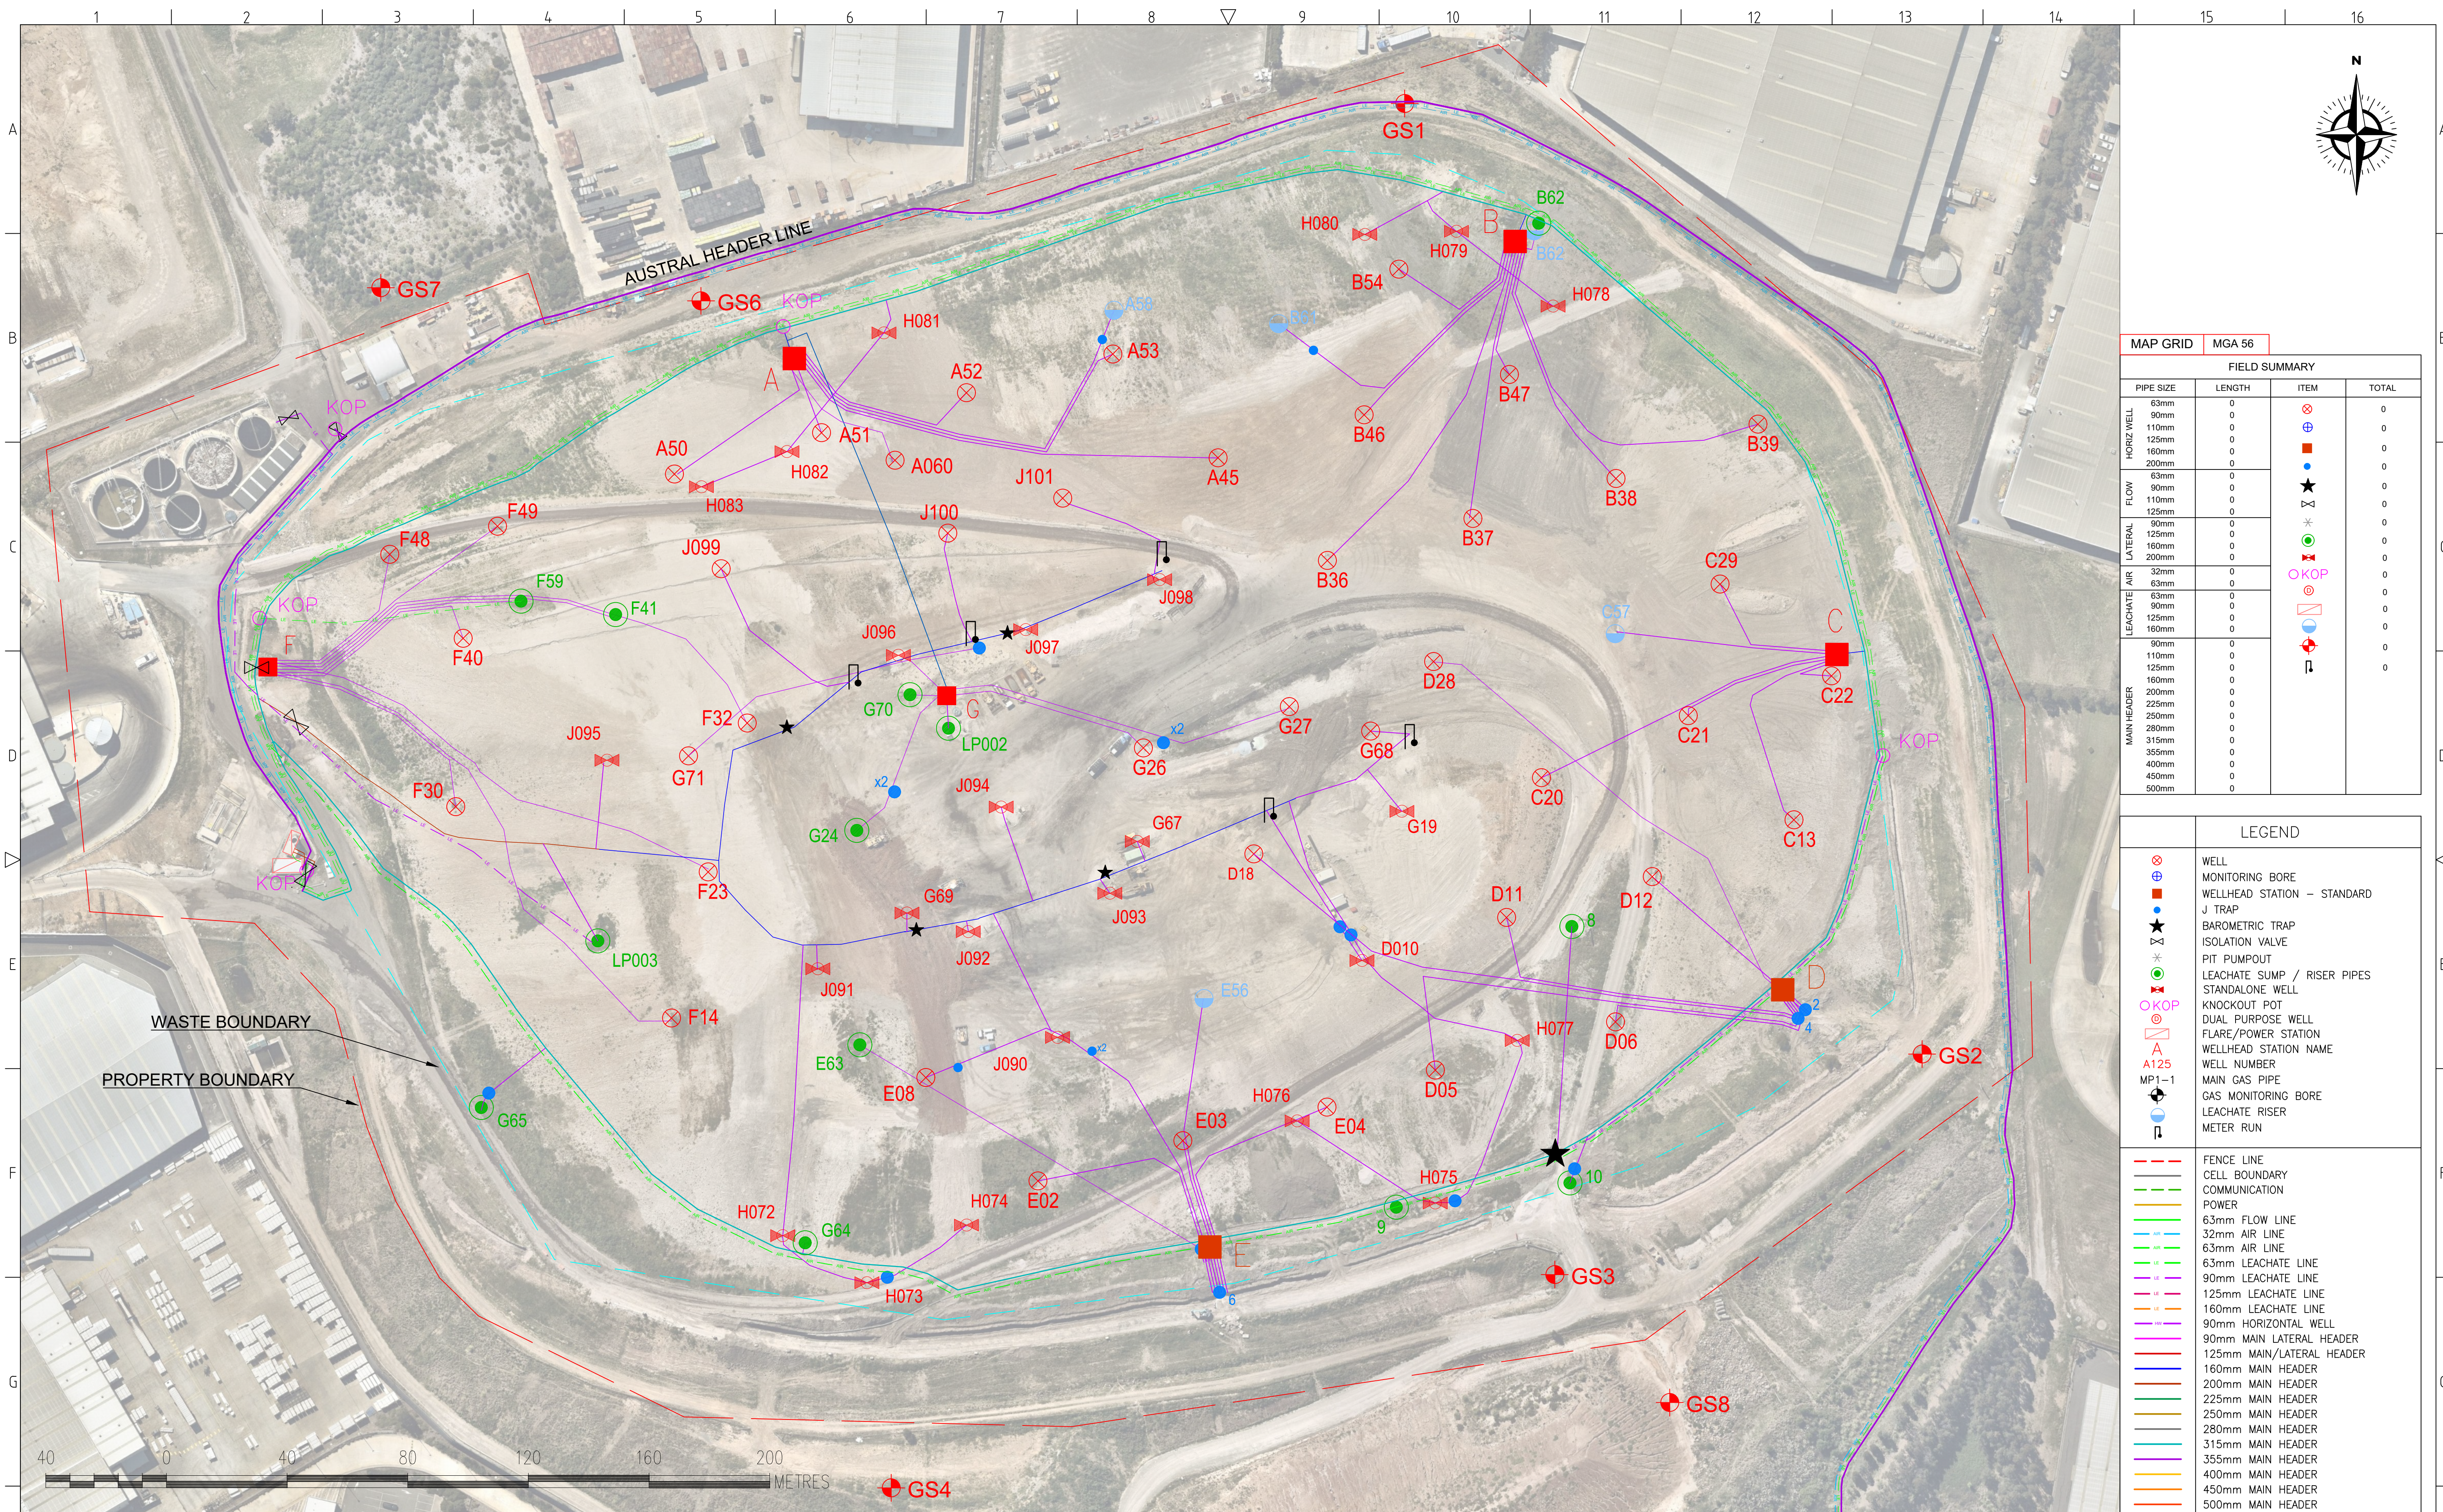


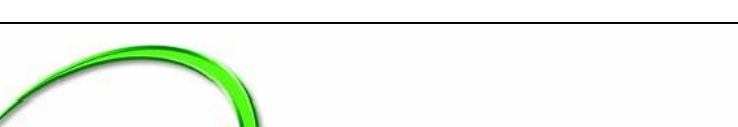

						11	90MM LEACHATE LINE INSTALLED FROM LP003 TO TANKS	ZB	RC	RC	19.10.2020	 199C OSBORNE AVE, CLAYTON STH, VIC 3169 PH: (03) 9538 6200 www.runenergy.com	PROJECT: ERSKINE PARK LANDFILL GAS PROJECT DRAWING TITLE: LEACHATE COLLECTION SYSTEM SITE LAYOUT	DRAWING No: RE-ERSKINE-001										
						10	SOUTHERN MAIN HEADER RELOCATED.	ZB	RC	RC	17.11.2020			DRAWING TYPE: ASBUILT										
						9	REVISED RING MAIN HEADER LOCATION	ZB	AD	AD	17.09.2020			DRAWN: ZB		CKD: RC								
						8	ADDED AUSTRAL HEADER LINE	ZB	AD	AD	25.08.2020			DATE: 24.12.2020		APP: RC								
12	GCS INSTALLATION AUSTRAL HEADER LINE				ZB	RB	RB	24.12.2020	7	REVISED WELL ID LP001. CHANGED TO LP003				ZB	AD	AD	17.08.2020	DESIGNED: RC		APP DATE: 24.12.2020				
REV	DESCRIPTION				BY	CKD	APP	DATE	REV	DESCRIPTION			BY	CKD	APP	DATE	SCALE: 1:1000		SHEET: 1 of 1		REV: 12		SIZE: A1	
REVISION HISTORY								REVISION HISTORY																
1	2	3	4	5	6	7	8	9	10	11	12	13	14	15	16									