




|     |                                                  |    |     |     |            |     |                                             |    |     |     |           |
|-----|--------------------------------------------------|----|-----|-----|------------|-----|---------------------------------------------|----|-----|-----|-----------|
| 37  | 110mm LEACHATE LINE AND 2 VALVES ADDED - STAGE 3 | ZB | RC  | RC  | 30/03/2021 | 33  | STAGE 4 GCS INSTALLATION                    | ZB | RC  | RC  | 4/02/2021 |
| 36  | ADDED GCS INSTALLATION STAGE 2                   | ZB | RC  | RC  | 1/03/2021  | 31  | ADDED HEADER MARKERS AND PIPE INTERSECTIONS | ZB | RC  | RC  |           |
| 35  | ADDED SUMP REDRILLS INSTALLED BY RESOLVE         | ZB | RC  | RC  | 26/02/2021 | 30  | GCS MODIFICATION. HEADER LINE INSTALLATION  | ZB | RC  | RC  |           |
| 34  | STAGE 2 GCS INSTALLATION                         | ZB | RC  | RC  | 5/02/2021  | 29  | AIR/LEACHATE INSTALLATION. CELL 4C          | ZB | RC  | RC  | 3/07/2020 |
| REV | DESCRIPTION                                      | BY | CKD | APP | DATE       | REV | DESCRIPTION                                 | BY | CKD | APP | DATE      |

|                  |  |   |  |   |  |                  |  |    |  |    |  |
|------------------|--|---|--|---|--|------------------|--|----|--|----|--|
| REVISION HISTORY |  |   |  |   |  | REVISION HISTORY |  |    |  |    |  |
| 1                |  | 2 |  | 3 |  | 4                |  | 5  |  | 6  |  |
| 7                |  | 8 |  | 9 |  | 10               |  | 11 |  | 12 |  |

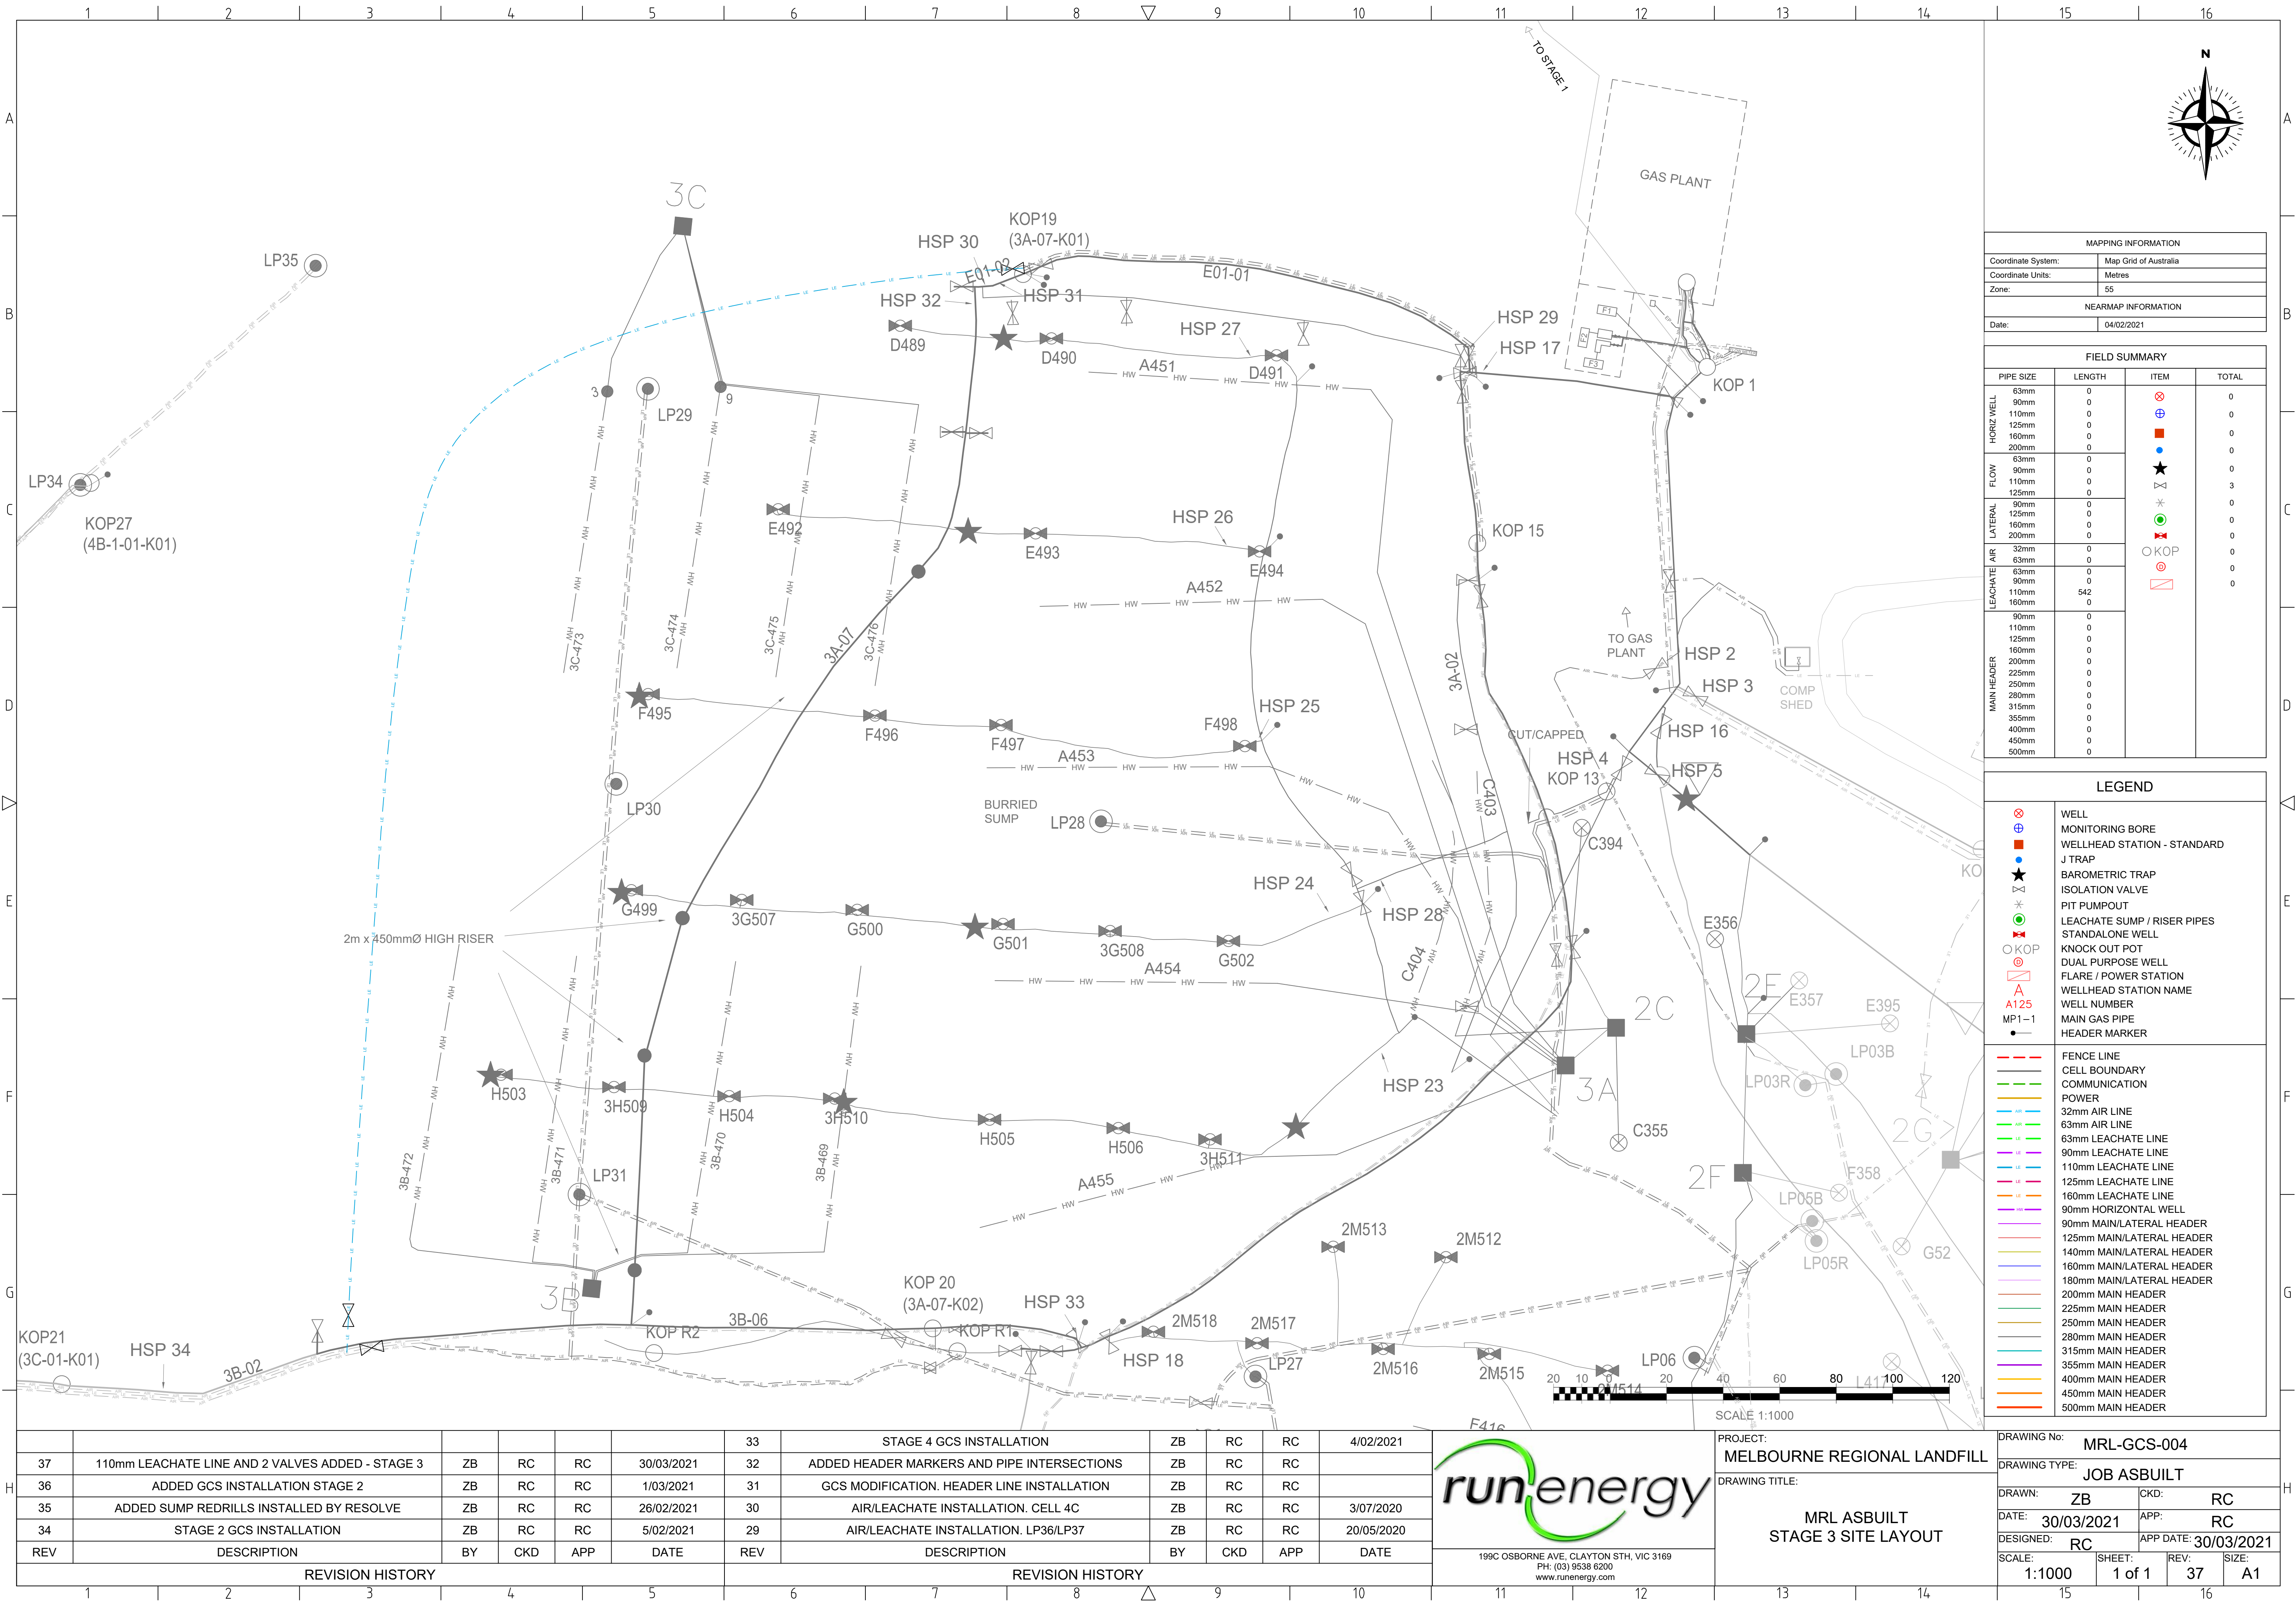

199C OSBORNE AVE, CLAYTON STH, VIC 3169  
PH: (03) 9538 6200  
www.runenergy.com

PROJECT:  
MELBOURNE REGIONAL LANDFILL

DRAWING TITLE:  
MRL ASBUILT  
STAGE 3 SITE LAYOUT

|                           |                      |         |          |
|---------------------------|----------------------|---------|----------|
| DRAWING No: MRL-GCS-004   |                      |         |          |
| DRAWING TYPE: JOB ASBUILT |                      |         |          |
| DRAWN: ZB                 | CKD: RC              |         |          |
| DATE: 30/03/2021          | APP: RC              |         |          |
| DESIGNED: RC              | APP DATE: 30/03/2021 |         |          |
| SCALE: 1:1000             | SHEET: 1 of 1        | REV: 37 | SIZE: A1 |