





41	4C-1 HORIZONTAL WELL INSTALLATION	ZB	RC	RC	10/08/2021	36	ADDED GCS INSTALLATION STAGE 2	ZB	RC	RC	1/03/2021		PROJECT: MELBOURNE REGIONAL LANDFILL DRAWING TITLE: MRL ASBUILT SITE LAYOUT	DRAWING No: MRL-GCS-001			
40	ADDED AIR RELIEF VALVES, LEACHATE LINES	ZB	RC	RC	5/05/2021	35	ADDED SUMP REDRILLS INSTALLED BY RESOLVE	ZB	RC	RC	26/02/2021			DRAWING TYPE: ASBUILT			
39	ADDED 110mm LEACHATE LINES	ZB	RC	RC	30/04/2021	34	STAGE 2 GCS INSTALLATION	ZB	RC	RC	5/02/2021			DRAWN: ZB		CKD: RC	
38	ADDED LEACHATE SUMP LP40	ZB	RC	RC	12/04/2021	33	STAGE 4 GCS INSTALLATION	ZB	RC	RC	4/02/2021			DATE: 10/08/2021		APP: RC	
37	110mm LEACHATE LINE AND 2 VALVES ADDED - STAGE 3	ZB	RC	RC	30/03/2021	32	ADDED HEADER MARKERS AND PIPE INTERSECTIONS	ZB	RC	RC				DESIGNED: RC		APP DATE: 10/08/2021	
REV	DESCRIPTION	BY	CKD	APP	DATE	REV	DESCRIPTION	BY	CKD	APP	DATE	199C OSBORNE AVE, CLAYTON STH, VIC 3169 PH: (03) 9538 6200 www.runenergy.com					
REVISION HISTORY						REVISION HISTORY											
1	2	3	4	5	6	7	8	9	10	11	12	13	14	15	16		

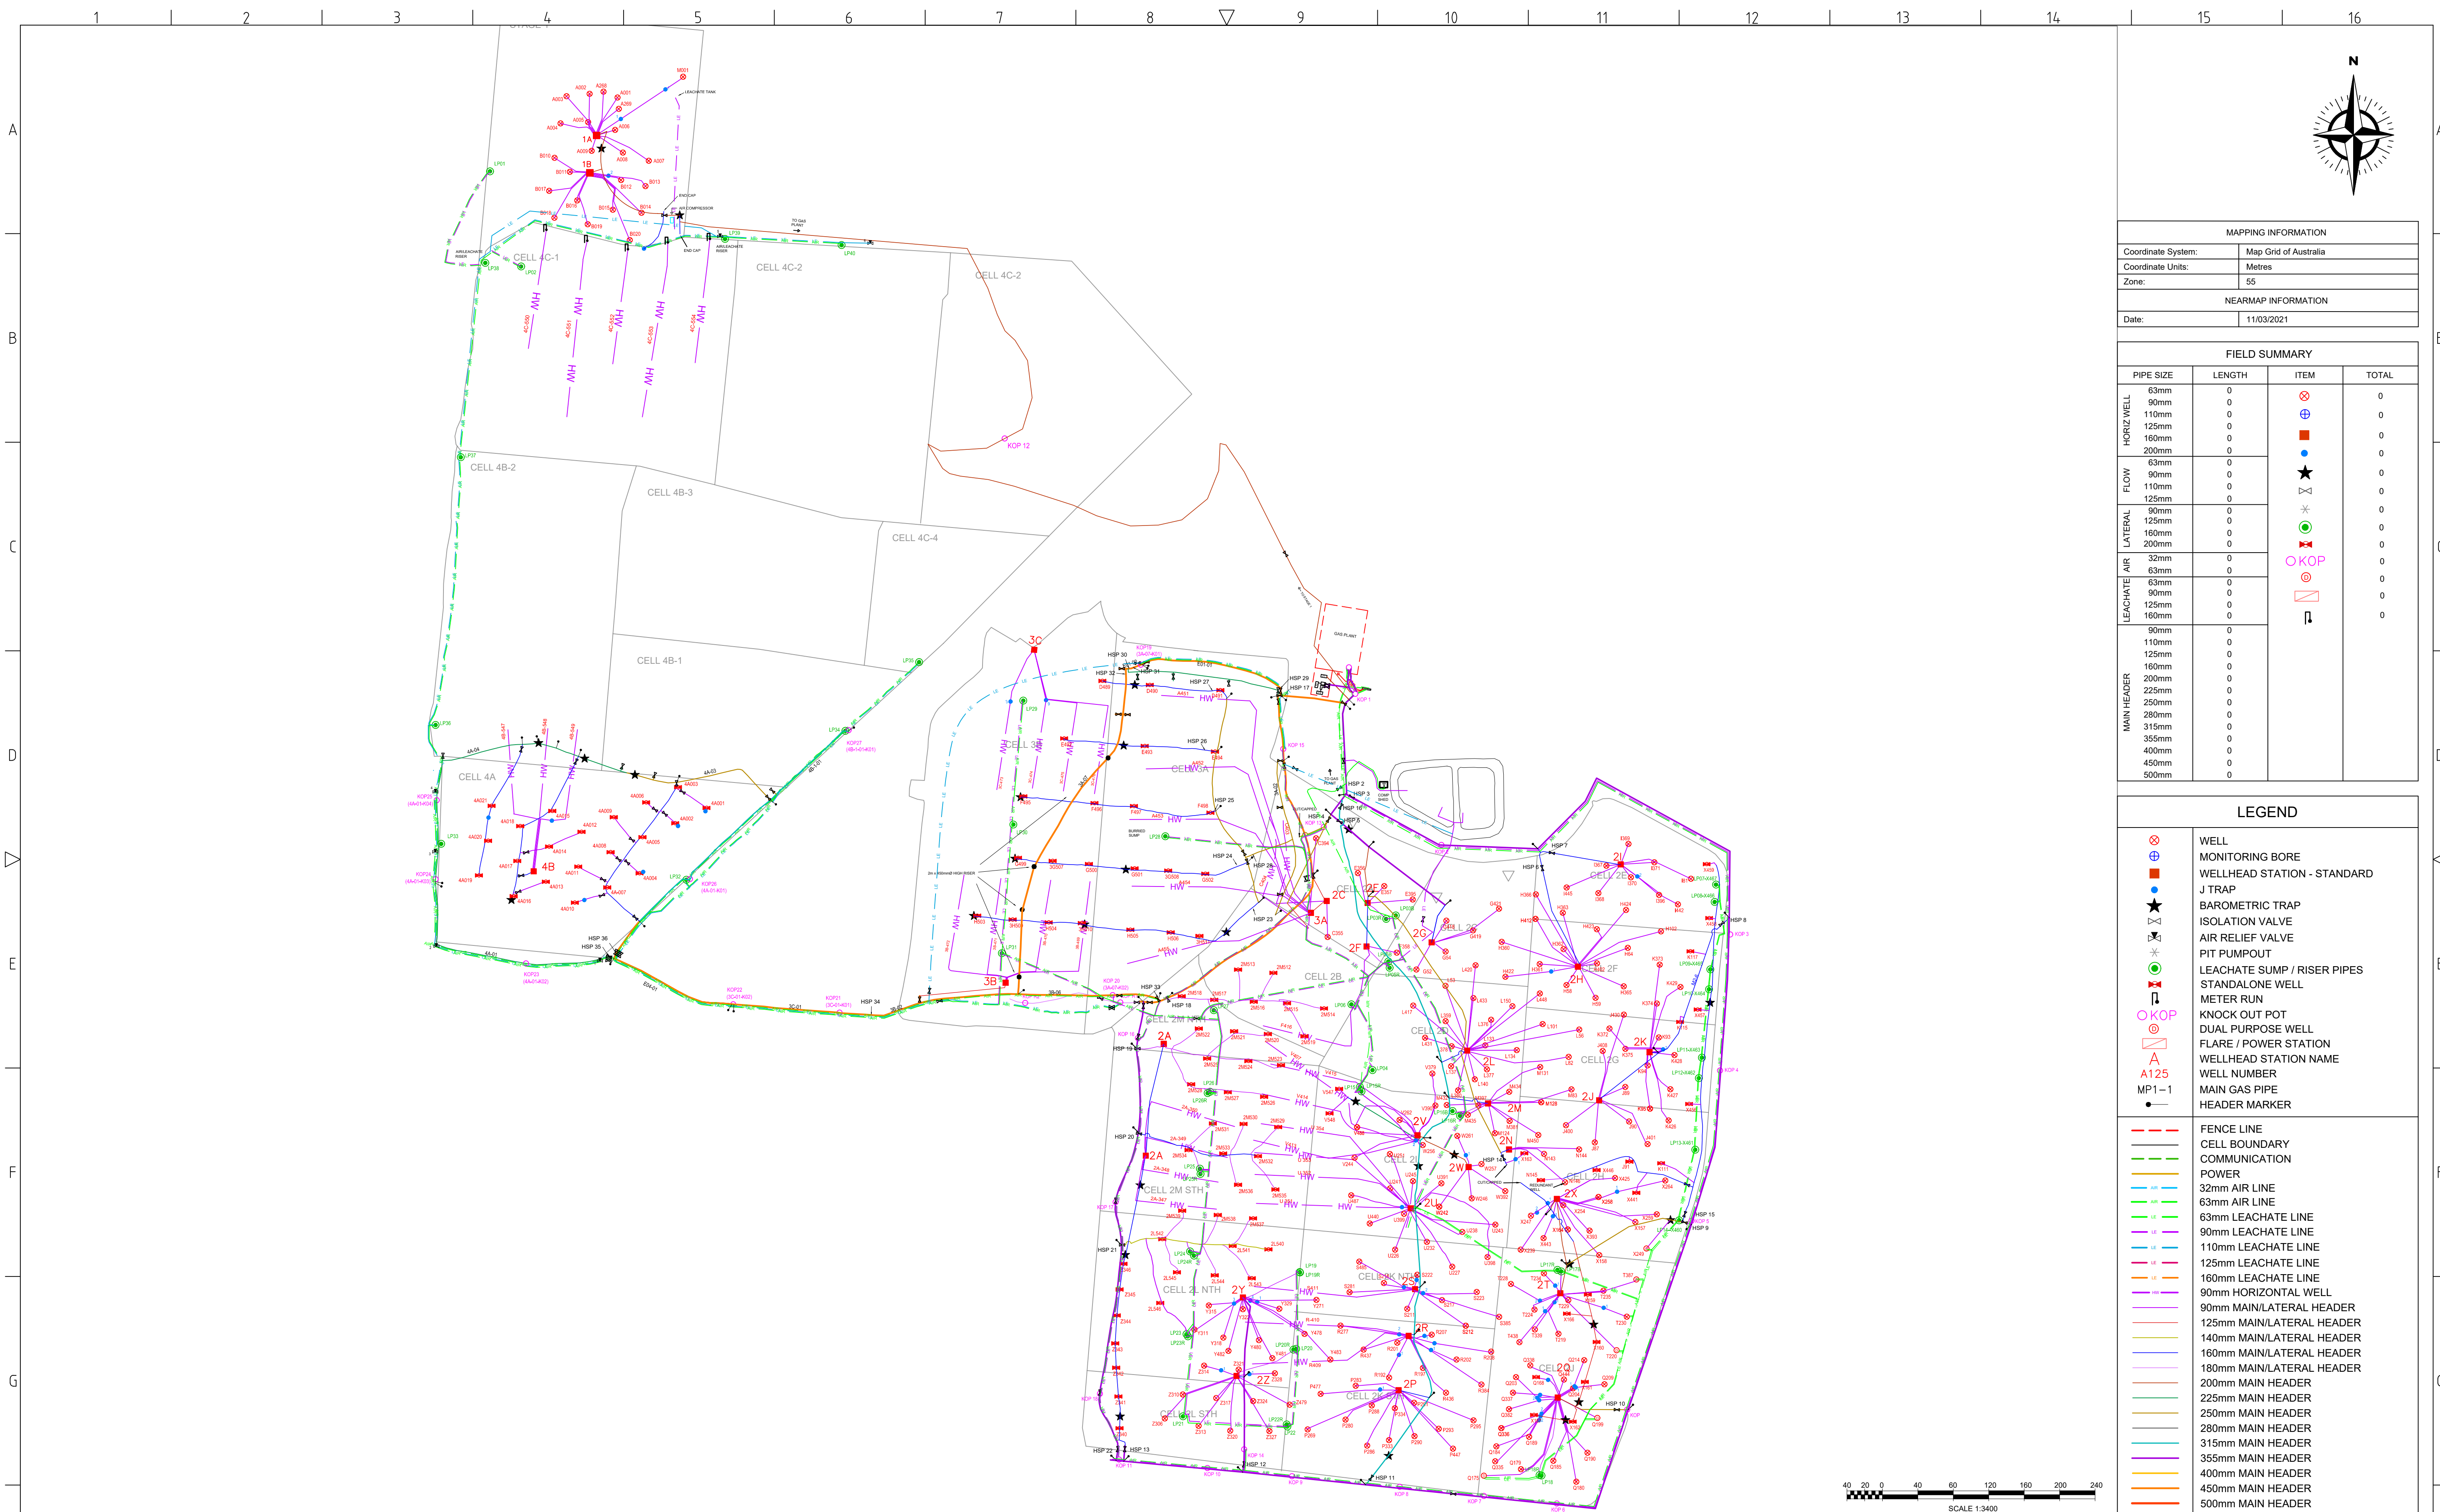


41	4C-1 HORIZONTAL WELL INSTALLATION	ZB	RC	RC	10/08/2021	36	ADDED GCS INSTALLATION STAGE 2	ZB	RC	RC	1/03/2021
40	ADDED AIR RELIEF VALVES, LEACHATE LINES	ZB	RC	RC	5/05/2021	35	ADDED SUMP REDRILLS INSTALLED BY RESOLVE	ZB	RC	RC	26/02/2021
39	ADDED 110mm LEACHATE LINES	ZB	RC	RC	30/04/2021	34	STAGE 2 GCS INSTALLATION	ZB	RC	RC	5/02/2021
38	ADDED LEACHATE SUMP LP40	ZB	RC	RC	12/04/2021	33	STAGE 4 GCS INSTALLATION	ZB	RC	RC	4/02/2021
37	110mm LEACHATE LINE AND 2 VALVES ADDED - STAGE 3	ZB	RC	RC	30/03/2021	32	ADDED HEADER MARKERS AND PIPE INTERSECTIONS	ZB	RC	RC	
REV	DESCRIPTION	BY	CKD	APP	DATE	REV	DESCRIPTION	BY	CKD	APP	DATE
REVISION HISTORY						REVISION HISTORY					

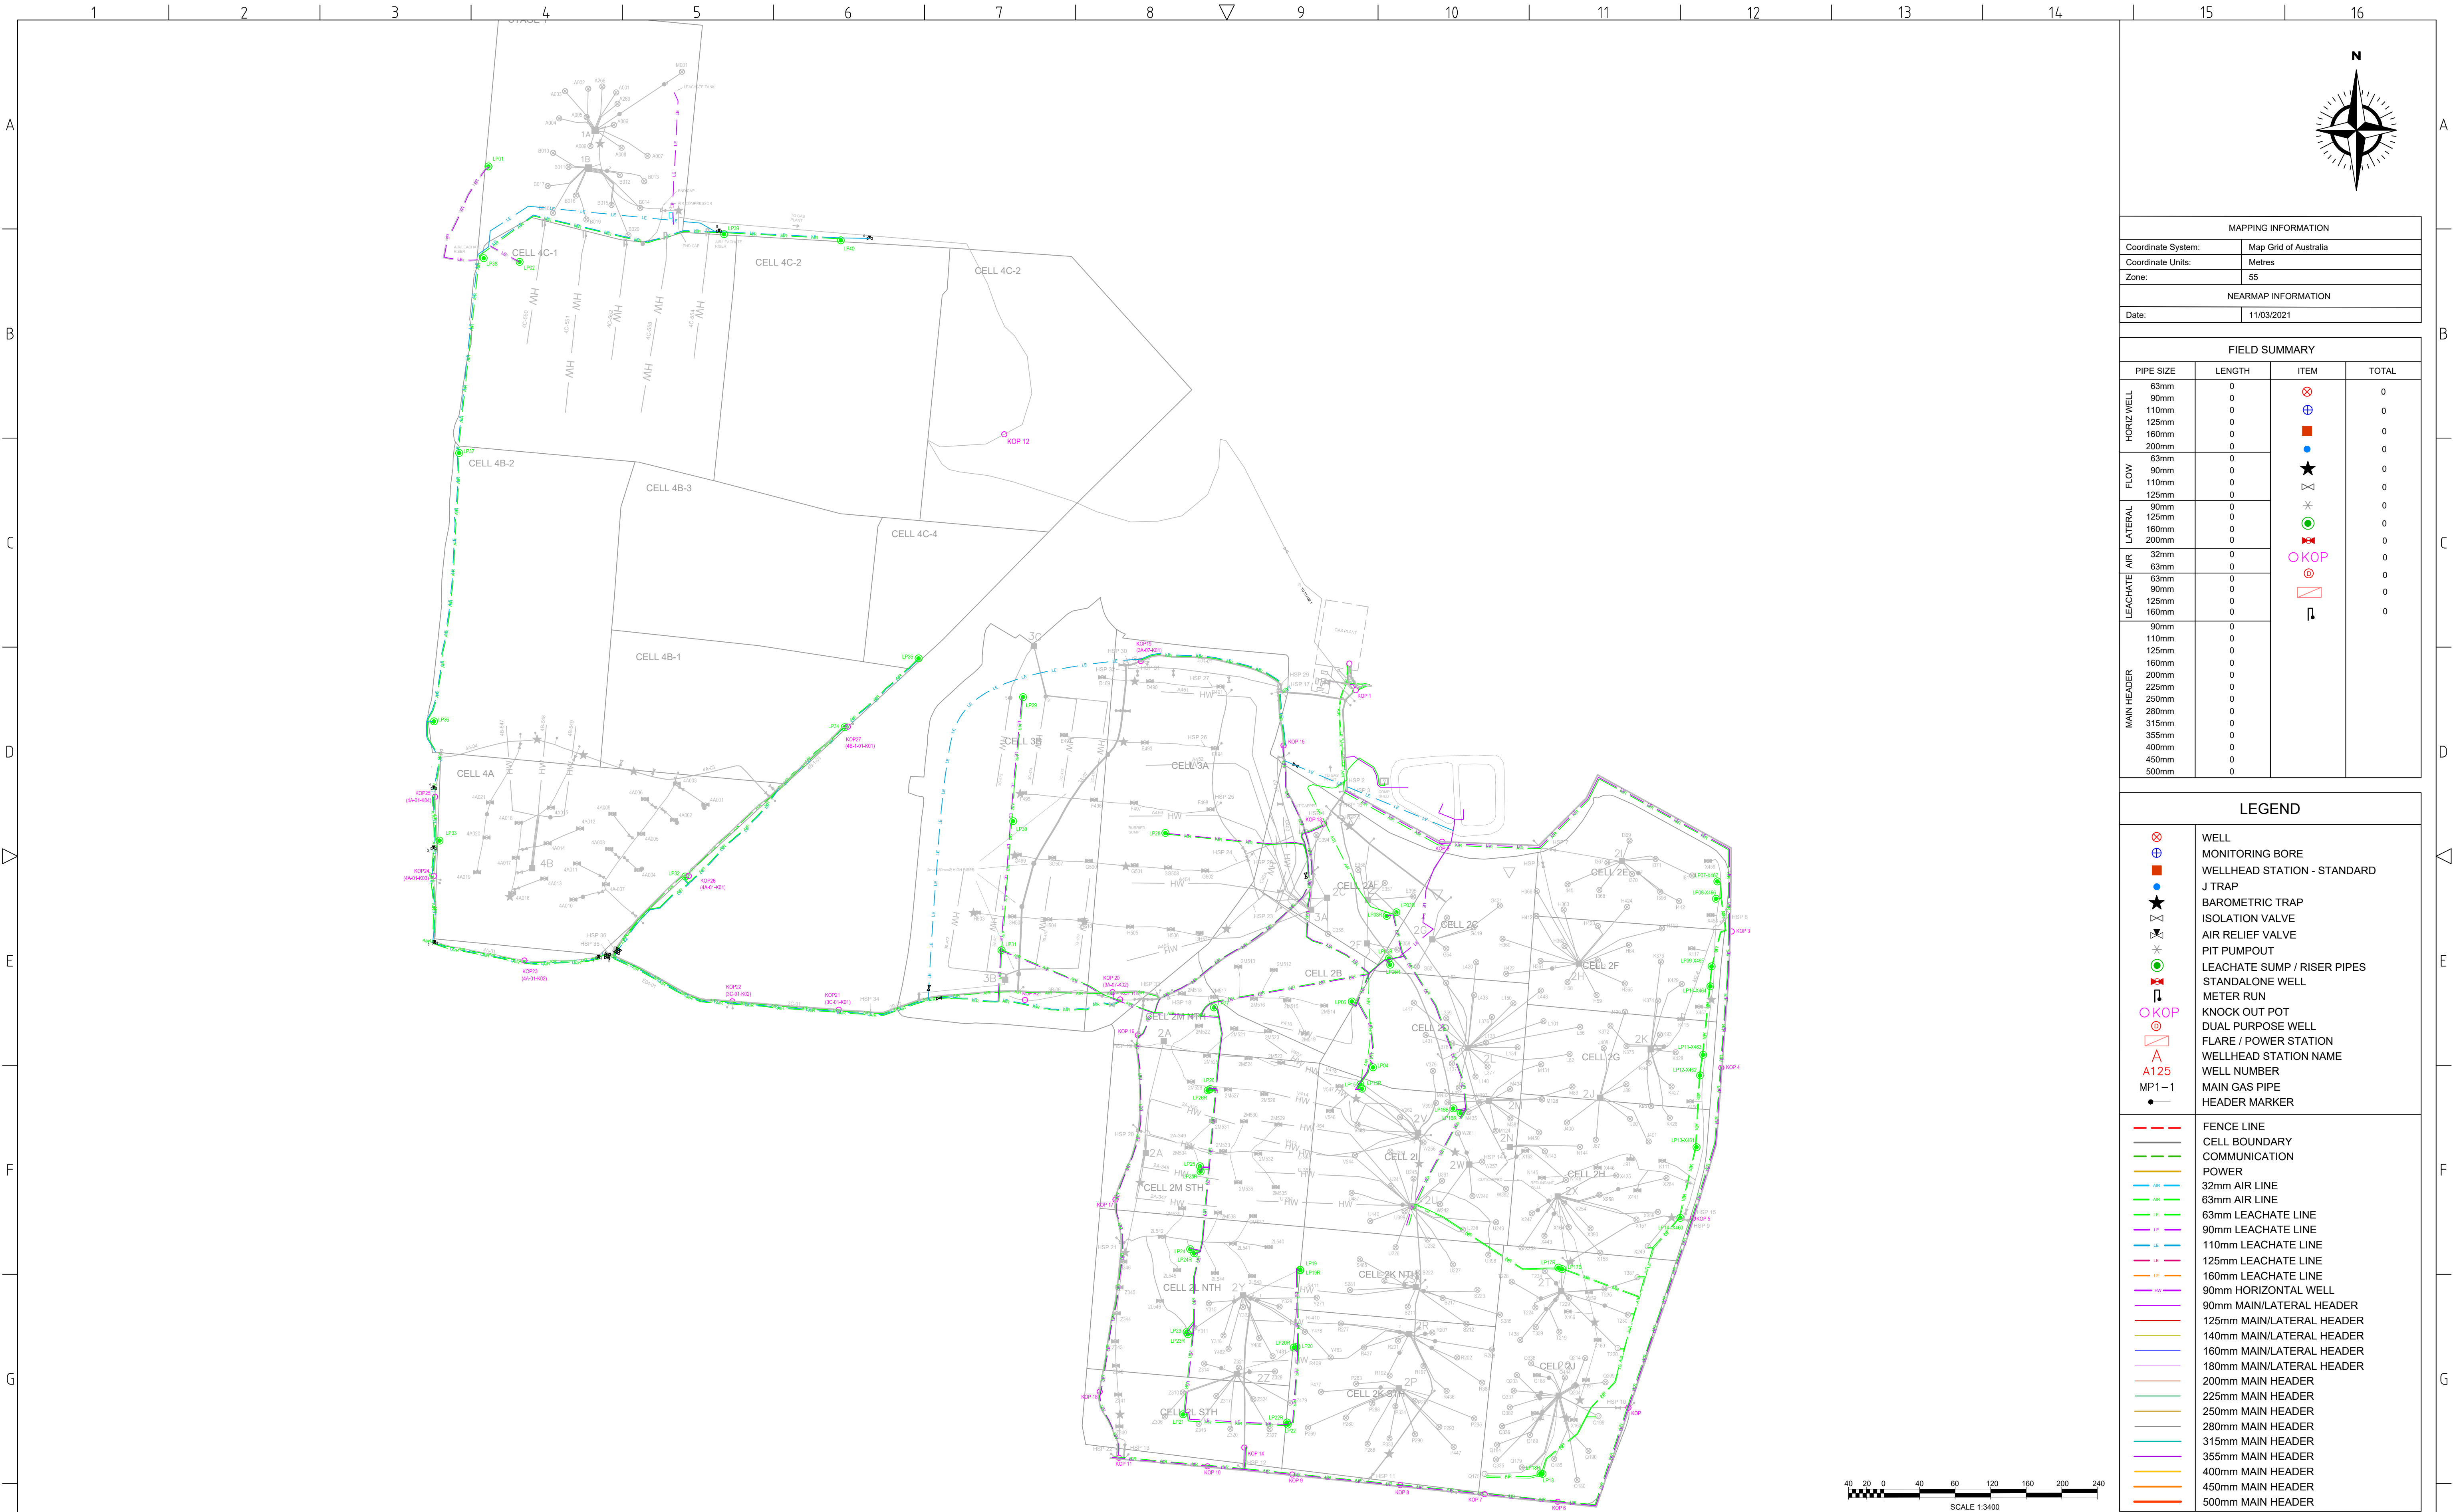


199C OSBORNE AVE, CLAYTON STH, VIC 3169
PH: (03) 9538 6200
www.runenergy.com

PROJECT:	MELBOURNE REGIONAL LANDFILL
DRAWING TITLE:	MRL-GCS_LEACHATE EXTRACTION SITE LAYOUT

DRAWING No:		MRL-GCS-001	
DRAWING TYPE:			
ASBUILT			
DRAWN:		CKD:	
ZB		RC	
DATE:		APP:	
10/08/2021		RC	
DESIGNED:		APP DATE:	
RC		10/08/2021	
SCALE:		SHEET:	REV:
1:3400		2 of 3	41
		SIZE:	A1

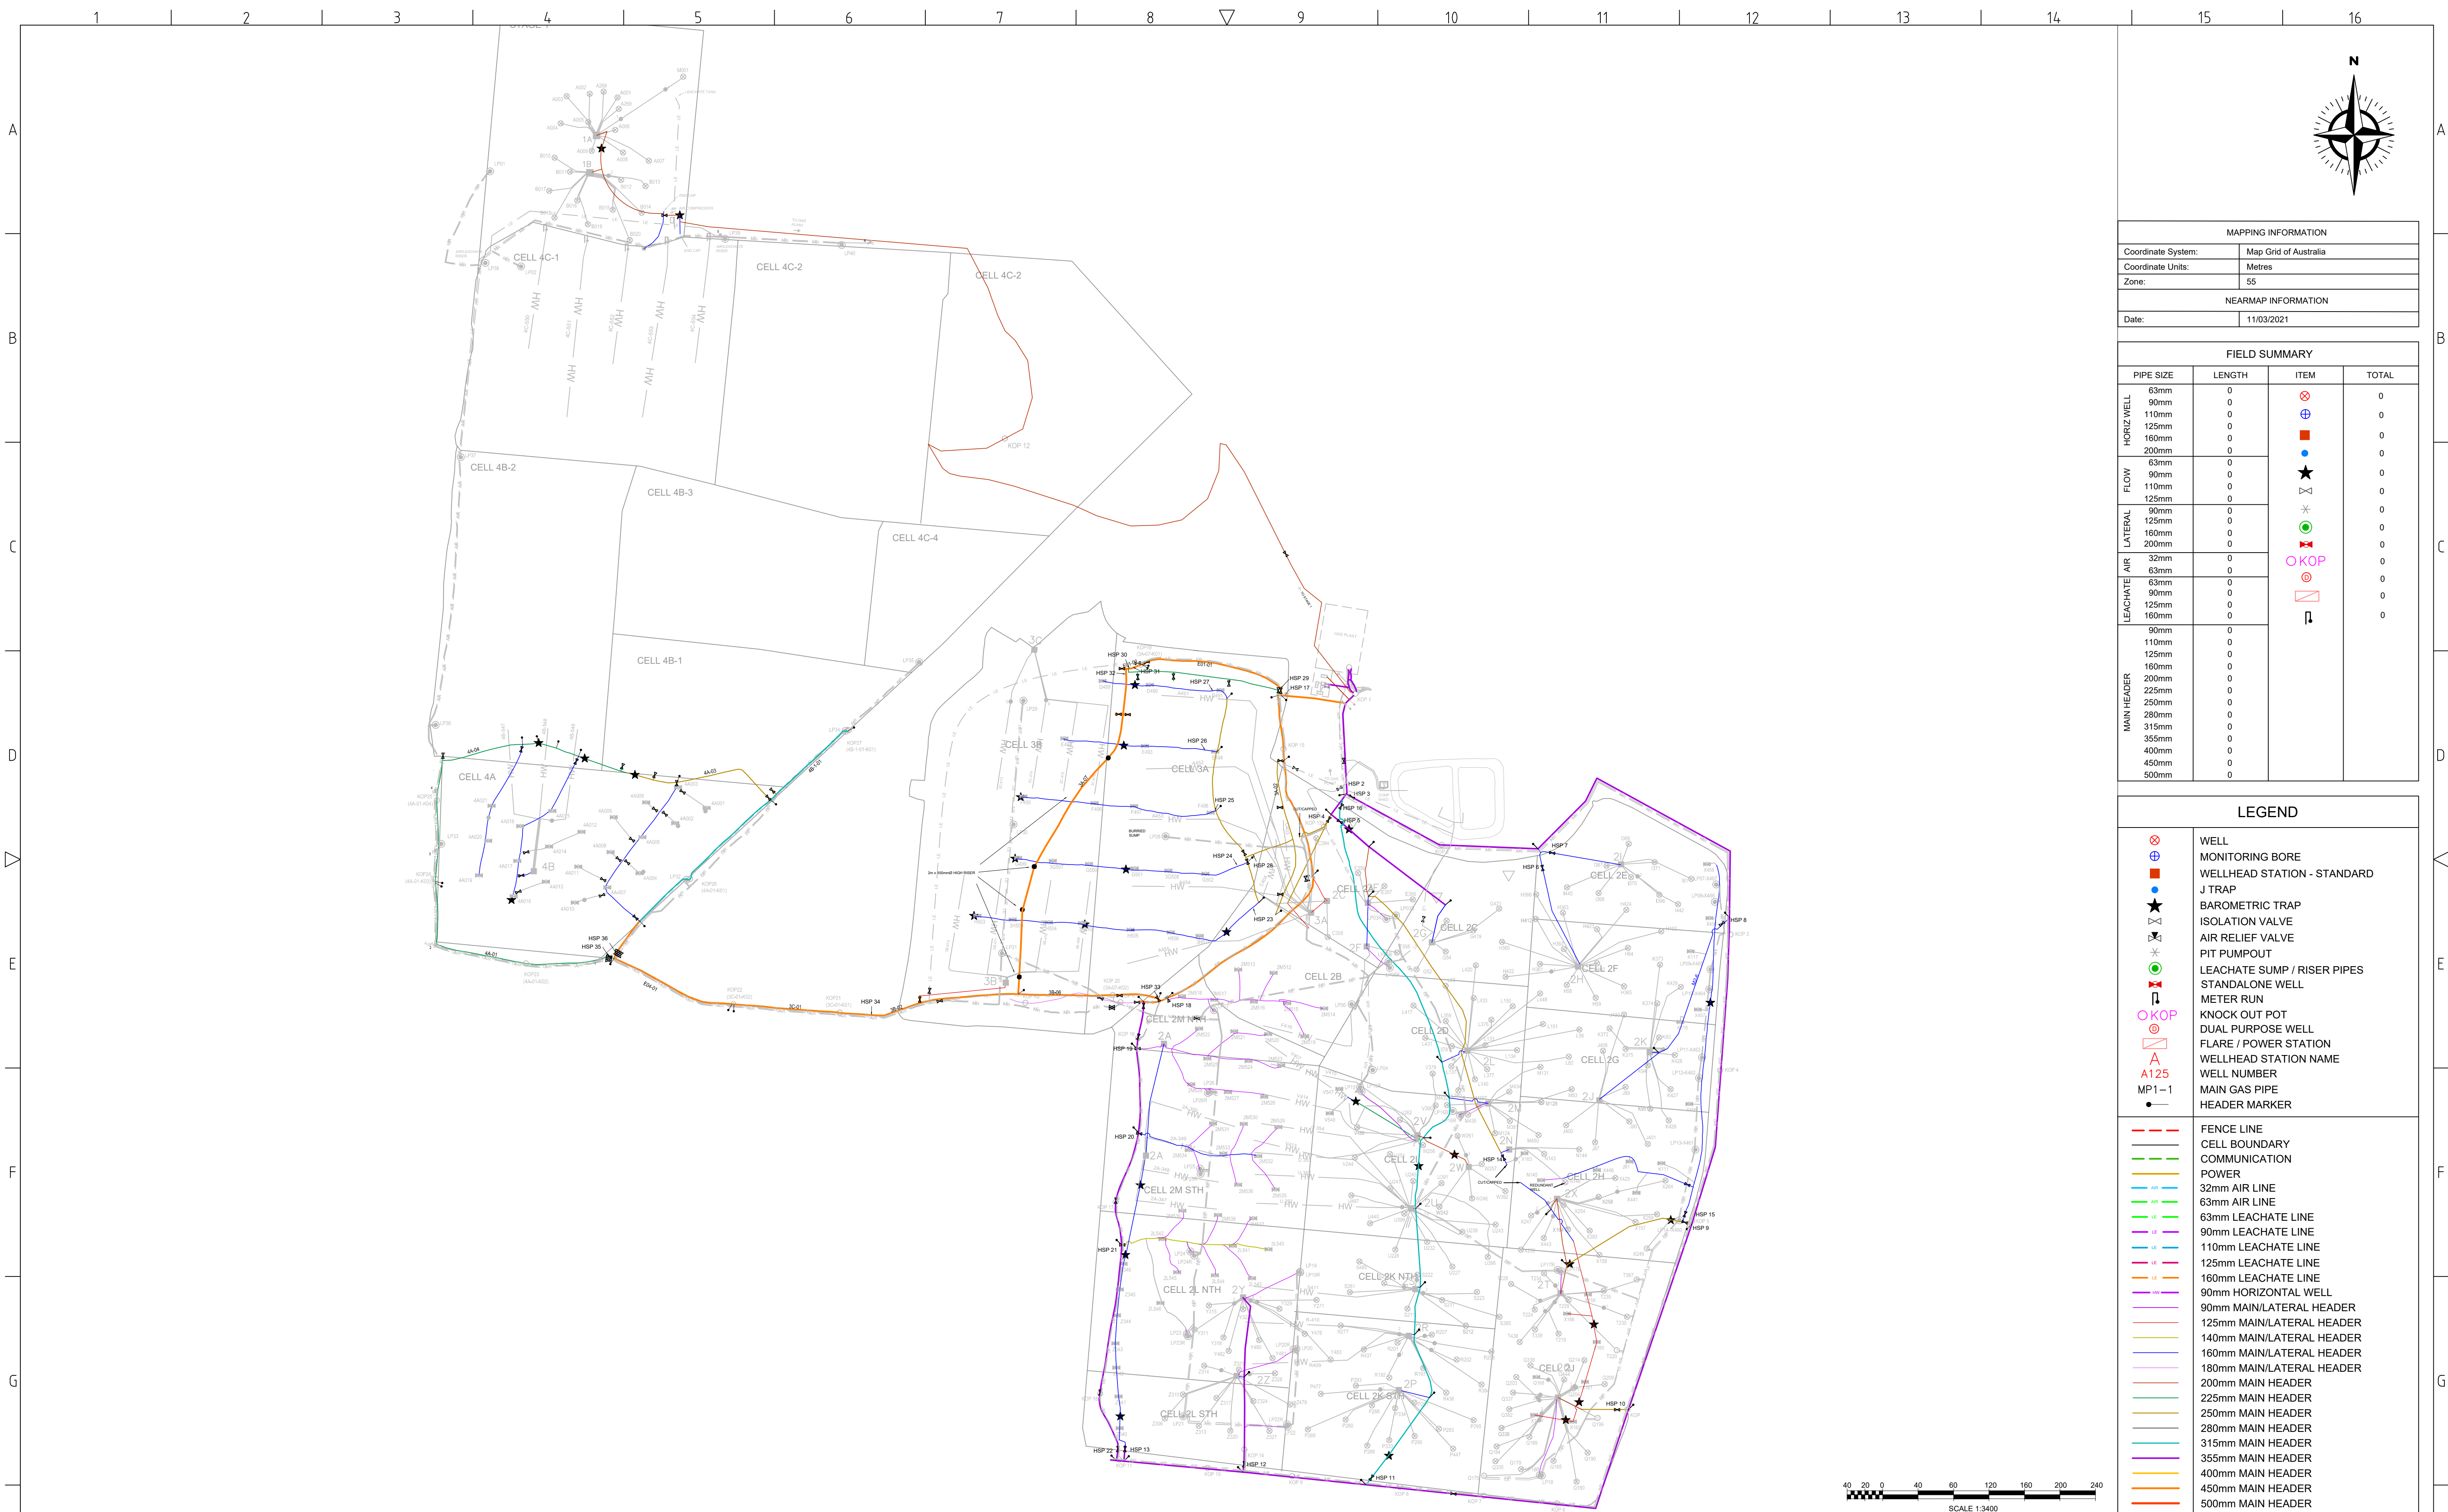

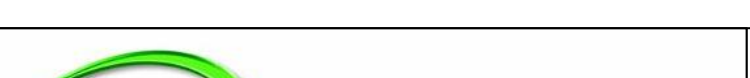H	41	4C-1 HORIZONTAL WELL INSTALLATION	ZB	RC	RC	10/08/2021	36	ADDED GCS INSTALLATION STAGE 2		ZB	RC	RC	1/03/2021		PROJECT: MELBOURNE REGIONAL LANDFILL	DRAWING No: MRL-GCS-001															
	40	ADDED AIR RELIEF VALVES, LEACHATE LINES	ZB	RC	RC	5/05/2021	35	ADDED SUMP REDRILLS INSTALLED BY RESOLVE		ZB	RC	RC	26/02/2021			DRAWING TYPE: ASBUILT															
	39	ADDED 110mm LEACHATE LINES	ZB	RC	RC	30/04/2021	34	STAGE 2 GCS INSTALLATION		ZB	RC	RC	5/02/2021			DRAWN: ZB		CKD: RC													
	38	ADDED LEACHATE SUMP LP40	ZB	RC	RC	12/04/2021	33	STAGE 4 GCS INSTALLATION		ZB	RC	RC	4/02/2021			DATE: 10/08/2021		APP: RC													
	37	110mm LEACHATE LINE AND 2 VALVES ADDED - STAGE 3	ZB	RC	RC	30/03/2021	32	ADDED HEADER MARKERS AND PIPE INTERSECTIONS		ZB	RC	RC				DESIGNED: RC		APP DATE: 10/08/2021													
	REV	DESCRIPTION	BY	CKD	APP	DATE	REV	DESCRIPTION	BY	CKD	APP	DATE	SCALE: 1:3400			SHEET: 3 of 3		REV: 41		SIZE: A1											
	REVISION HISTORY							REVISION HISTORY																							
1		2		3		4		5		6		7		8		9		10		11		12		13		14		15		16	

run-energy

199C OSBORNE AVE, CLAYTON STH, VIC 3169
PH: (03) 9538 6200
www.runenergy.com

MRL-GCS MAIN HEADERS
SITE LAYOUT