




NEARMAP IMAGE FROM AUG 21, 2022			
MAP GRID		MGA 56	
FIELD SUMMARY			
PIPE SIZE	LENGTH	ITEM	TOTAL
HORIZ WELL	63mm	⊗	0
	90mm	⊕	0
	110mm	⊙	0
	125mm	⊛	0
	160mm	⊞	0
FLOW	200mm	●	0
	63mm	★	0
	90mm	⚡	0
	110mm	⚡	0
LATERAL	125mm	✱	0
	90mm	⊙	1
	125mm	⊛	0
	160mm	⊞	0
AIR	200mm	⊛	0
	32mm	⊙	0
	63mm	13	0
	LEACHATE	63mm	⊙
90mm		⊙	0
125mm		⊙	0
160mm		⊙	0
90mm		⊙	0
110mm		⊙	0
125mm		⊙	0
160mm		⊙	0
200mm		⊙	0
225mm		⊙	0
250mm		⊙	0
280mm		⊙	0
315mm		⊙	0
355mm		⊙	0
400mm	⊙	0	
450mm	⊙	0	
500mm	⊙	1	

LEGEND	
⊗	WELL
⊕	MONITORING BORE
⊙	WELLHEAD STATION - STANDARD
●	J TRAP
★	BAROMETRIC TRAP
⚡	ISOLATION VALVE
✱	PIT PUMPOUT
⊙	LEACHATE SUMP / RISER PIPES
⊛	STANDALONE WELL
⊞	KNOCKOUT POT
⊙	DUAL PURPOSE WELL
⊙	FLARE/POWER STATION
⊙	WELLHEAD STATION NAME
A125	WELL NUMBER
MP1-1	MAIN GAS PIPE
⊙	GAS MONITORING BORE
⊙	LEACHATE RISER
⊙	METER RUN
---	FENCE LINE
---	CELL BOUNDARY
---	COMMUNICATION
---	POWER
---	63mm FLOW LINE
---	32mm AIR LINE
---	63mm AIR LINE
---	63mm LEACHATE LINE
---	90mm LEACHATE LINE
---	125mm LEACHATE LINE
---	160mm LEACHATE LINE
---	90mm HORIZONTAL WELL
---	90mm MAIN LATERAL HEADER
---	125mm MAIN/LATERAL HEADER
---	160mm MAIN HEADER
---	200mm MAIN HEADER
---	225mm MAIN HEADER
---	250mm MAIN HEADER
---	280mm MAIN HEADER
---	315mm MAIN HEADER
---	355mm MAIN HEADER
---	400mm MAIN HEADER
---	450mm MAIN HEADER
---	500mm MAIN HEADER

						11	90MM LEACHATE LINE INSTALLED FROM LP003 TO TANKS	ZB	RC	RC	19/10/2020
						10	SOUTHERN MAIN HEADER RELOCATED.	ZB	RC	RC	17/11/2020
						9	REVISED RING MAIN HEADER LOCATION	ZB	AD	AD	17/09/2020
13	ADDED LP04, 90mm FLOW LINE, LEACHATE DISCHARGE, DATA	ZB	RB	RB	05/09/2022	8	ADDED AUSTRAL HEADER LINE	ZB	AD	AD	25/08/2020
12	GCS INSTALLATION AUSTRAL HEADER LINE	ZB	RB	RB	24/12/2020	7	REVISED WELL ID LP001. CHANGED TO LP003	ZB	AD	AD	17/08/2020
REV	DESCRIPTION	BY	CKD	APP	DATE	REV	DESCRIPTION	BY	CKD	APP	DATE
REVISION HISTORY						REVISION HISTORY					

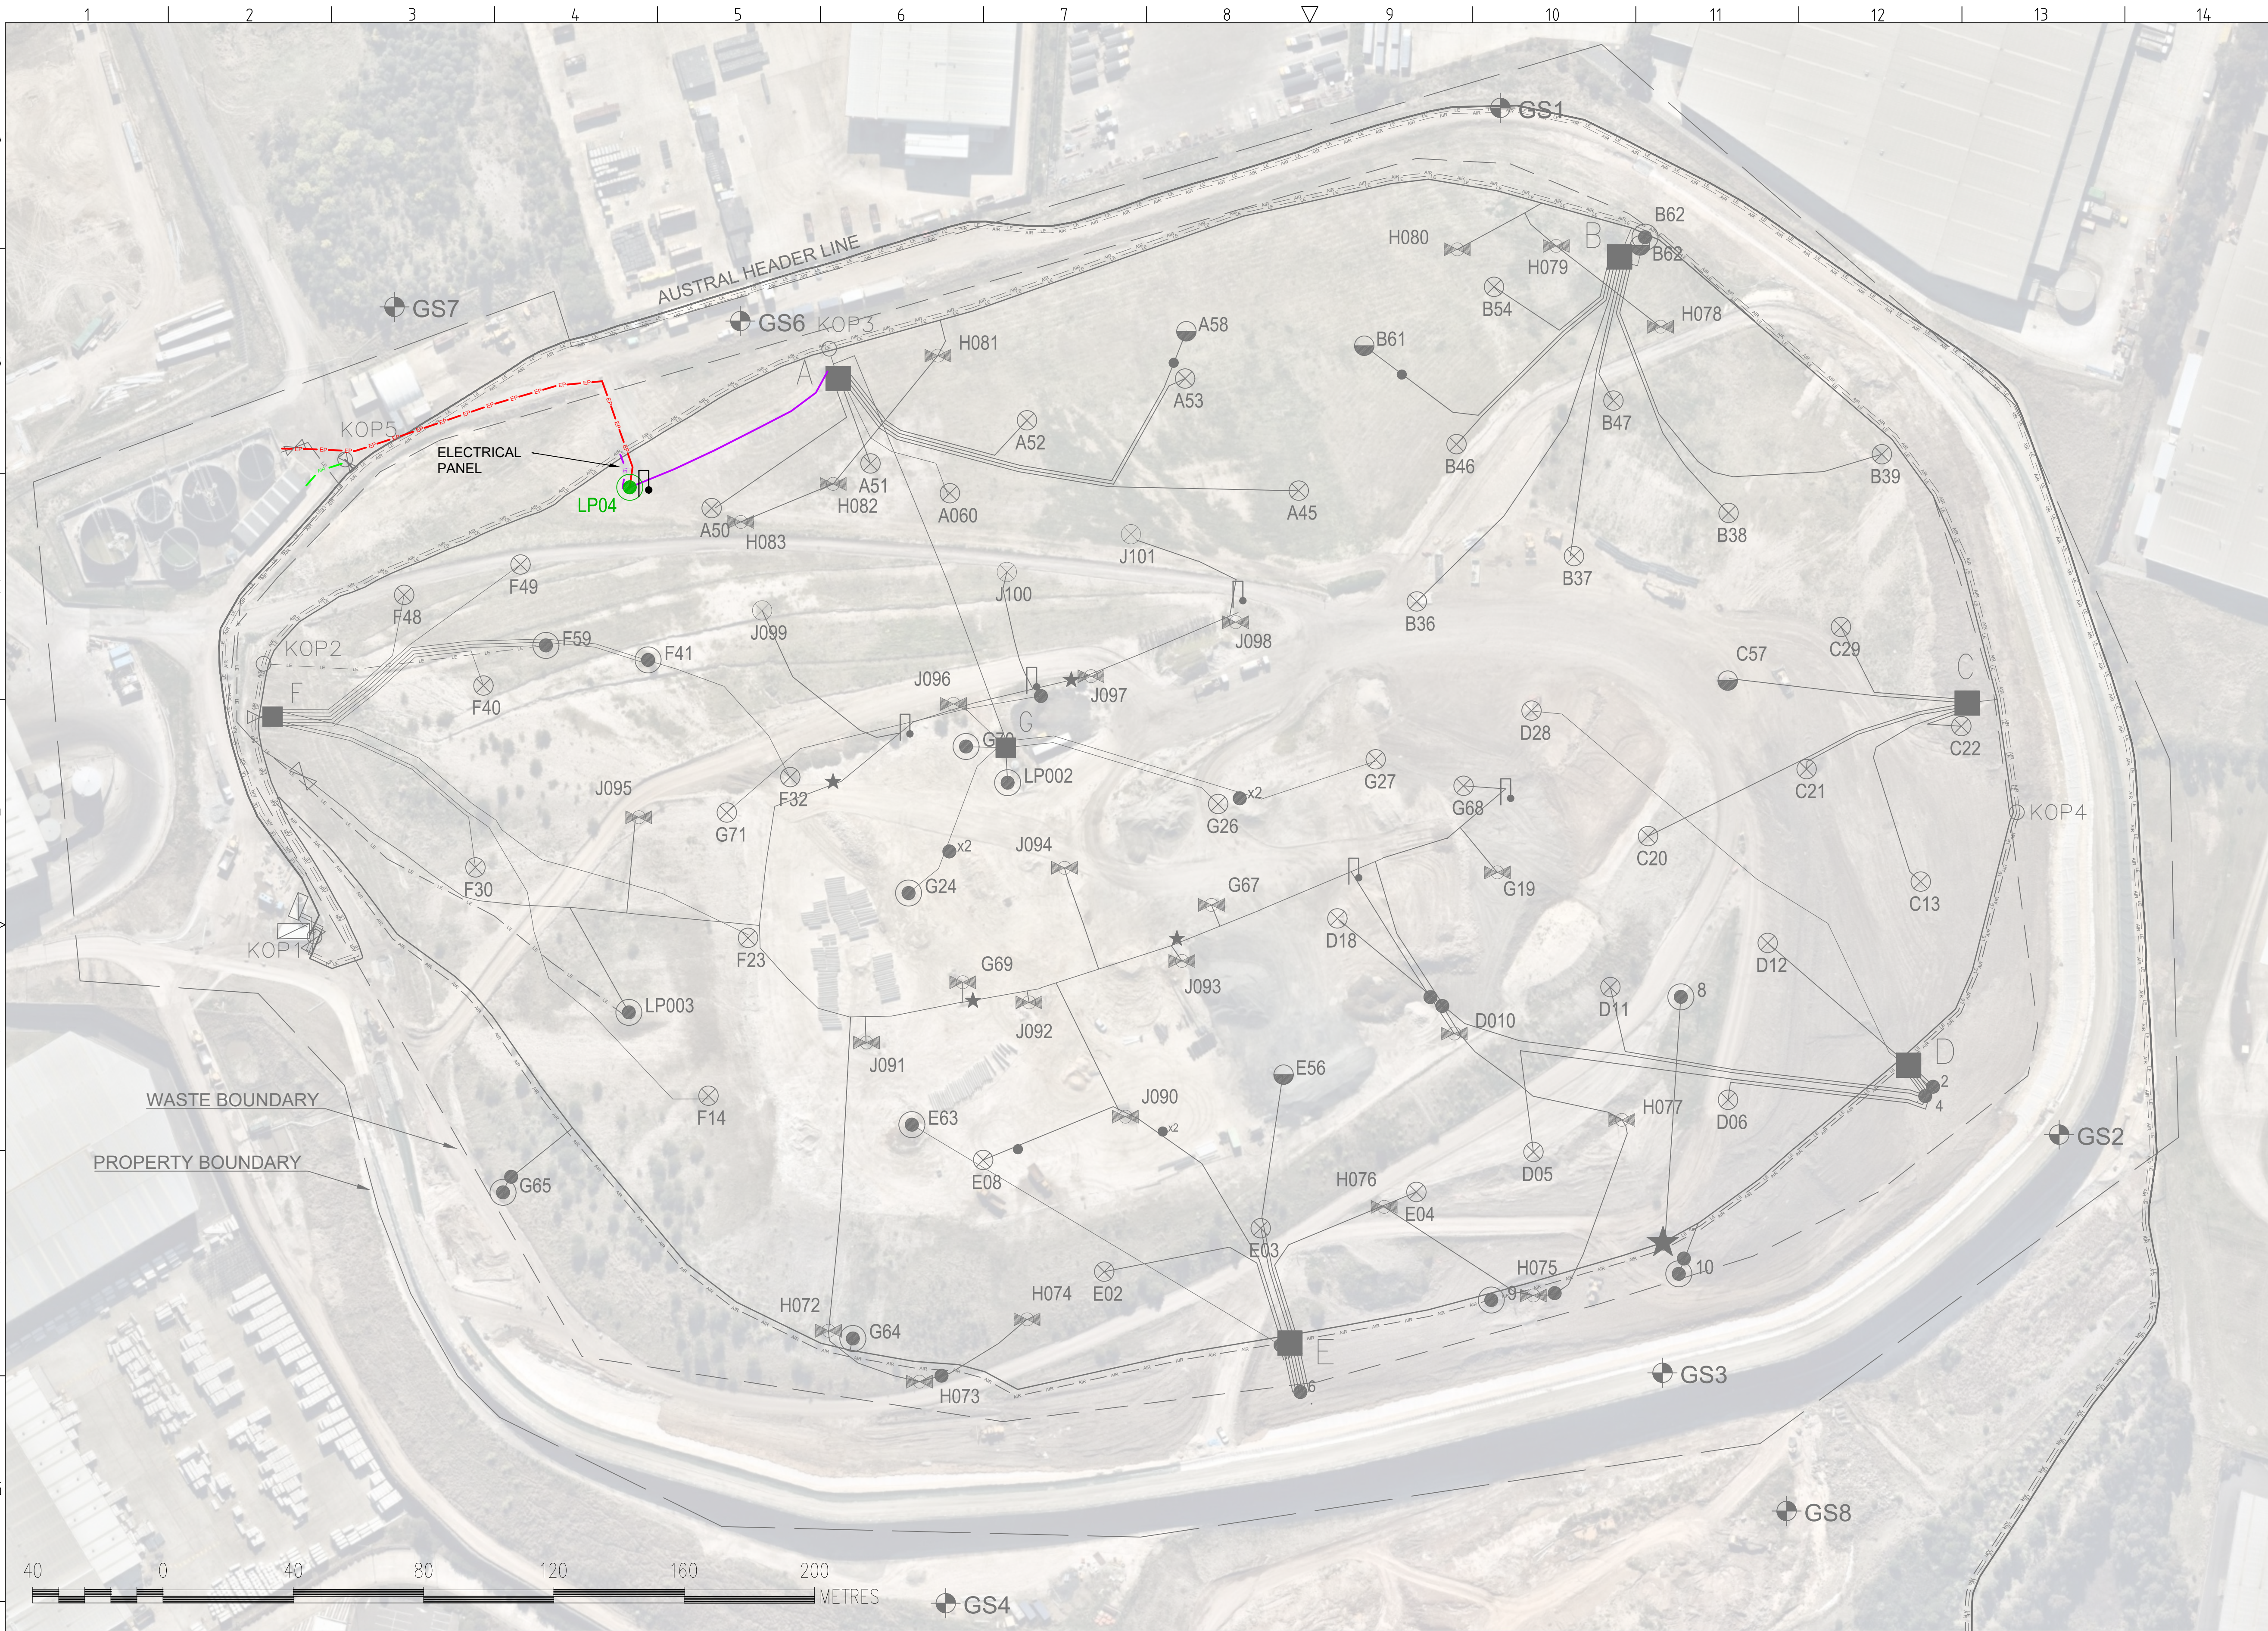

199C OSBORNE AVE, CLAYTON STH, VIC 3169
PH: (03) 9538 6200
www.runenergy.com

PROJECT:	ERSKINE PARK LANDFILL GAS PROJECT
DRAWING TITLE:	GAS COLLECTION SYSTEM INSTALLATION

DRAWING No:		RE-ERSKINE-001	
DRAWING TYPE:		JOB ASBUILT	
DRAWN: ZB		CKD: RC	
DATE: 05/09/2022		APP: RC	
DESIGNED: RC		APP DATE: 05/09/2022	
SCALE: 1:1000	SHEET: 1 of 1	REV: 13	SIZE: A1