


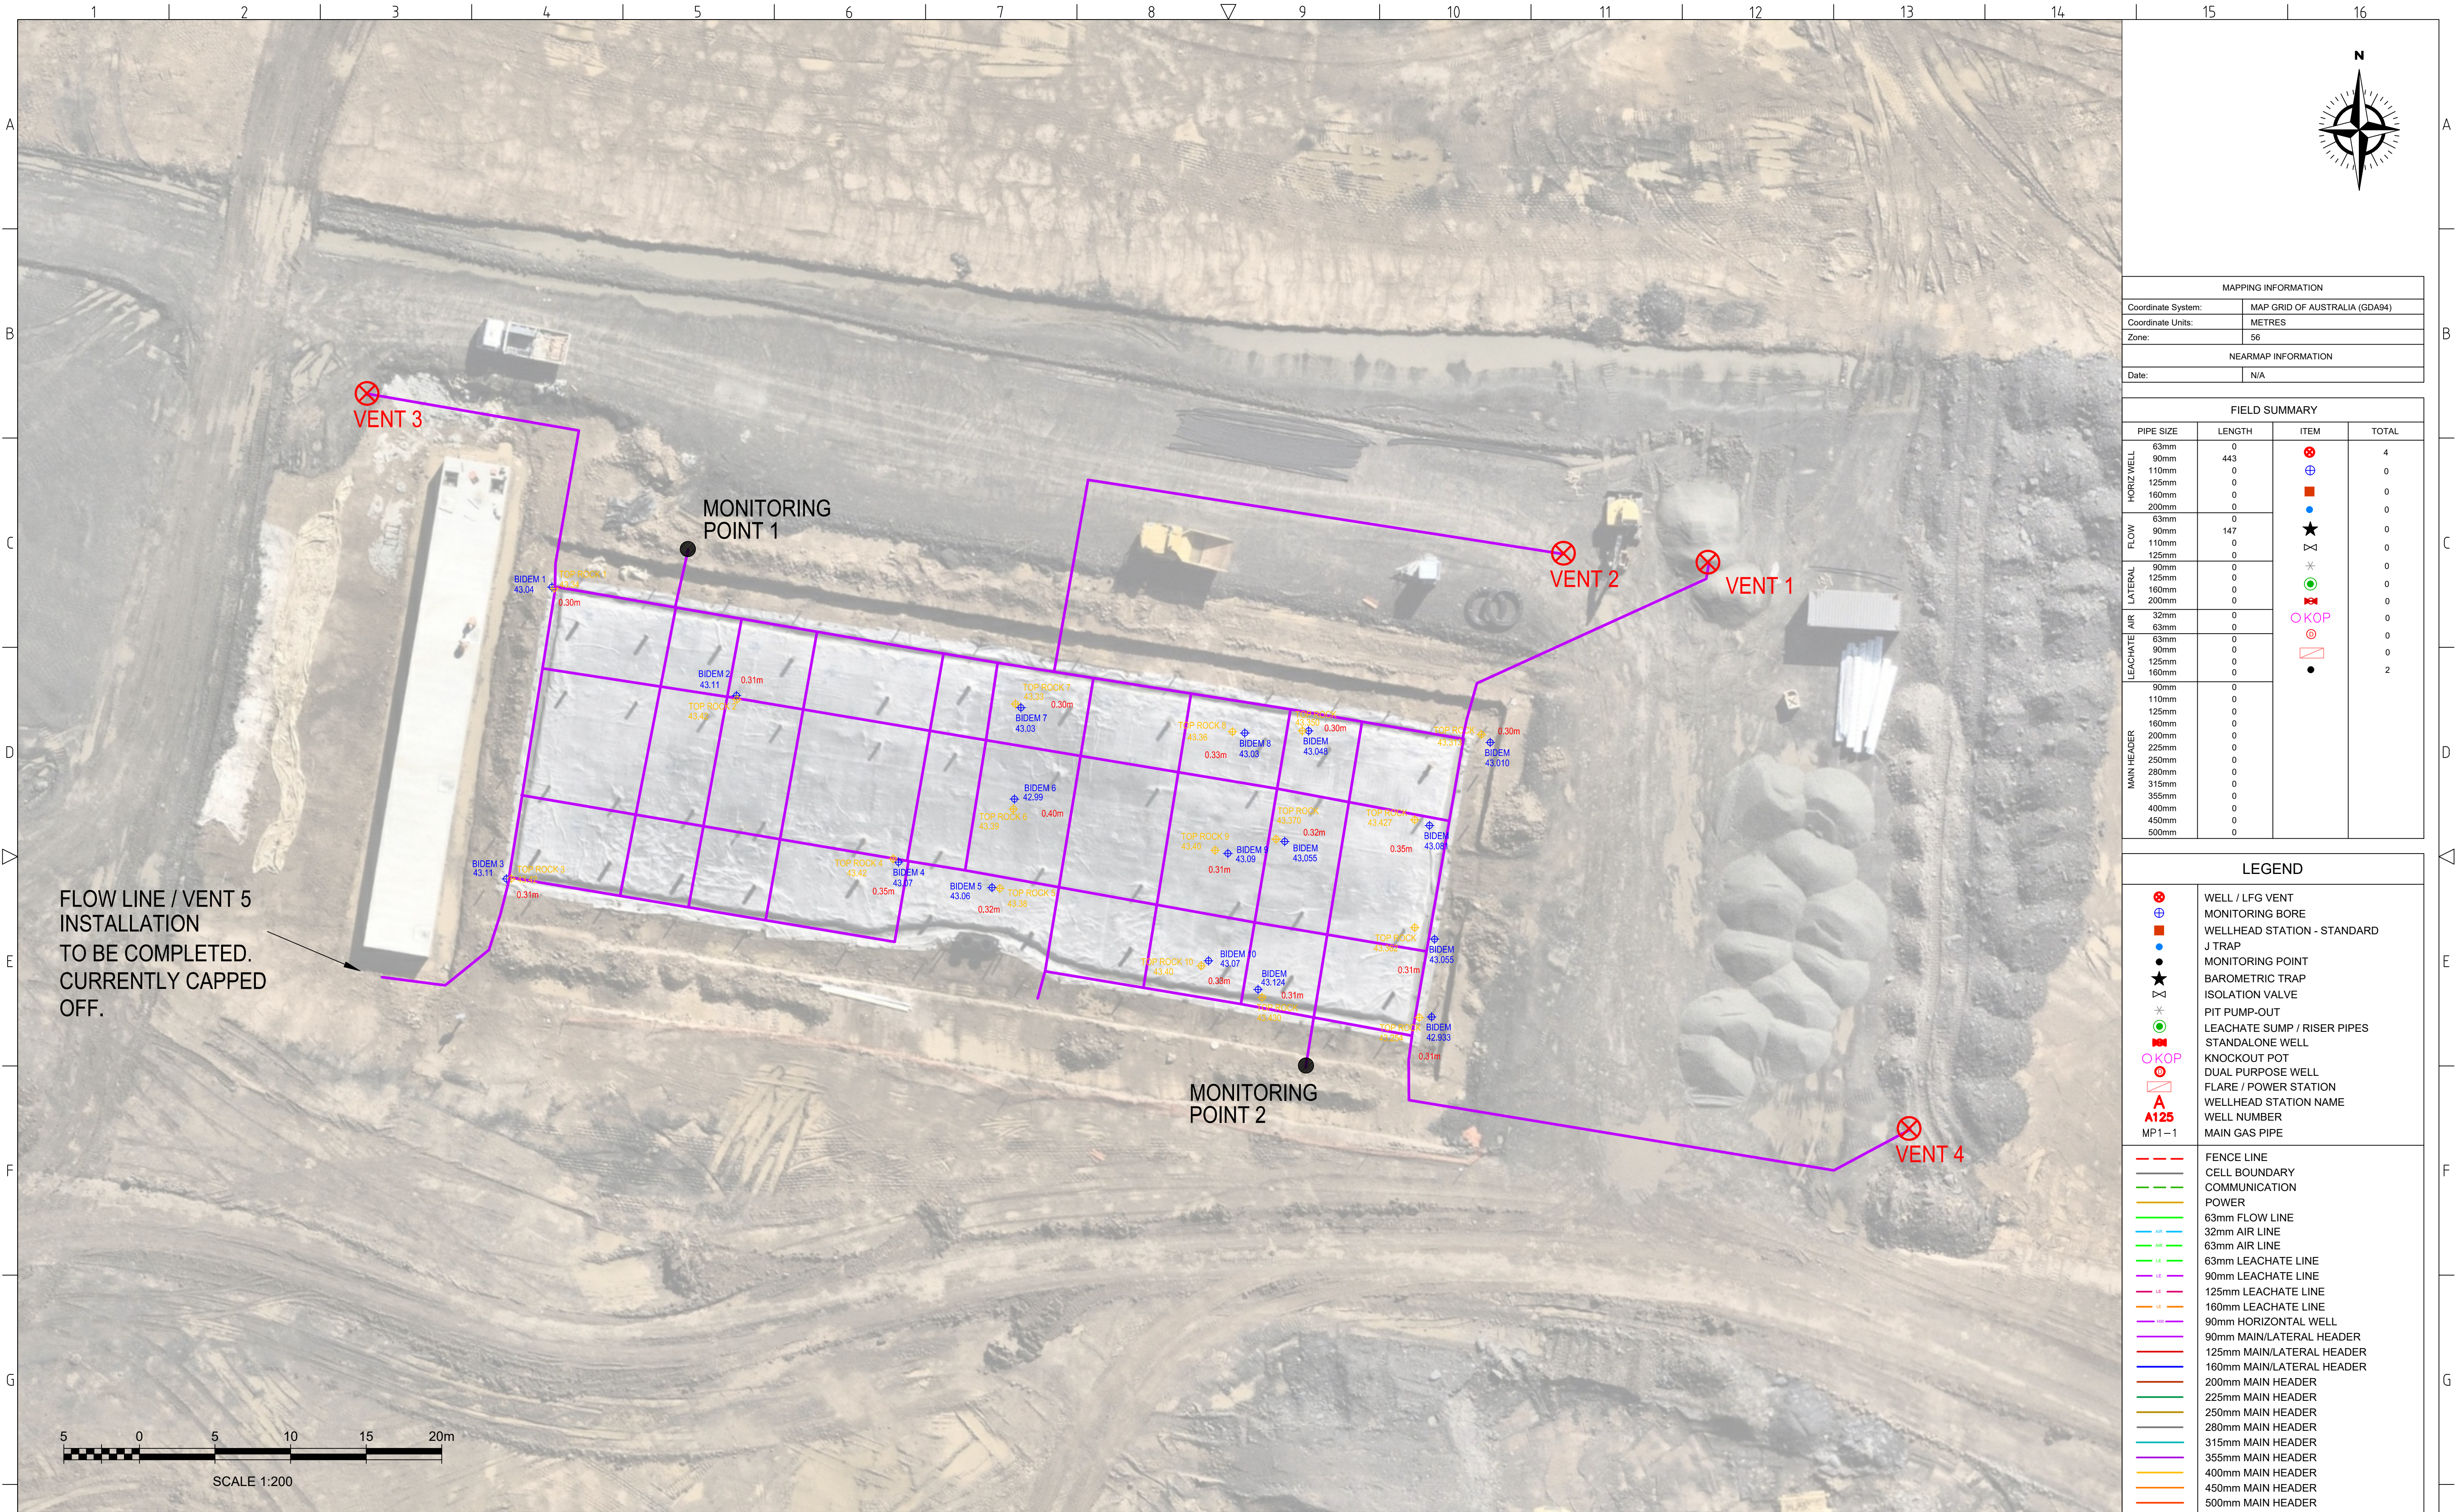

MAPPING INFORMATION	
Coordinate System:	MAP GRID OF AUSTRALIA (GDA94)
Coordinate Units:	METRES
Zone:	56
NEARMAP INFORMATION	
Date:	N/A

FIELD SUMMARY			
PIPE SIZE	LENGTH	ITEM	TOTAL
HORIZ WEL	63mm	0	4
	90mm	443	0
	110mm	0	0
	125mm	0	0
	160mm	0	0
FLOW	63mm	0	0
	90mm	147	0
	110mm	0	0
	125mm	0	0
	160mm	0	0
LATERAL	90mm	0	0
	125mm	0	0
	160mm	0	0
	200mm	0	0
	250mm	0	0
LEACHATE	32mm	0	0
	63mm	0	0
	90mm	0	0
	125mm	0	0
	160mm	0	2
MAIN HEADER	90mm	0	0
	110mm	0	0
	125mm	0	0
	160mm	0	0
	200mm	0	0
	225mm	0	0
	250mm	0	0
	280mm	0	0
	315mm	0	0
	355mm	0	0
	400mm	0	0
	450mm	0	0
	500mm	0	0

LEGEND	
	WELL / LFG VENT
	MONITORING BORE
	WELLHEAD STATION - STANDARD
	J TRAP
	MONITORING POINT
	BAROMETRIC TRAP
	ISOLATION VALVE
	PIT PUMP-OUT
	LEACHATE SUMP / RISER PIPES
	STANDALONE WELL
	KNOCKOUT POT
	DUAL PURPOSE WELL
	FLARE / POWER STATION
	WELLHEAD STATION NAME
	WELL NUMBER
	MP1-1

	FENCE LINE
	CELL BOUNDARY
	COMMUNICATION
	POWER
	63mm FLOW LINE
	32mm AIR LINE
	63mm AIR LINE
	63mm LEACHATE LINE
	90mm LEACHATE LINE
	125mm LEACHATE LINE
	160mm LEACHATE LINE
	90mm HORIZONTAL WELL
	90mm MAIN/LATERAL HEADER
	125mm MAIN/LATERAL HEADER
	160mm MAIN/LATERAL HEADER
	200mm MAIN HEADER
	225mm MAIN HEADER
	250mm MAIN HEADER
	280mm MAIN HEADER
	315mm MAIN HEADER
	355mm MAIN HEADER
	400mm MAIN HEADER
	450mm MAIN HEADER
	500mm MAIN HEADER

A	GCS INSTALLATION	ZB	RC	RC	5/06/2023
REV	DESCRIPTION	BY	CKD	APP	DATE
REVISION HISTORY					

199C OSBORNE AVE, CLAYTON STH, VIC 3169
PH: (03) 9538 6200
www.runenergy.com

PROJECT:	GIPPS STREET
DRAWING TITLE:	GAS COLLECTION SYSTEM SITE LAYOUT

DRAWING No:		079-AB-001	
DRAWING TYPE:			
AS BUILT			
DRAWN:		CKD:	
ZB		RC	
DATE:		APP:	
05/06/2023		RC	
DESIGNED:		APP DATE:	
RC		05/06/2023	
SCALE:	SHEET:	REV:	SIZE:
1:200	1 of 1	A	A1