


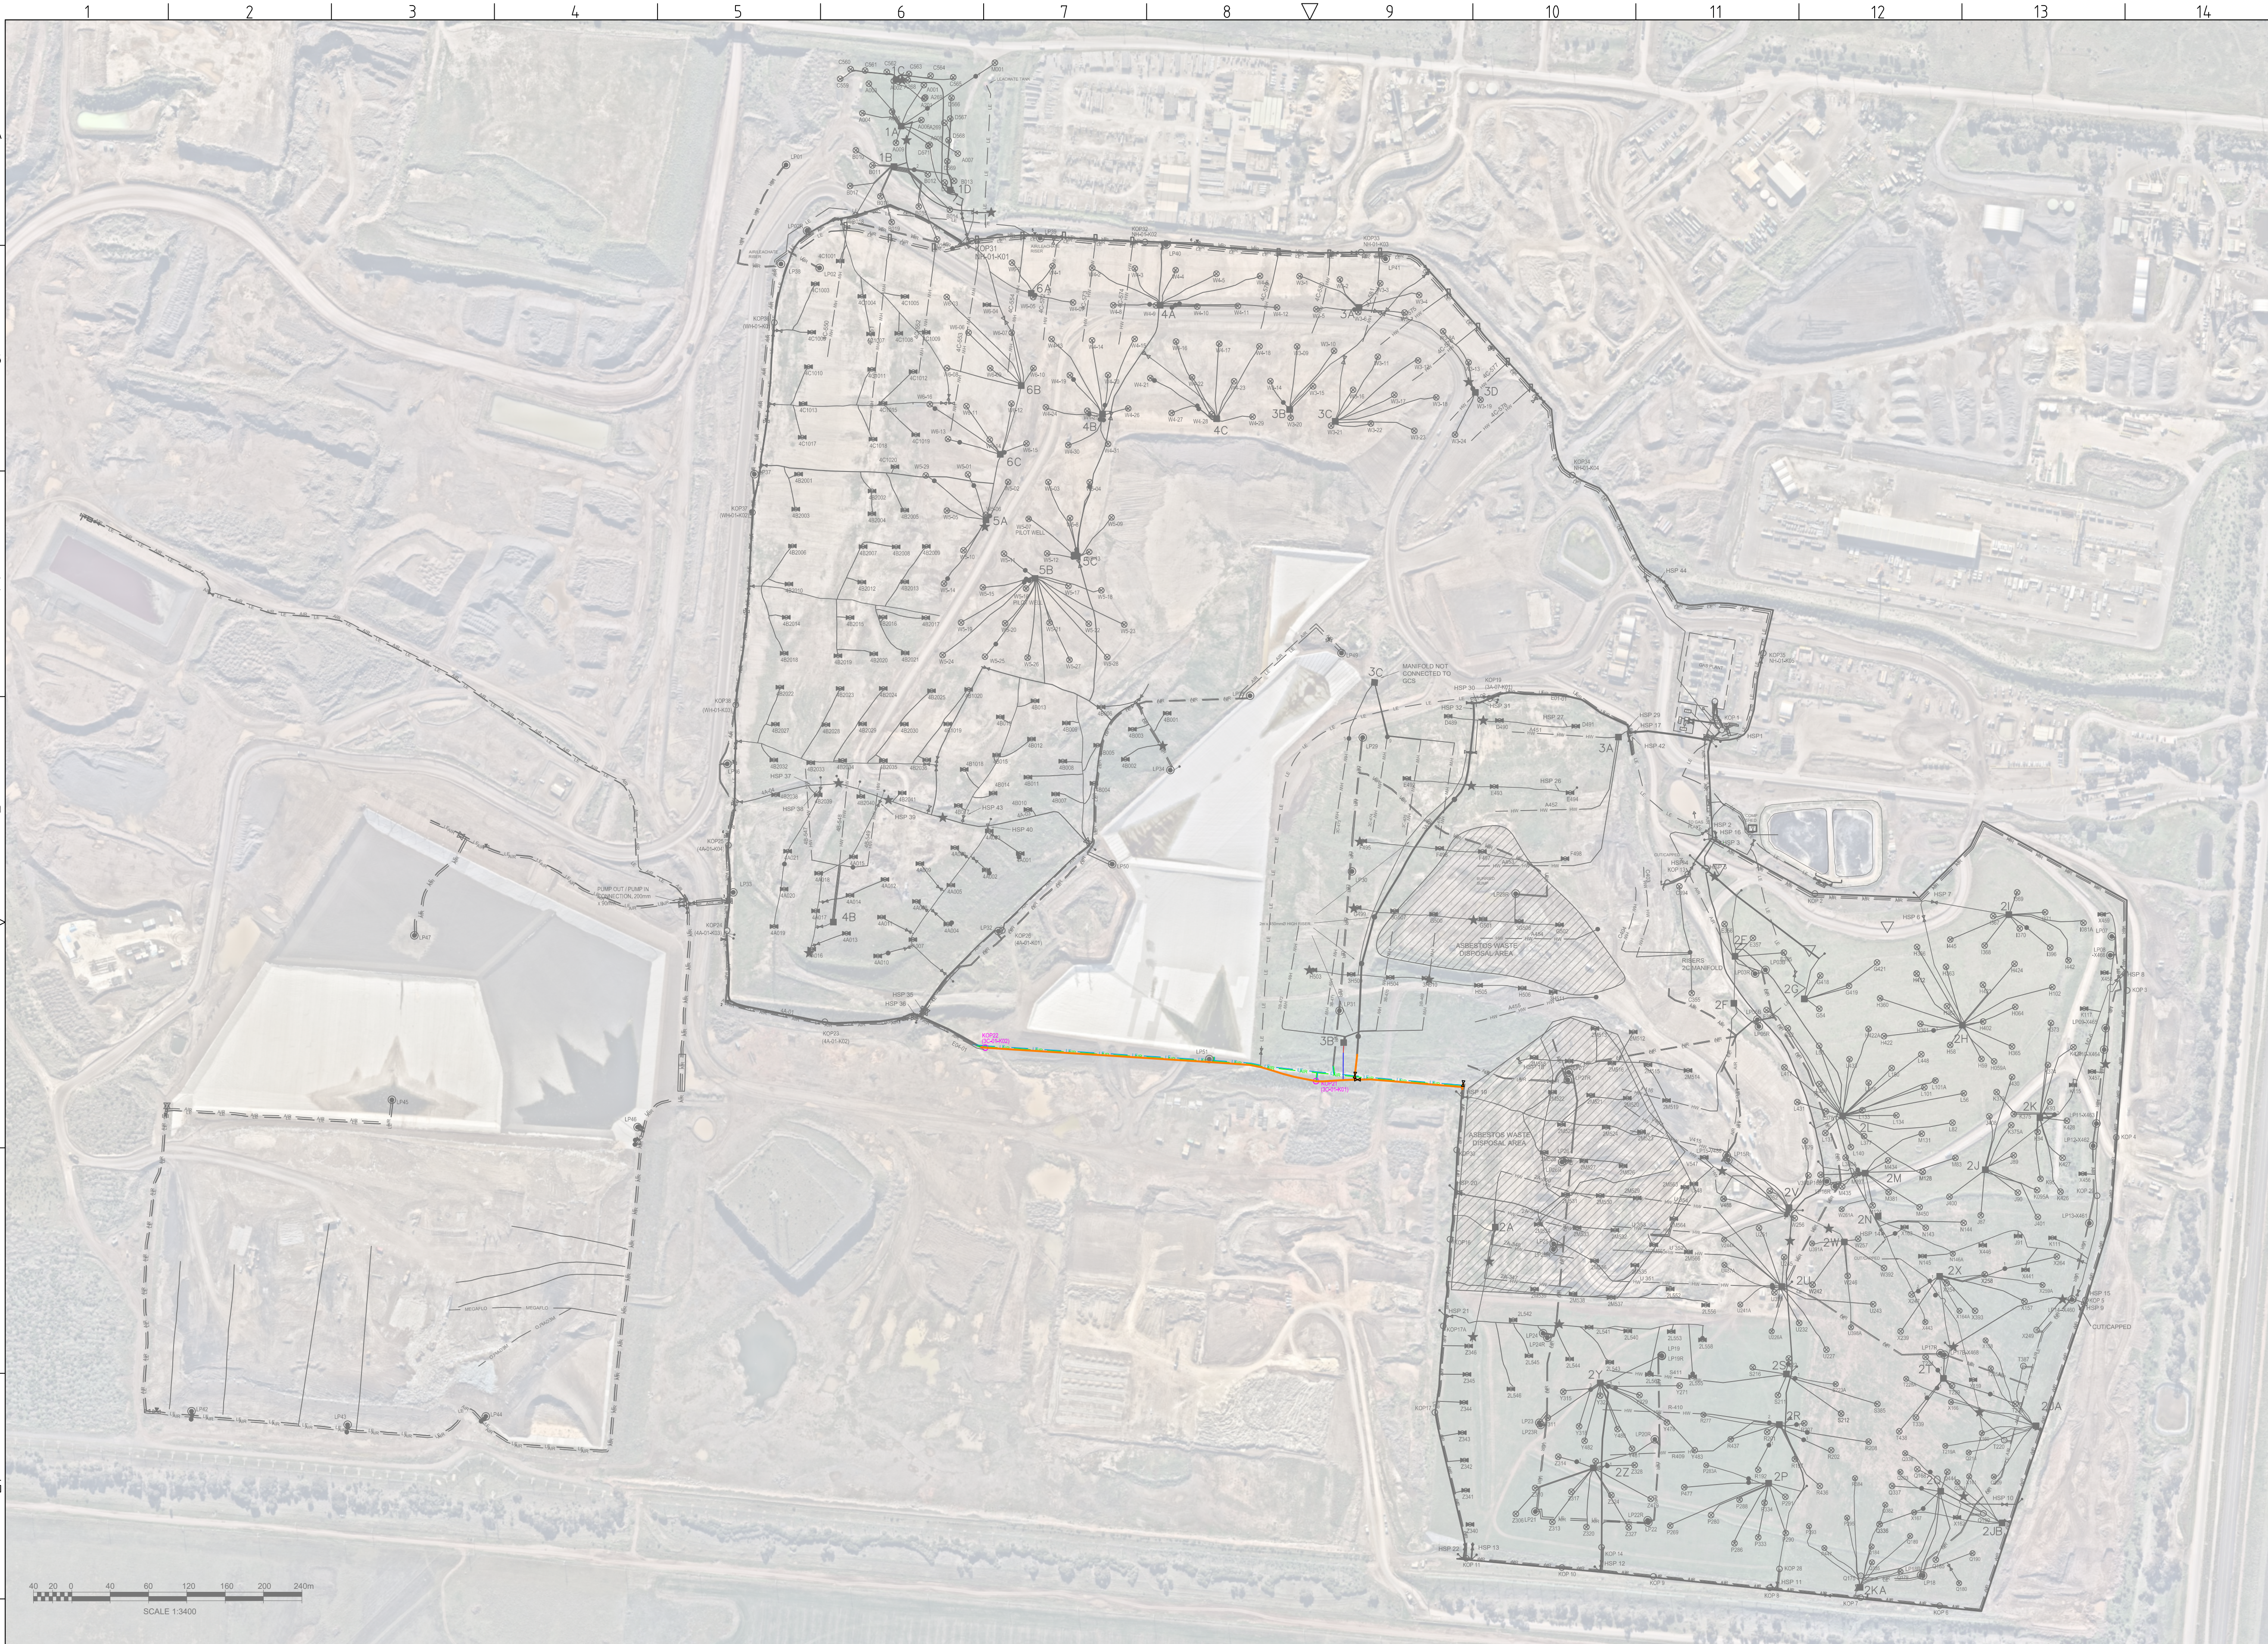

MAPPING INFORMATION	
COORDINATE SYSTEM:	MAP GRID OF AUSTRALIA
COORDINATE UNITS:	METRES
ZONE:	55
NEARMAP INFORMATION	
DATE:	16/05/2024

FIELD SUMMARY			
PIPE SIZE	LENGTH	ITEM	TOTAL
HORIZ WEL	63mm	⊗	0
	90mm	⊕	0
	110mm	⊕	0
	125mm	⊕	0
	160mm	⊕	0
FLOW	200mm	●	0
	63mm	★	0
	90mm	★	0
	110mm	★	3
	125mm	★	0
LATERAL	90mm	⊗	0
	125mm	⊗	0
	160mm	⊗	0
	200mm	⊗	0
	32mm	OKOP	2
LEACHATE	63mm	⊗	0
	90mm	⊗	0
	110mm	⊗	0
	160mm	⊗	0
	200mm	⊗	0
MAIN HEADER	90mm	⊗	0
	110mm	⊗	0
	125mm	⊗	10
	160mm	⊗	28
	200mm	⊗	9
	225mm	⊗	0
	250mm	⊗	0
	280mm	⊗	0
	315mm	⊗	0
	355mm	⊗	0
	400mm	⊗	0
	450mm	⊗	540
	500mm	⊗	0

LEGEND	
⊗	WELL
⊕	PILOT WELL
⊕	MONITORING BORE
⊕	WELLHEAD STATION - STANDARD
●	J TRAP
★	BAROMETRIC TRAP
★	ISOLATION VALVE
★	AIR RELIEF VALVE
★	PIT PUMPOUT
★	LEACHATE SUMP / RISER PIPES
★	STANDALONE WELL
OKOP	METER RUN
⊗	KNOCK OUT POT
⊗	DUAL PURPOSE WELL
⊗	FLARE / POWER STATION
A	WELLHEAD STATION NAME
A125	WELL NUMBER
MP1-1	MAIN GAS PIPE
●	HEADER MARKER
---	FENCE LINE
---	CELL BOUNDARY
---	COMMUNICATION
---	POWER
---	32mm AIR LINE
---	63mm AIR LINE
---	63mm LEACHATE LINE
---	90mm LEACHATE LINE
---	110mm LEACHATE LINE
---	125mm LEACHATE LINE
---	160mm LEACHATE LINE
---	200mm LEACHATE LINE
---	90mm HORIZONTAL WELL
---	90mm MAIN/LATERAL HEADER
---	125mm MAIN/LATERAL HEADER
---	140mm MAIN/LATERAL HEADER
---	160mm MAIN/LATERAL HEADER
---	180mm MAIN/LATERAL HEADER
---	200mm MAIN HEADER
---	225mm MAIN HEADER
---	250mm MAIN HEADER
---	280mm MAIN HEADER
---	315mm MAIN HEADER
---	355mm MAIN HEADER
---	400mm MAIN HEADER
---	450mm MAIN HEADER
---	500mm MAIN HEADER

67	450mm HEADER BETWEEN STG3, STG4 RELOCATED.	ZB	RB	RB	13/09/2024	62	ADDED GCS INSTALLATION 100 x WELLS, HEADERS	ZB	RB	RB	3/07/2024
66	ADDED 2M WELL CONNECTIONS, ASBESTOS BOUNDARY	ZB	RB	RB	5/09/2024	61	ADDED AIR, LEACHATE, SUMPS IN CELLS 1,2 AND 3	ZB	RB	RB	11/06/2024
65	ADDED HORIZONTALS IN CELL 1	ZB	RB	RB	16/08/2024	60	REROUTED STAGE 3 AIR/LEACHATE LINES TO LP28R	ZB	RB	RB	12/04/2024
64	ADDED MISSING VALVE IN STAGE 4	ZB	RB	RB	26/07/2024	59	REVISED IDS IN CELL 4B-2 TO MATCH FIELD IDS	ZB	RB	RB	13/03/2024
63	ADDED 450mm MAIN HEADER IN STAGE 4	ZB	RB	RB	8/07/2024	58	REMOVED SECTION OF 450mm MAIN, ADD LEACHATE LINES	ZB	RB	RB	27/02/2024
REV	DESCRIPTION	BY	CKD	APP	DATE	REV	DESCRIPTION	BY	CKD	APP	DATE
REVISION HISTORY						REVISION HISTORY					



199C OSBORNE AVE, CLAYTON STH, VIC 3169
PH: (03) 9558 6200
www.runenergy.com

PROJECT:	MELBOURNE REGIONAL LANDFILL
DRAWING TITLE:	MRL ASBUILT SITE LAYOUT

DRAWING No:		MRL-GCS-001	
DRAWING TYPE:			
JOB AS BUILT			
DRAWN:		CKD:	
ZB		RB	
DATE:		APP:	
13/09/2024		RB	
DESIGNED:		APP DATE:	
RB		13/09/2024	
SCALE:	SHEET:	REV:	SIZE:
1:3400	1 of 1	67	A1