




|                  |     |                                                   |    |     |     |                  |                  |                                                     |    |     |            |            |
|------------------|-----|---------------------------------------------------|----|-----|-----|------------------|------------------|-----------------------------------------------------|----|-----|------------|------------|
| H                |     |                                                   |    |     |     | 57               | REVISED AS BUILT | ZB                                                  | RB | RB  | 18/12/2023 |            |
|                  |     |                                                   |    |     |     | 56               | REVISED AS BUILT | ZB                                                  | RB | RB  | 18/12/2023 |            |
|                  | 60  | REROUTED STAGE 3 AIR/LEACHATE LINES TO LP28R      | ZB | RB  | RB  | 12/04/2024       | 55               | ADDED AIR / LEACHATE LINES (NEAR STAGE 4 AND DAMS)  | ZB | RB  | RB         | 18/12/2023 |
|                  | 59  | REVISED IDS IN CELL 4B-2 TO MATCH FIELD IDS       | ZB | RB  | RB  | 13/03/2024       | 54               | ADDED AIR RELIEF VALVES, MOVED / ADDED HEADERS      | ZB | RB  | RB         | 5/09/2023  |
|                  | 58  | REMOVED SECTION OF 450mm MAIN, ADD LEACHATE LINES | ZB | RB  | RB  | 27/02/2024       | 53               | ADDED NEW CELL 1 AIR, LEACHATE LINES, SUMPS. RISERS | ZB | RB  | RB         | 23/08/2023 |
|                  | REV | DESCRIPTION                                       | BY | CKD | APP | DATE             | REV              | DESCRIPTION                                         | BY | CKD | APP        | DATE       |
| REVISION HISTORY |     |                                                   |    |     |     | REVISION HISTORY |                  |                                                     |    |     |            |            |

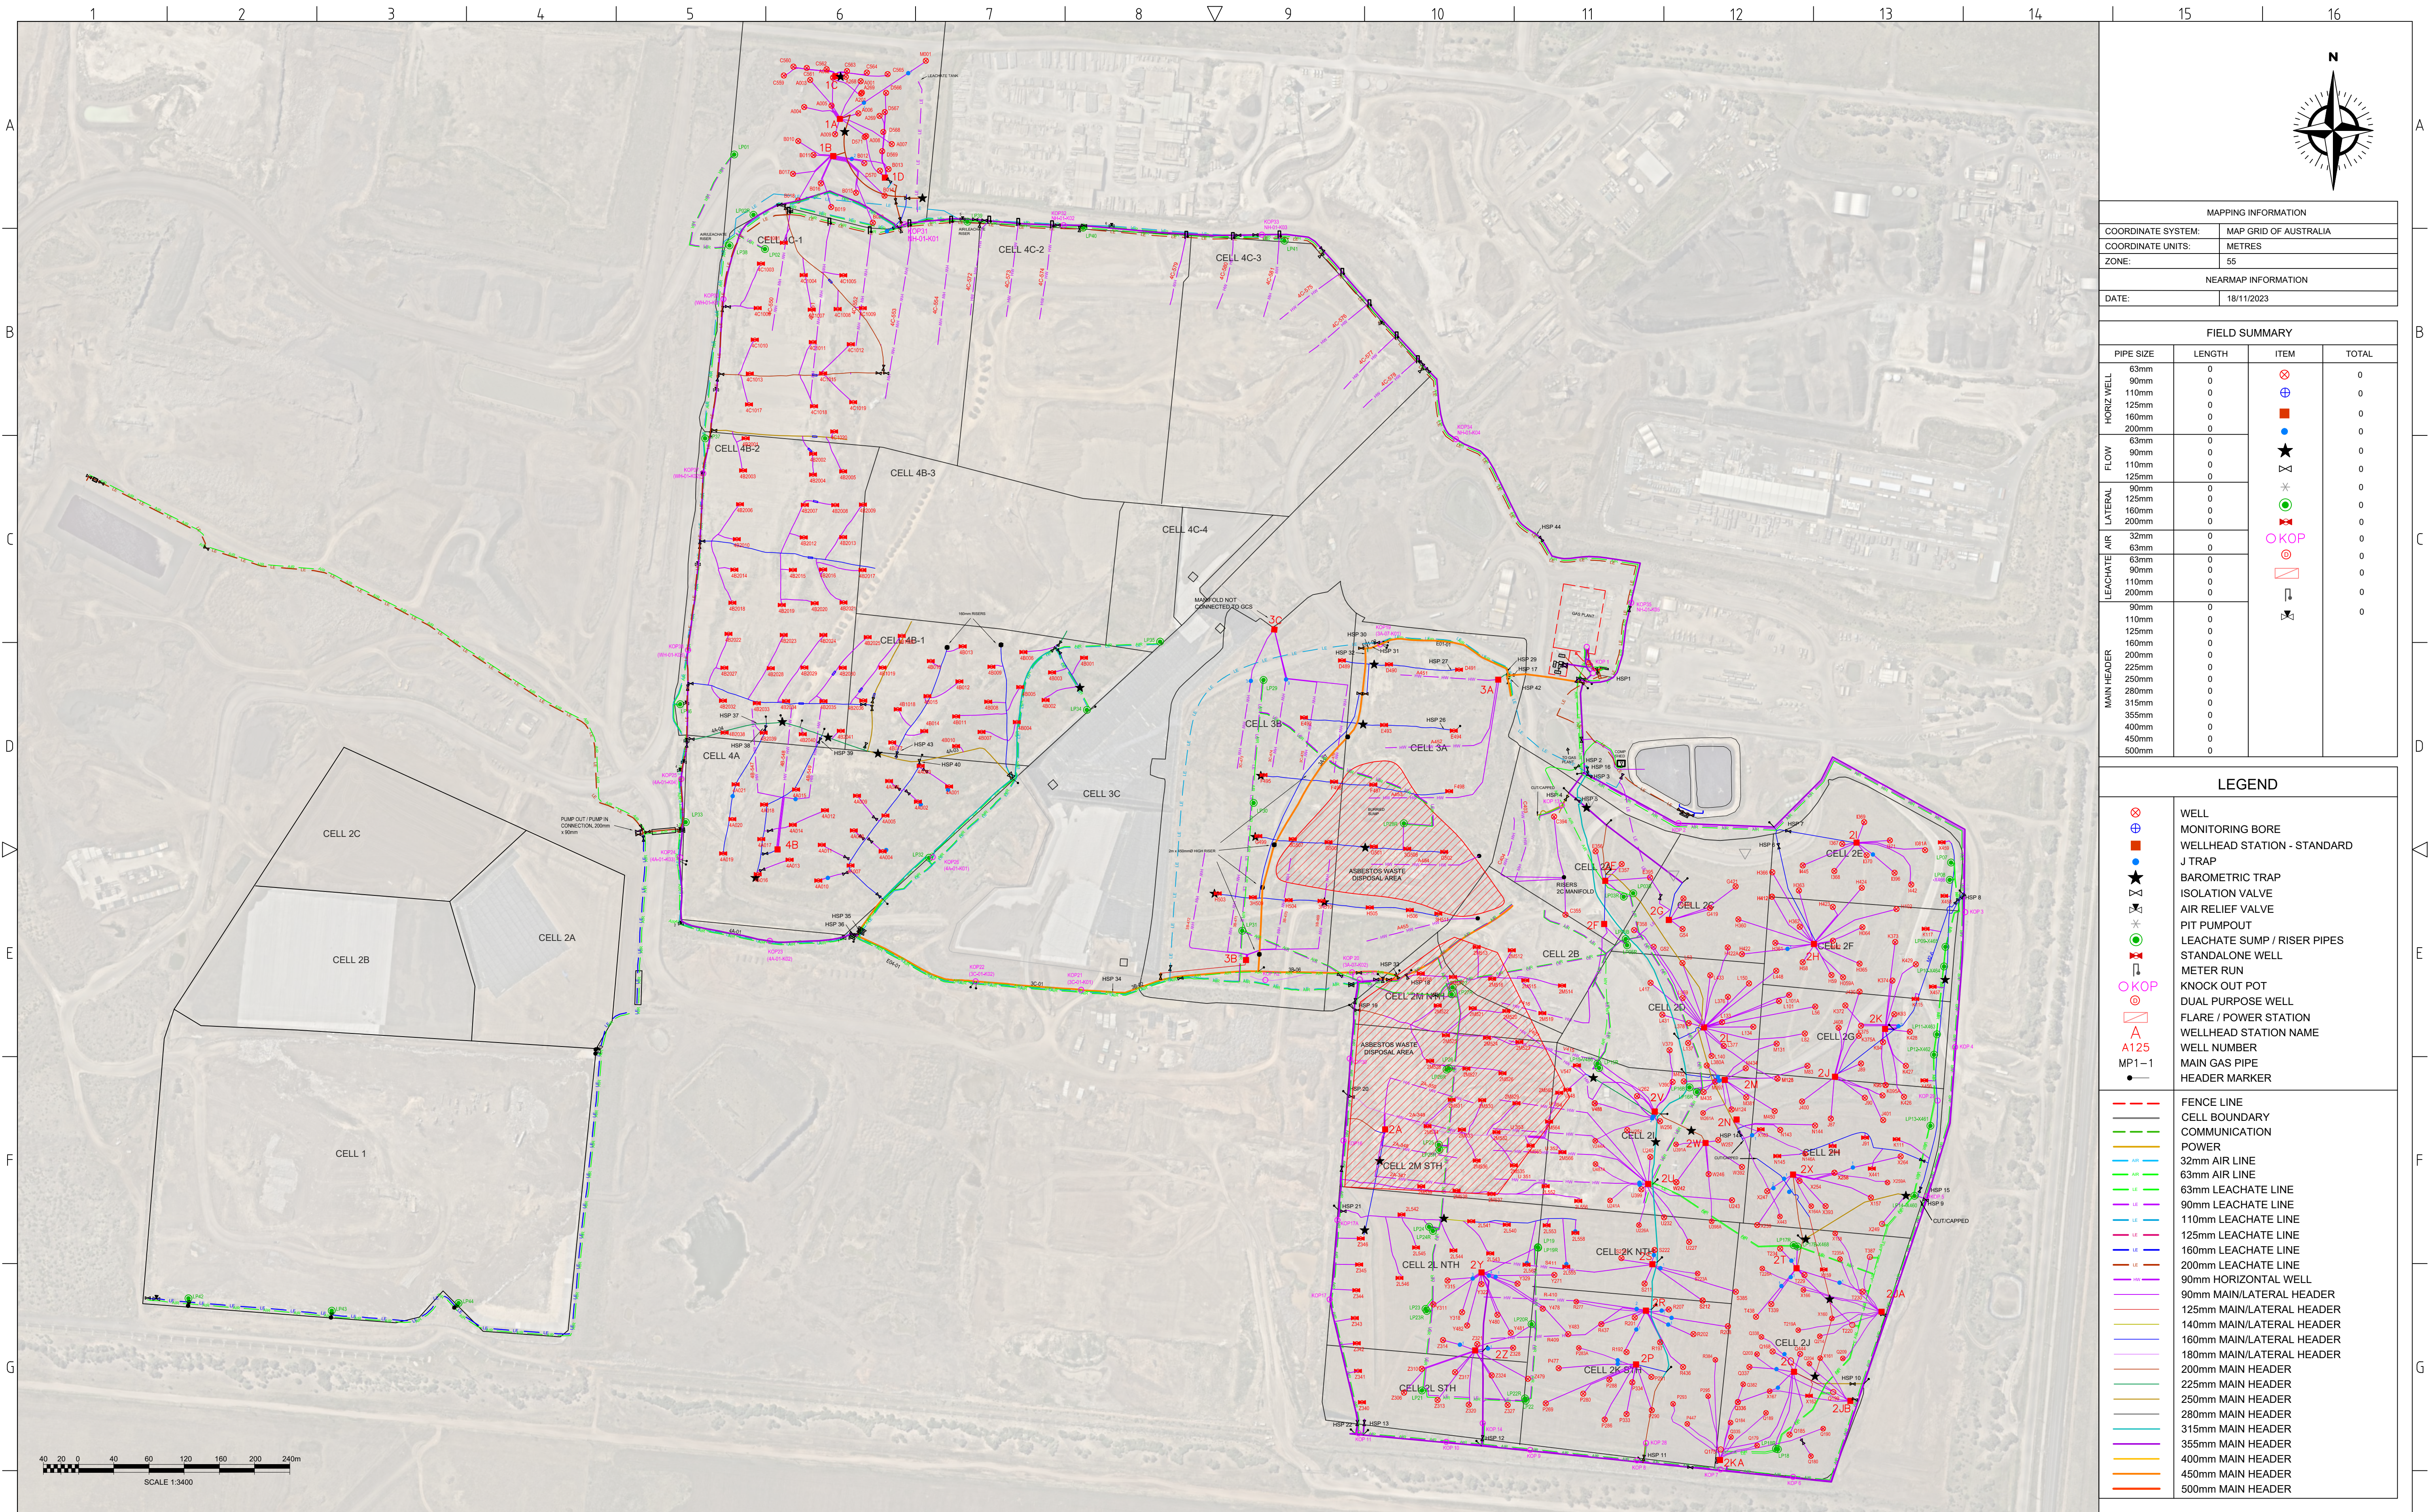


199C OSBORNE AVE, CLAYTON STH. VIC 3169  
PH: (03) 9558 6200  
www.runenergy.com

PROJECT:  
MELBOURNE REGIONAL LANDFILL

DRAWING TITLE:  
MRL ASBUILT  
SITE LAYOUT

|                         |                      |         |          |
|-------------------------|----------------------|---------|----------|
| DRAWING No: MRL-GCS-001 |                      |         |          |
| DRAWING TYPE: AS BUILT  |                      |         |          |
| DRAWN: ZB               | CKD: RC              |         |          |
| DATE: 12/04/2024        | APP: RC              |         |          |
| DESIGNED: RC            | APP DATE: 12/04/2024 |         |          |
| SCALE: 1:3400           | SHEET: 1 of 3        | REV: 60 | SIZE: A1 |



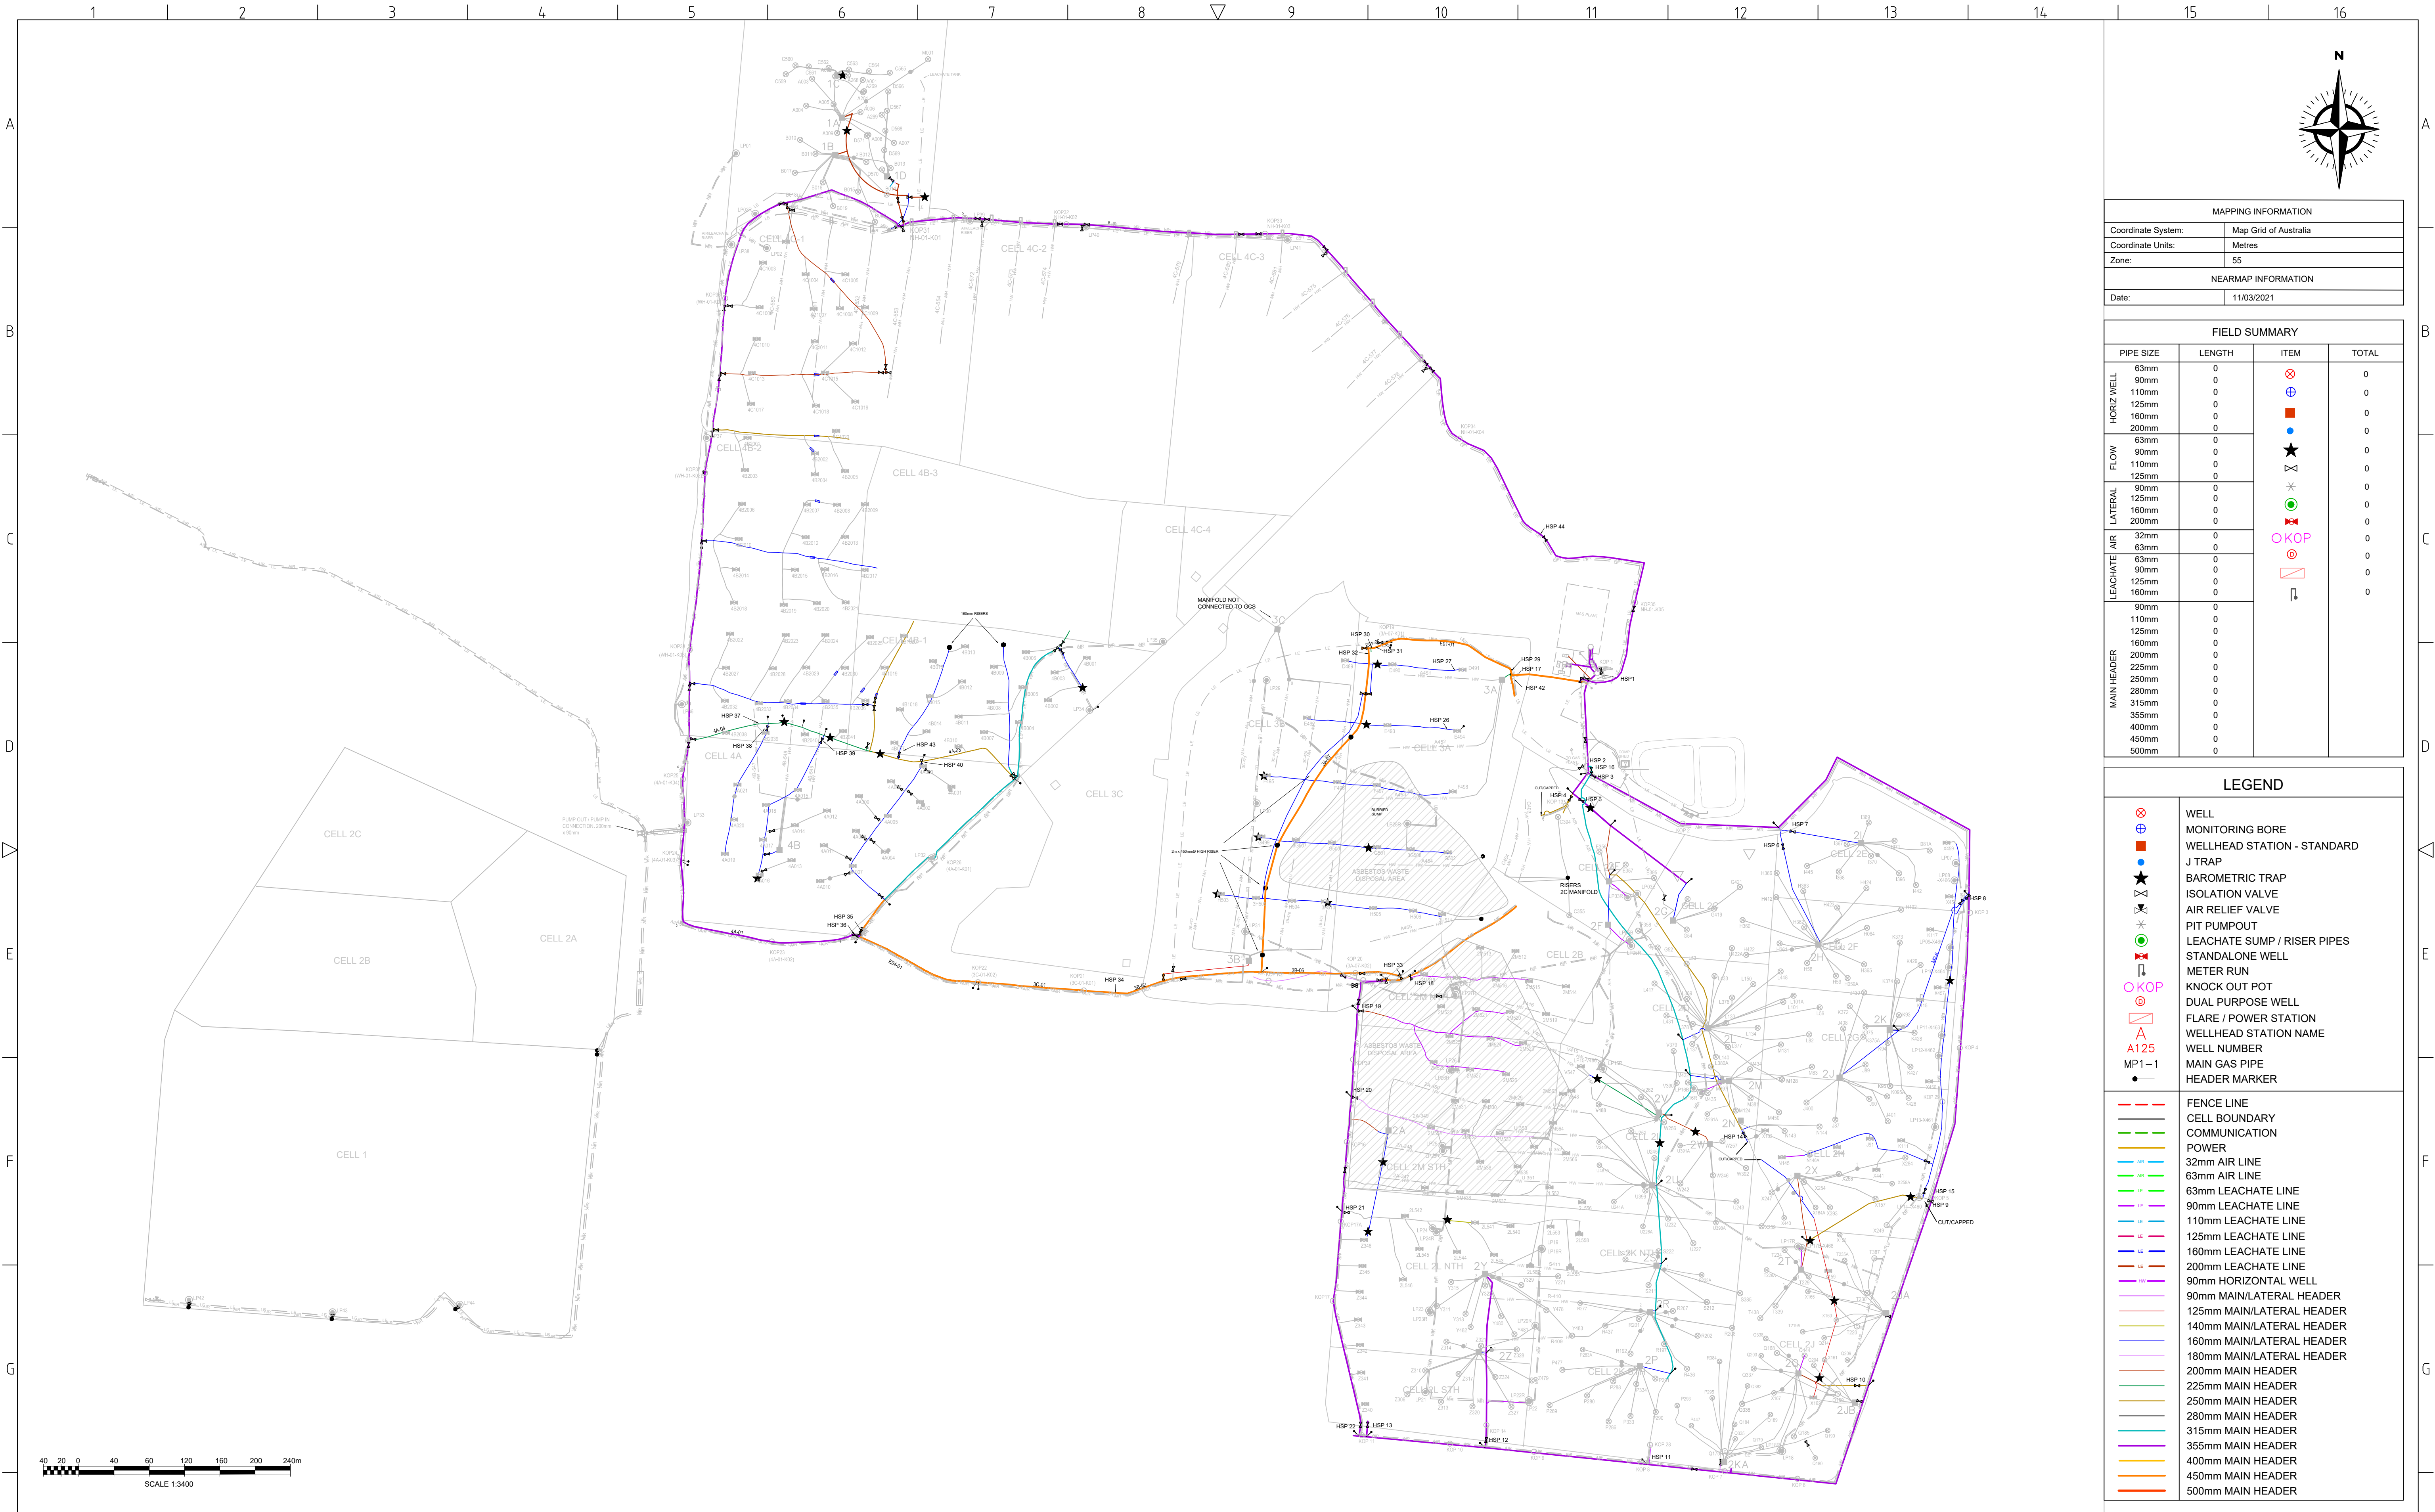

|                  |                                                   |    |     |     |            |                  |                                                     |    |     |     |            |
|------------------|---------------------------------------------------|----|-----|-----|------------|------------------|-----------------------------------------------------|----|-----|-----|------------|
|                  |                                                   |    |     |     |            | 57               | REVISED AS BUILT                                    | ZB | RB  | RB  | 18/12/2023 |
|                  |                                                   |    |     |     |            | 56               | REVISED AS BUILT                                    | ZB | RB  | RB  | 18/12/2023 |
| 60               | REROUTED STAGE 3 AIR/LEACHATE LINES TO LP28R      | ZB | RB  | RB  | 12/04/2024 | 55               | ADDED AIR / LEACHATE LINES (NEAR STAGE 4 AND DAMS)  | ZB | RB  | RB  | 18/12/2023 |
| 59               | REVISED IDS IN CELL 4B-2 TO MATCH FIELD IDS       | ZB | RB  | RB  | 13/03/2024 | 54               | ADDED AIR RELIEF VALVES, MOVED / ADDED HEADERS      | ZB | RB  | RB  | 5/09/2023  |
| 58               | REMOVED SECTION OF 450mm MAIN, ADD LEACHATE LINES | ZB | RB  | RB  | 27/02/2024 | 53               | ADDED NEW CELL 1 AIR, LEACHATE LINES, SUMPS. RISERS | ZB | RB  | RB  | 23/08/2023 |
| REV              | DESCRIPTION                                       | BY | CKD | APP | DATE       | REV              | DESCRIPTION                                         | BY | CKD | APP | DATE       |
| REVISION HISTORY |                                                   |    |     |     |            | REVISION HISTORY |                                                     |    |     |     |            |

199C OSBORNE AVE, CLAYTON STH, VIC 3169  
PH: (03) 9558 6200  
www.runenergy.com

PROJECT:  
MELBOURNE REGIONAL LANDFILL

DRAWING TITLE:  
MRL-GCS\_MAIN HEADERS  
SITE LAYOUT

|                         |                      |         |          |
|-------------------------|----------------------|---------|----------|
| DRAWING No: MRL-GCS-001 |                      |         |          |
| DRAWING TYPE: AS BUILT  |                      |         |          |
| DRAWN: ZB               | CKD: RC              |         |          |
| DATE: 12/04/2024        | APP: RC              |         |          |
| DESIGNED: RC            | APP DATE: 12/04/2024 |         |          |
| SCALE: 1:3400           | SHEET: 3 of 3        | REV: 60 | SIZE: A1 |