


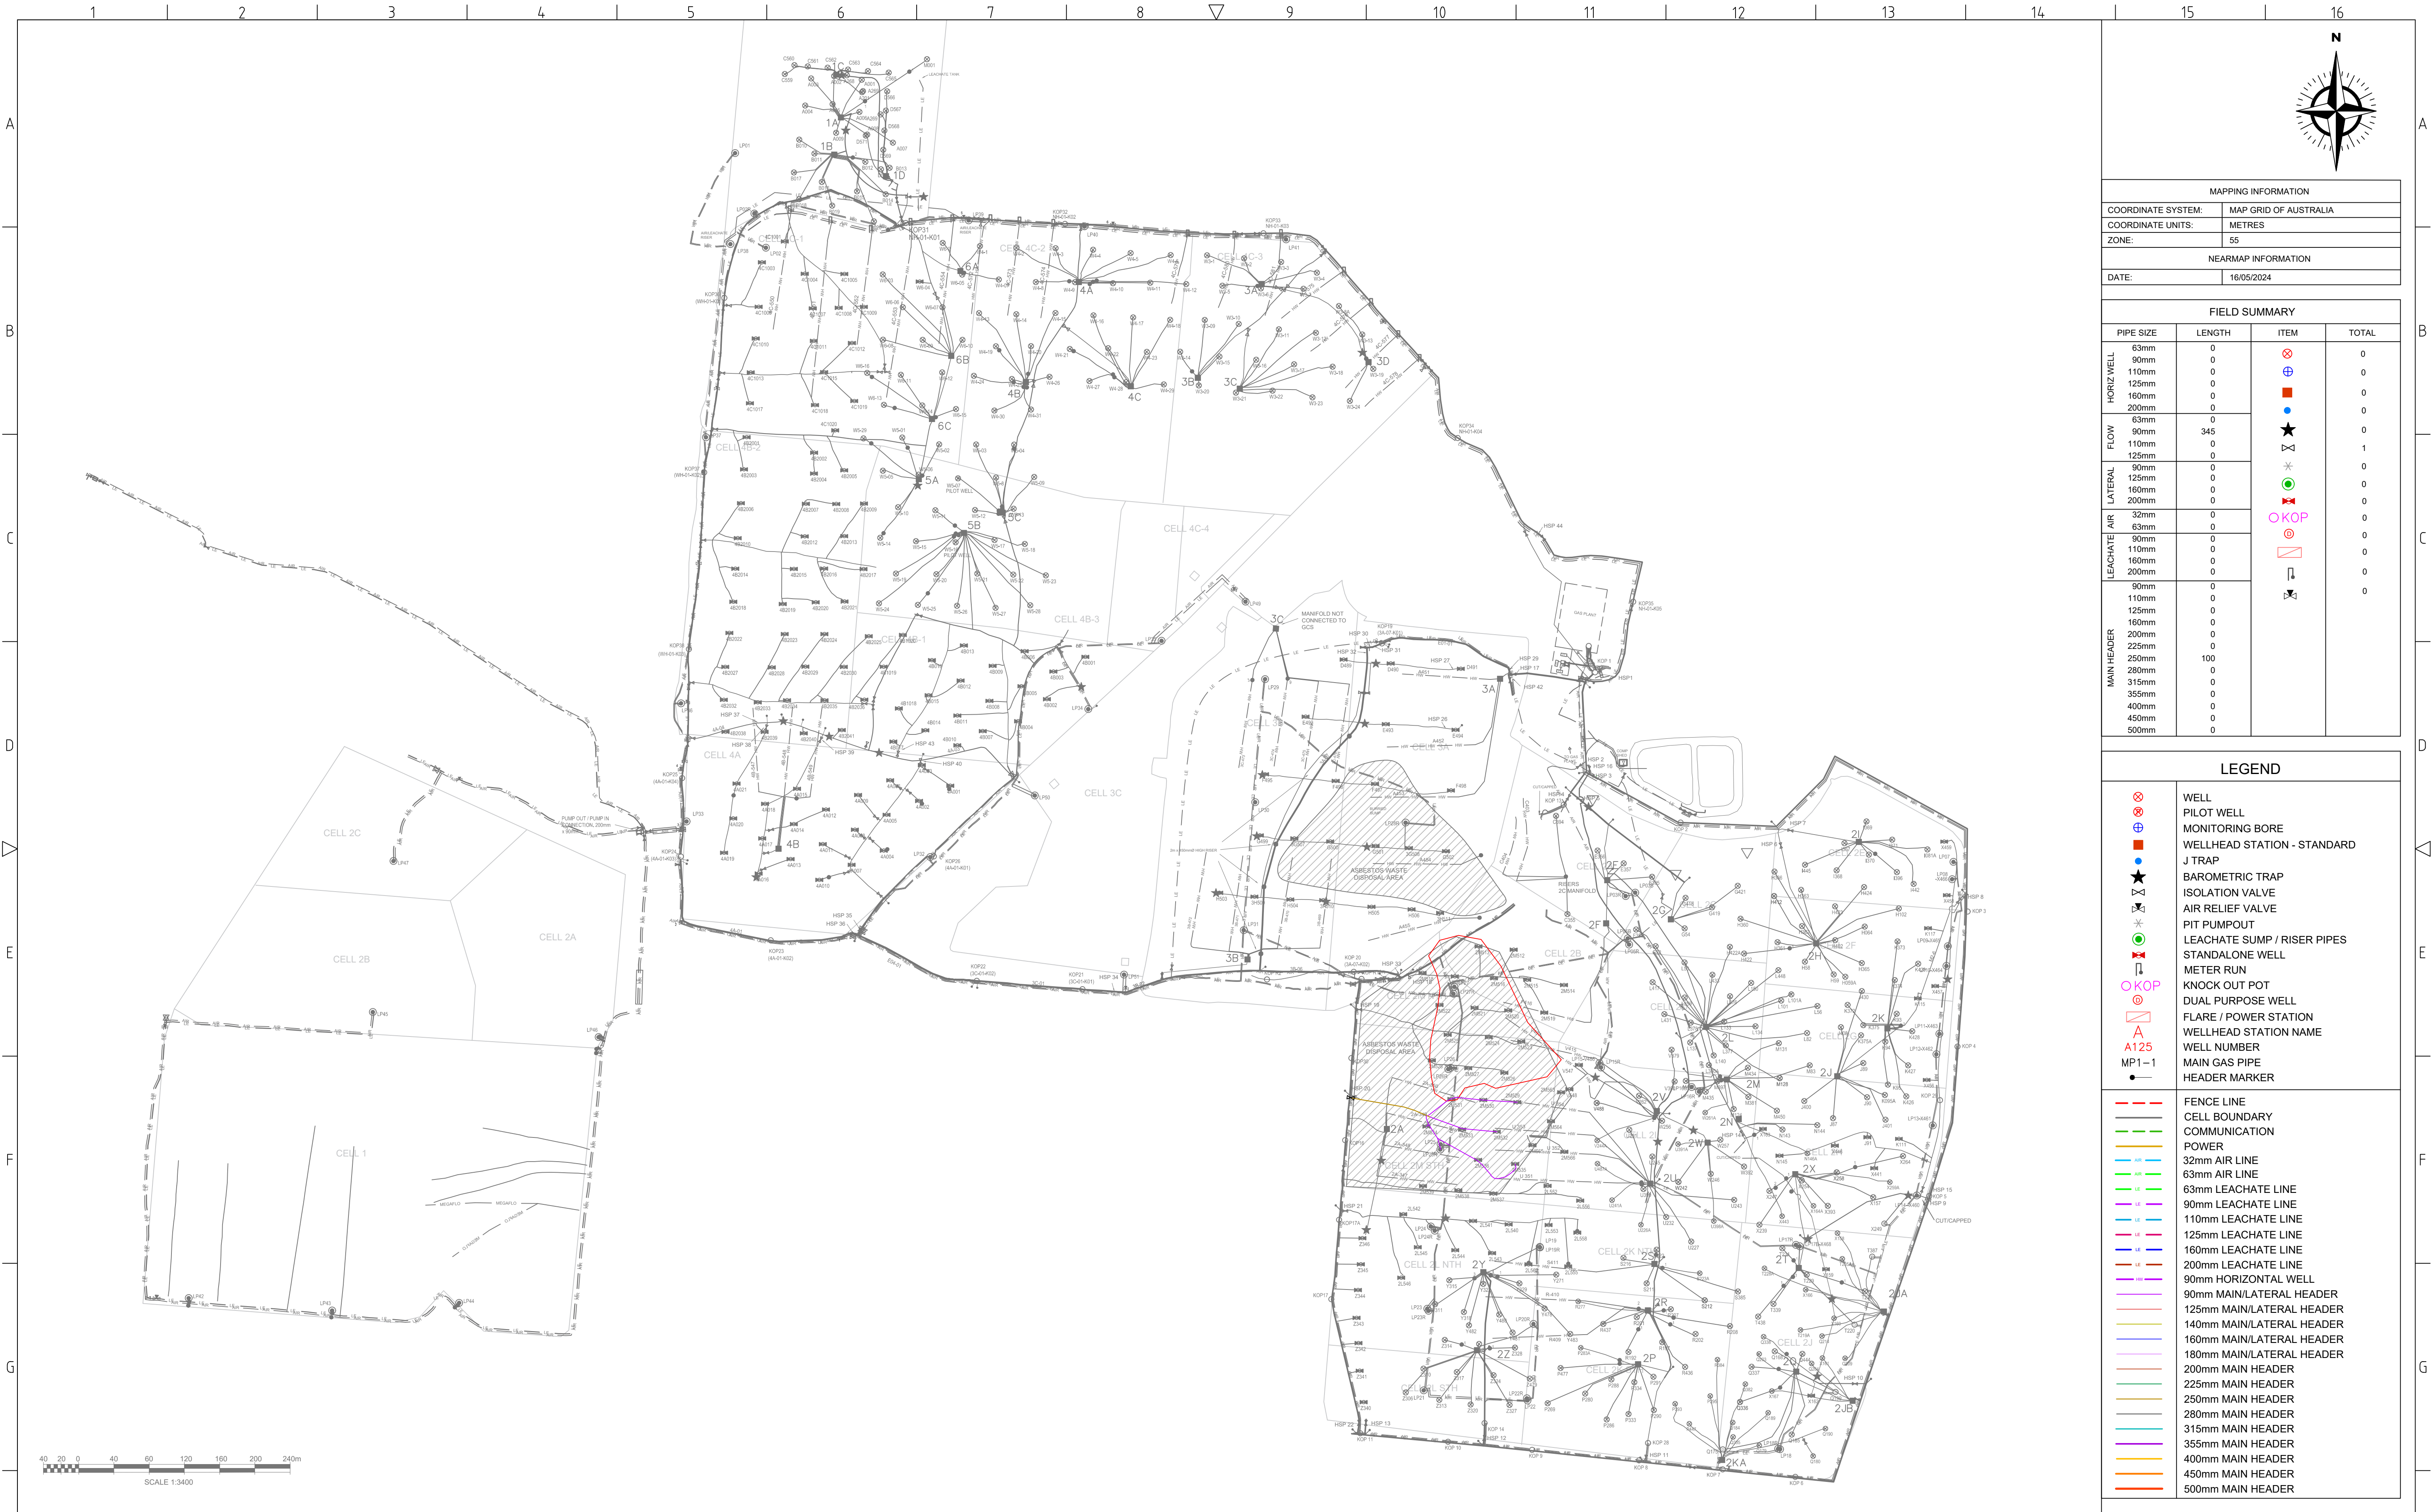

66	ADDED 2M WELL CONNECTIONS, ASBESTOS BOUNDARY	ZB	RB	RB	5/09/2024	61	ADDED AIR, LEACHATE, SUMPS IN CELLS 1,2 AND 3	ZB	RB	RB	11/06/2024
65	ADDED HORIZONTALS IN CELL 1	ZB	RB	RB	16/08/2024	60	REROUTED STAGE 3 AIR/LEACHATE LINES TO LP28R	ZB	RB	RB	12/04/2024
64	ADDED MISSING VALVE IN STAGE 4	ZB	RB	RB	26/07/2024	59	REVISED IDS IN CELL 4B-2 TO MATCH FIELD IDS	ZB	RB	RB	13/03/2024
63	ADDED 450mm MAIN HEADER IN STAGE 4	ZB	RB	RB	8/07/2024	58	REMOVED SECTION OF 450mm MAIN, ADD LEACHATE LINES	ZB	RB	RB	27/02/2024
62	ADDED GCS INSTALLATION 100 x WELLS, HEADERS	ZB	RB	RB	3/07/2024	57	REVISED AS BUILT	ZB	RB	RB	18/12/2023
REV	DESCRIPTION	BY	CKD	APP	DATE	REV	DESCRIPTION	BY	CKD	APP	DATE
REVISION HISTORY						REVISION HISTORY					



199C OSBORNE AVE, CLAYTON STH, VIC 3169
PH: (03) 9558 6200
www.runenergy.com

PROJECT:
MELBOURNE REGIONAL LANDFILL

DRAWING TITLE:
MRL ASBUILT
SITE LAYOUT

DRAWING No: MRL-GCS-001			
DRAWING TYPE: JOB AS BUILT			
DRAWN: ZB	CKD: RB		
DATE: 05/09/2024	APP: RB		
DESIGNED: RB	APP DATE: 05/09/2024		
SCALE: 1:3400	SHEET: 1 of 1	REV: 66	SIZE: A1