


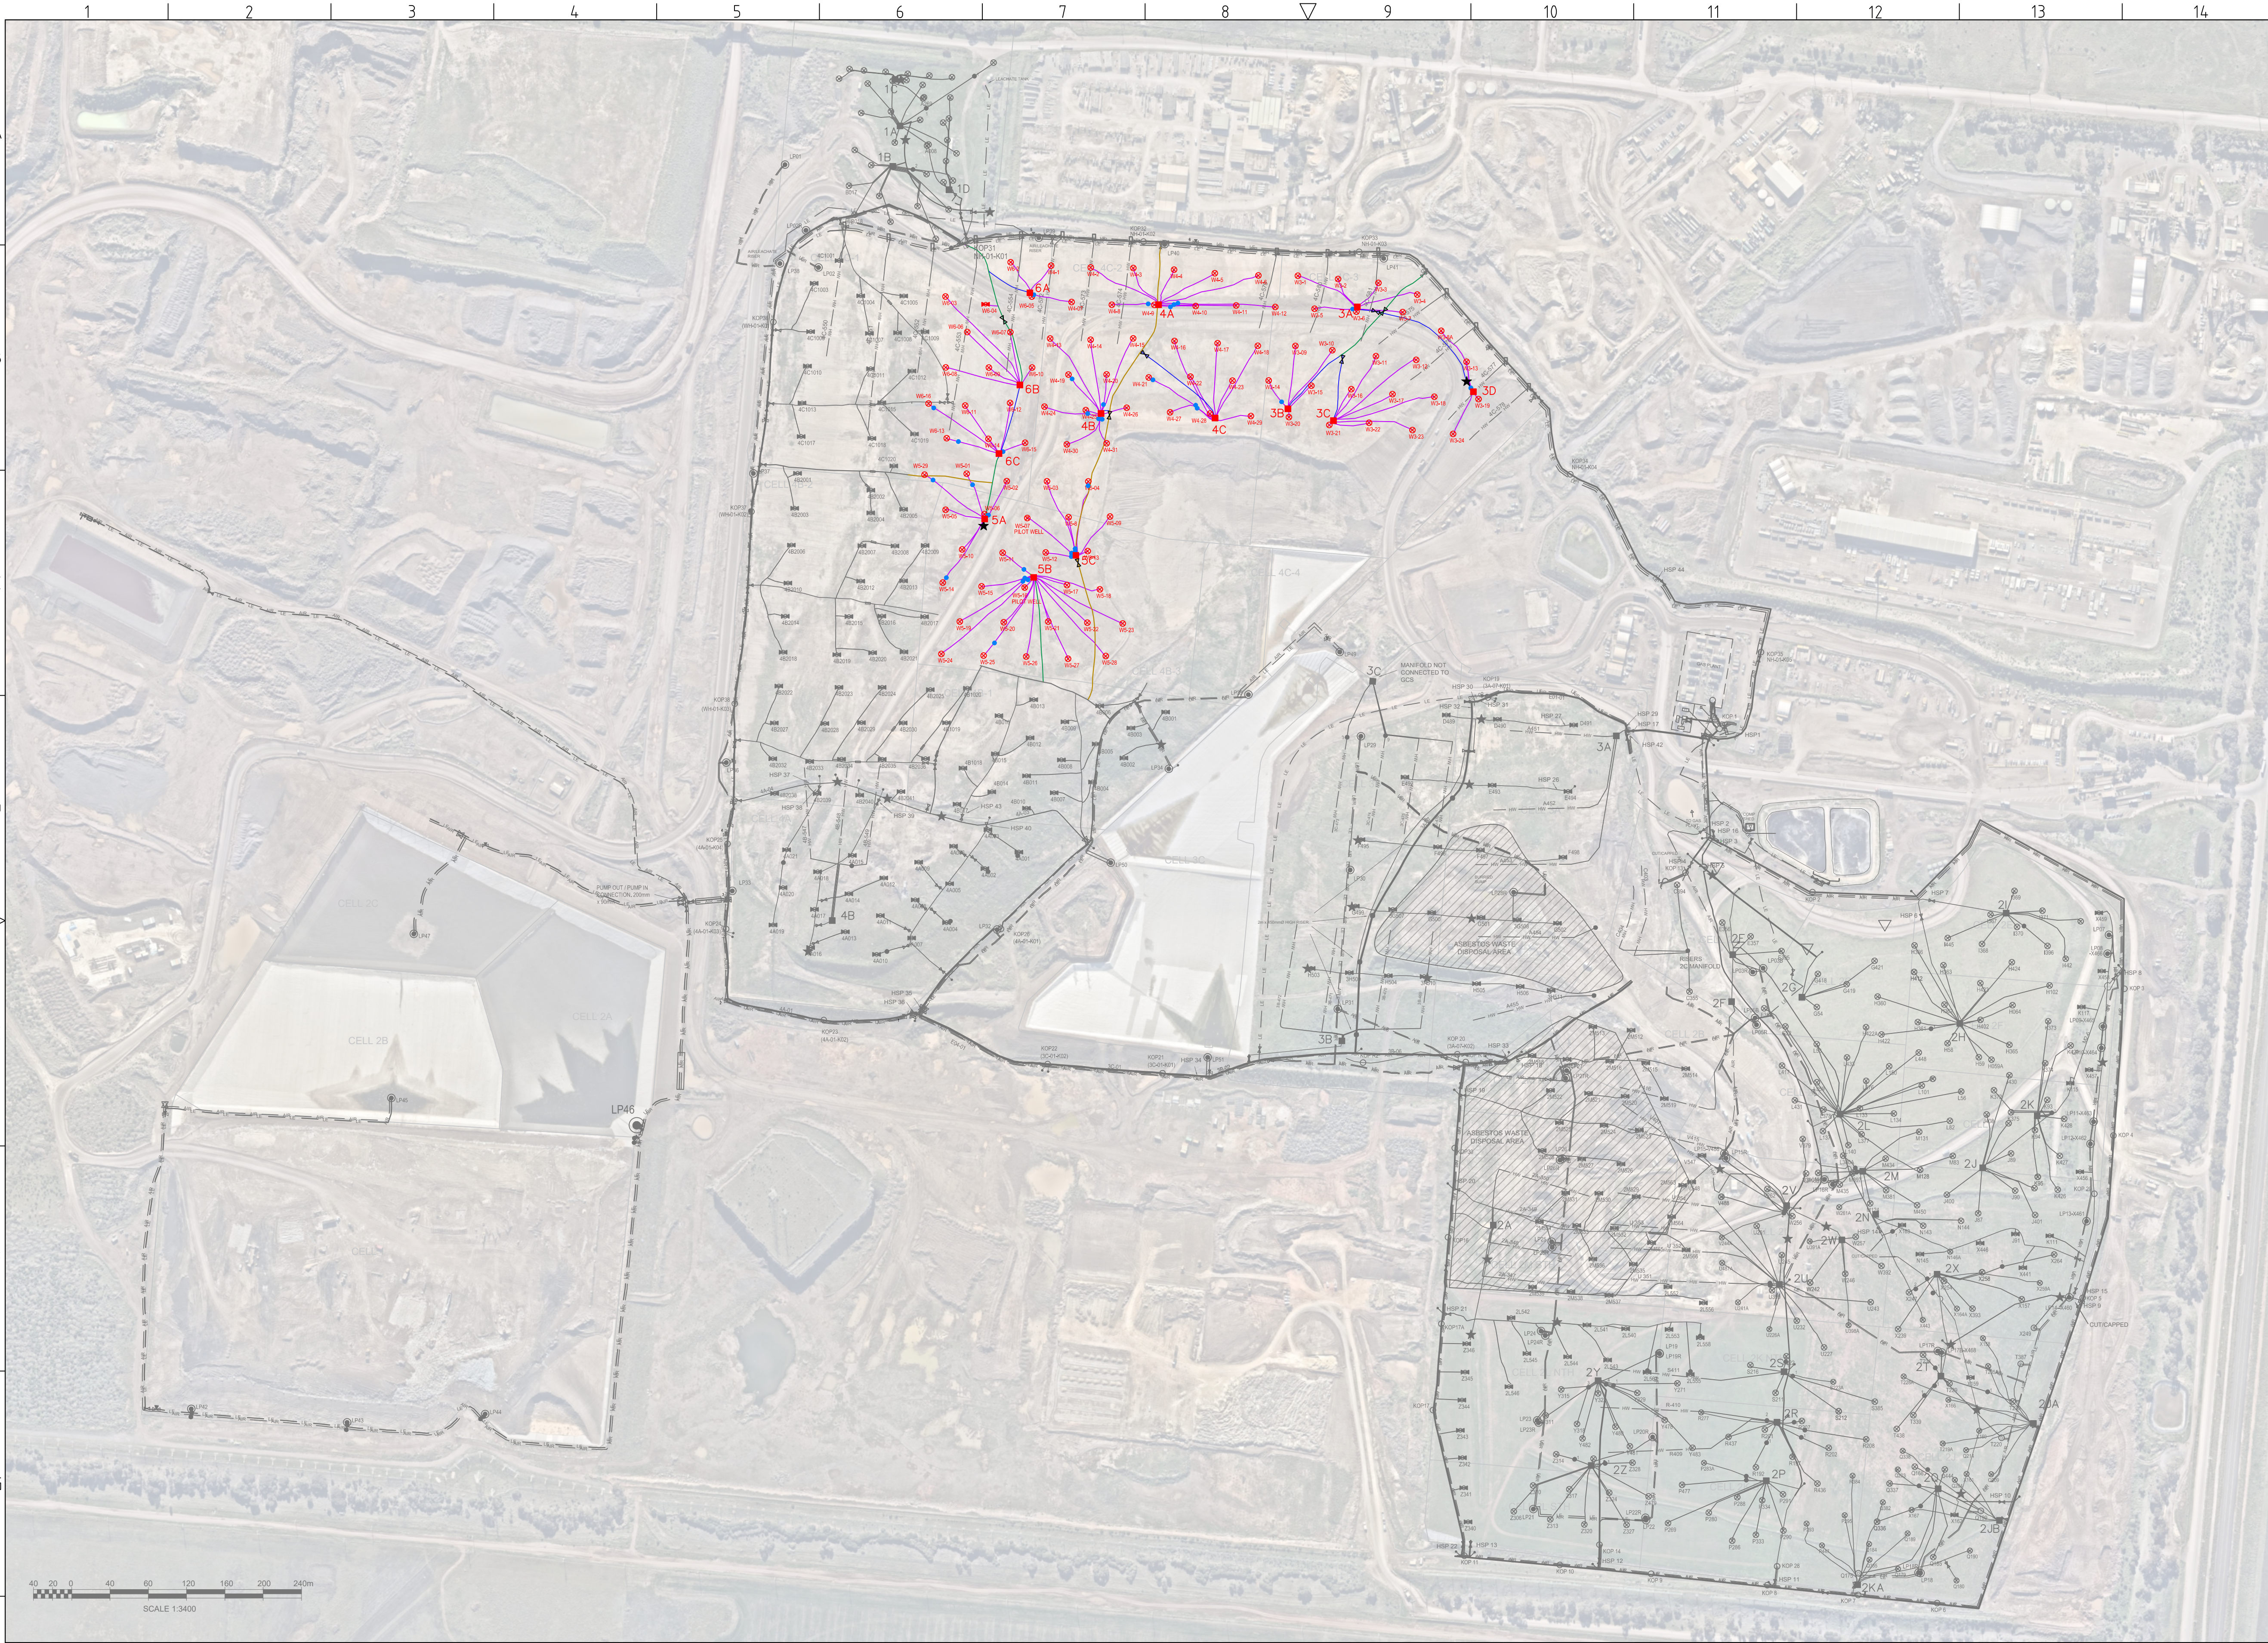

MAPPING INFORMATION	
COORDINATE SYSTEM:	MAP GRID OF AUSTRALIA
COORDINATE UNITS:	METRES
ZONE:	55
NEARMAP INFORMATION	
DATE:	18/11/2023

FIELD SUMMARY			
PIPE SIZE	LENGTH	ITEM	TOTAL
HORIZ WELL	63mm	⊗	96
	90mm	⊗	0
	110mm	⊗	2
	125mm	⊗	0
	160mm	⊗	0
FLOW	200mm	⊗	13
	63mm	12	34
	90mm	5564	2
	110mm	0	8
	125mm	0	0
LATERAL	90mm	0	0
	125mm	0	0
	160mm	0	0
	200mm	0	1
	32mm	0	0
LEACHATE	63mm	0	0
	90mm	0	0
	110mm	0	0
	160mm	0	0
	200mm	0	0
MAIN HEADER	90mm	0	0
	110mm	0	0
	125mm	0	0
	160mm	556	0
	200mm	0	0
	225mm	478	0
	250mm	601	0
	280mm	0	0
	315mm	0	0
	355mm	1	0
	400mm	0	0
	450mm	0	0
	500mm	0	0

LEGEND	
⊗	WELL
⊗	PILOT WELL
⊗	MONITORING BORE
⊗	WELLHEAD STATION - STANDARD
⊗	J TRAP
⊗	BAROMETRIC TRAP
⊗	ISOLATION VALVE
⊗	AIR RELIEF VALVE
⊗	PIT PUMPOUT
⊗	LEACHATE SUMP / RISER PIPES
⊗	STANDALONE WELL
⊗	METER RUN
⊗	KNOCK OUT POT
⊗	DUAL PURPOSE WELL
⊗	FLARE / POWER STATION
⊗	WELLHEAD STATION NAME
⊗	WELL NUMBER
⊗	MAIN GAS PIPE
⊗	MP1-1
⊗	HEADER MARKER
---	FENCE LINE
---	CELL BOUNDARY
---	COMMUNICATION
---	POWER
---	32mm AIR LINE
---	63mm AIR LINE
---	63mm LEACHATE LINE
---	90mm LEACHATE LINE
---	110mm LEACHATE LINE
---	125mm LEACHATE LINE
---	160mm LEACHATE LINE
---	200mm LEACHATE LINE
---	90mm HORIZONTAL WELL
---	90mm MAIN/LATERAL HEADER
---	125mm MAIN/LATERAL HEADER
---	140mm MAIN/LATERAL HEADER
---	160mm MAIN/LATERAL HEADER
---	180mm MAIN/LATERAL HEADER
---	200mm MAIN HEADER
---	225mm MAIN HEADER
---	250mm MAIN HEADER
---	280mm MAIN HEADER
---	315mm MAIN HEADER
---	355mm MAIN HEADER
---	400mm MAIN HEADER
---	450mm MAIN HEADER
---	500mm MAIN HEADER

62	ADDED GCS INSTALLATION 100 x WELLS, HEADERS	ZB	RB	RB	3/07/2024	57	REVISED AS BUILT	ZB	RB	RB	18/12/2023
61	ADDED AIR, LEACHATE, SUMPS IN CELLS 1,2 AND 3	ZB	RB	RB	11/06/2024	56	REVISED AS BUILT	ZB	RB	RB	18/12/2023
60	REROUTED STAGE 3 AIR/LEACHATE LINES TO LP28R	ZB	RB	RB	12/04/2024	55	ADDED AIR / LEACHATE LINES (NEAR STAGE 4 AND DAMS)	ZB	RB	RB	18/12/2023
59	REVISED IDS IN CELL 4B-2 TO MATCH FIELD IDS	ZB	RB	RB	13/03/2024	54	ADDED AIR RELIEF VALVES, MOVED / ADDED HEADERS	ZB	RB	RB	5/09/2023
58	REMOVED SECTION OF 450mm MAIN, ADD LEACHATE LINES	ZB	RB	RB	27/02/2024	53	ADDED NEW CELL 1 AIR, LEACHATE LINES, SUMPS. RISERS	ZB	RB	RB	23/08/2023
REV	DESCRIPTION	BY	CKD	APP	DATE	REV	DESCRIPTION	BY	CKD	APP	DATE
REVISION HISTORY						REVISION HISTORY					


199C OSBORNE AVE, CLAYTON STH. VIC 3169
PH: (03) 9558 6200
www.runenergy.com

PROJECT:	MELBOURNE REGIONAL LANDFILL
DRAWING TITLE:	GAS COLLECTION SYSTEM INSTALLATION

DRAWING No:		MRL-GCS-001	
DRAWING TYPE:		JOB AS BUILT	
DRAWN: ZB		CKD: RC	
DATE: 03/07/2024		APP: RC	
DESIGNED: RC		APP DATE: 03/07/2024	
SCALE: 1:3400	SHEET: 1 of 1	REV: 62	SIZE: A1