


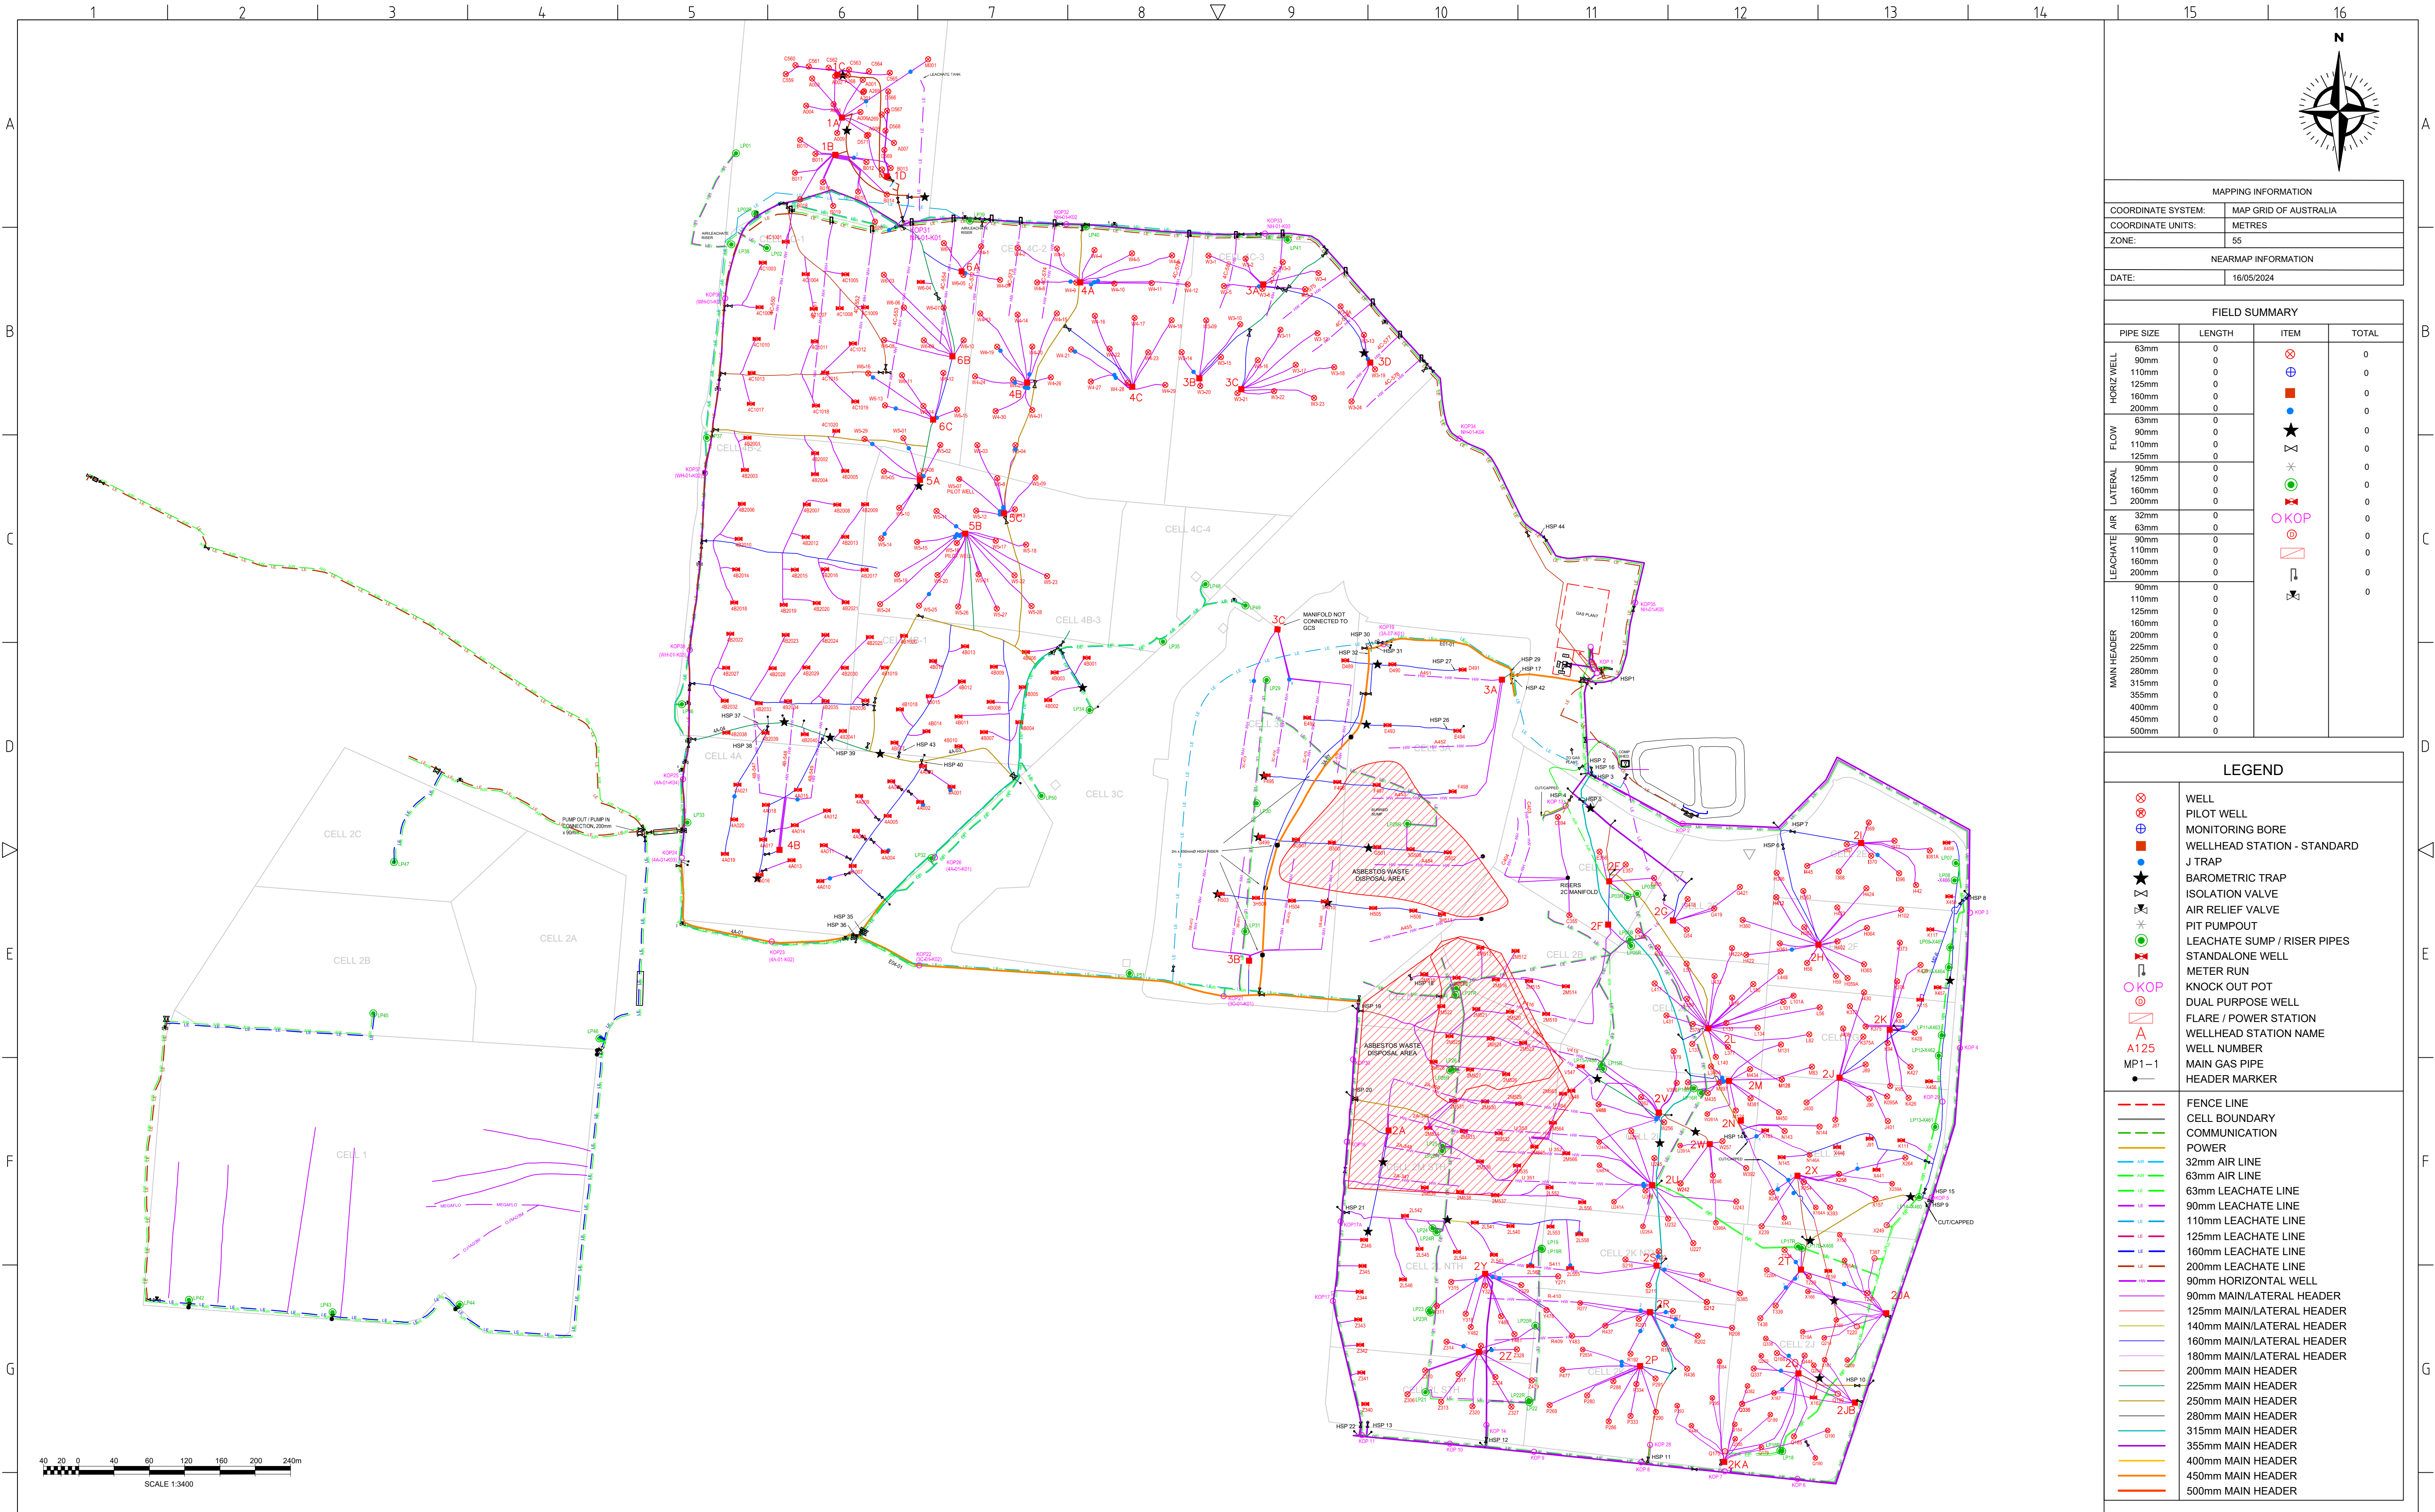

69	ADDED RELIEF VALVE ON LEACHATE LINE TO LP34, 35, 40, 41	ZB	RB	RB	6/11/2024	64	ADDED MISSING VALVE IN STAGE 4	ZB	RB	RB	26/07/2024
68	ADDED LP49, AIR / LEACHATE LINES	ZB	RB	RB	29/10/2024	63	ADDED 450mm MAIN HEADER IN STAGE 4	ZB	RB	RB	8/07/2024
67	450mm HEADER BETWEEN STG3, STG4 RELOCATED.	ZB	RB	RB	13/09/2024	62	ADDED GCS INSTALLATION 100 x WELLS, HEADERS	ZB	RB	RB	3/07/2024
66	ADDED 2M WELL CONNECTIONS, ASBESTOS BOUNDARY	ZB	RB	RB	5/09/2024	61	ADDED AIR, LEACHATE, SUMPS IN CELLS 1,2 AND 3	ZB	RB	RB	11/06/2024
65	ADDED HORIZONTALS IN CELL 1	ZB	RB	RB	16/08/2024	60	REROUTED STAGE 3 AIR/LEACHATE LINES TO LP28R	ZB	RB	RB	12/04/2024
REV	DESCRIPTION	BY	CKD	APP	DATE	REV	DESCRIPTION	BY	CKD	APP	DATE
REVISION HISTORY						REVISION HISTORY					




199C OSBORNE AVE, CLAYTON STH, VIC 3169
PH: (03) 9558 6200
www.runenergy.com

PROJECT:
MELBOURNE REGIONAL LANDFILL

DRAWING TITLE:
MRL ASBUILT
SITE LAYOUT

DRAWING No: MRL-GCS-001			
DRAWING TYPE: AS BUILT			
DRAWN: ZB	CKD: RB		
DATE: 06/11/2024	APP: RB		
DESIGNED: RB	APP DATE: 06/11/2024		
SCALE: 1:3400	SHEET: 1 of 3	REV: 69	SIZE: A1

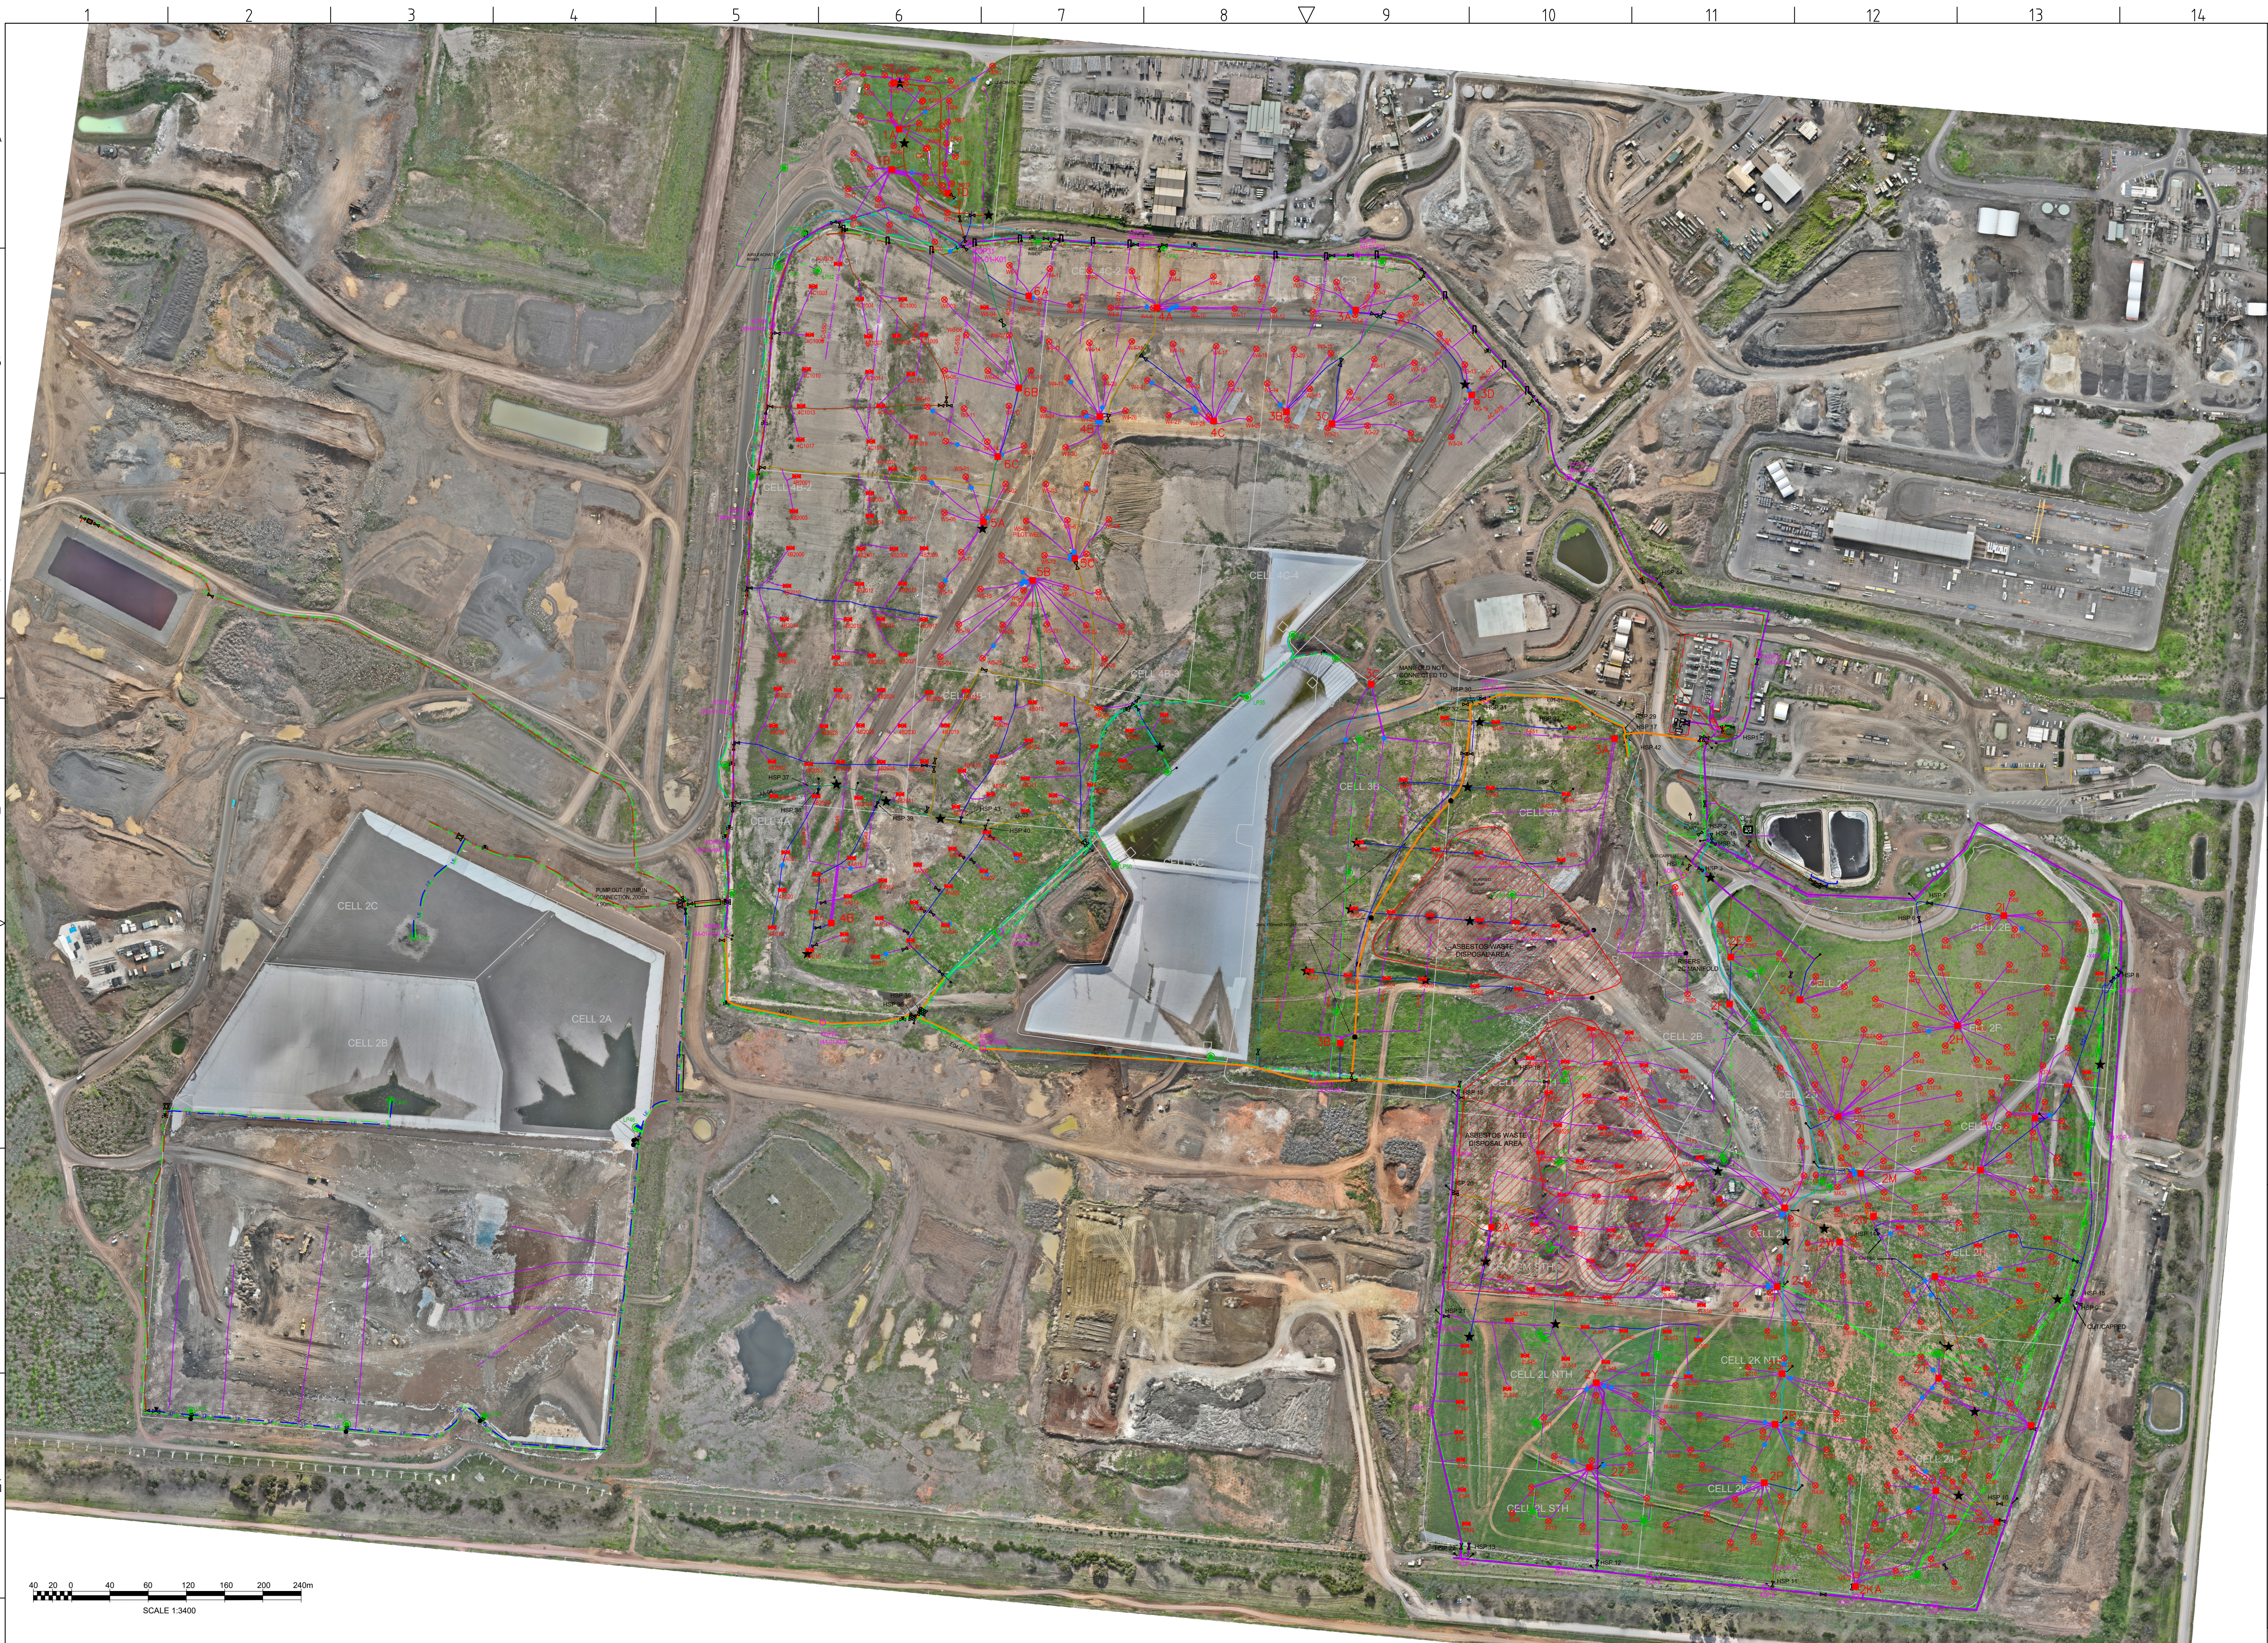

MAPPING INFORMATION	
COORDINATE SYSTEM:	MAP GRID OF AUSTRALIA
COORDINATE UNITS:	METRES
ZONE:	55
NEARMAP INFORMATION	
DATE:	16/05/2024

FIELD SUMMARY			
PIPE SIZE	LENGTH	ITEM	TOTAL
63mm	0	⊗	0
90mm	0	⊕	0
110mm	0	⊙	0
125mm	0	⊛	0
160mm	0	⊜	0
200mm	0	⊝	0
63mm	0	★	0
90mm	0	⚡	0
110mm	0	⚡	0
125mm	0	⚡	0
160mm	0	⚡	0
200mm	0	⚡	0
32mm	0	OKOP	0
63mm	0	⊞	0
90mm	0	⊞	0
110mm	0	⊞	0
160mm	0	⊞	0
200mm	0	⊞	0
250mm	0	⊞	0
280mm	0	⊞	0
315mm	0	⊞	0
355mm	0	⊞	0
400mm	0	⊞	0
450mm	0	⊞	0
500mm	0	⊞	0

LEGEND	
⊗	WELL
⊕	PILOT WELL
⊙	MONITORING BORE
⊛	WELLHEAD STATION - STANDARD
⊜	J TRAP
★	BAROMETRIC TRAP
⚡	ISOLATION VALVE
⚡	AIR RELIEF VALVE
⚡	PIT PUMPOUT
⚡	LEACHATE SUMP / RISER PIPES
⚡	STANDALONE WELL
⚡	METER RUN
OKOP	KNOCK OUT POT
⊞	DUAL PURPOSE WELL
⊞	FLARE / POWER STATION
A	WELLHEAD STATION NAME
A125	WELL NUMBER
MP1-1	MAIN GAS PIPE
●	HEADER MARKER
---	FENCE LINE
---	CELL BOUNDARY
---	COMMUNICATION
---	POWER
---	32mm AIR LINE
---	63mm AIR LINE
---	63mm LEACHATE LINE
---	90mm LEACHATE LINE
---	110mm LEACHATE LINE
---	125mm LEACHATE LINE
---	160mm LEACHATE LINE
---	200mm LEACHATE LINE
---	90mm HORIZONTAL WELL
---	90mm MAIN/LATERAL HEADER
---	125mm MAIN/LATERAL HEADER
---	140mm MAIN/LATERAL HEADER
---	160mm MAIN/LATERAL HEADER
---	180mm MAIN/LATERAL HEADER
---	200mm MAIN HEADER
---	225mm MAIN HEADER
---	250mm MAIN HEADER
---	280mm MAIN HEADER
---	315mm MAIN HEADER
---	355mm MAIN HEADER
---	400mm MAIN HEADER
---	450mm MAIN HEADER
---	500mm MAIN HEADER


69	ADDED RELIEF VALVE ON LEACHATE LINE TO LP34, 35, 40, 41	ZB	RB	RB	6/11/2024	64	ADDED MISSING VALVE IN STAGE 4	ZB	RB	RB	26/07/2024
68	ADDED LP49, AIR / LEACHATE LINES	ZB	RB	RB	29/10/2024	63	ADDED 450mm MAIN HEADER IN STAGE 4	ZB	RB	RB	8/07/2024
67	450mm HEADER BETWEEN STG3, STG4 RELOCATED.	ZB	RB	RB	13/09/2024	62	ADDED GCS INSTALLATION 100 x WELLS, HEADERS	ZB	RB	RB	3/07/2024
66	ADDED 2M WELL CONNECTIONS, ASBESTOS BOUNDARY	ZB	RB	RB	5/09/2024	61	ADDED AIR, LEACHATE, SUMPS IN CELLS 1,2 AND 3	ZB	RB	RB	11/06/2024
65	ADDED HORIZONTALS IN CELL 1	ZB	RB	RB	16/08/2024	60	REROUTED STAGE 3 AIR/LEACHATE LINES TO LP28R	ZB	RB	RB	12/04/2024
REV	DESCRIPTION	BY	CKD	APP	DATE	REV	DESCRIPTION	BY	CKD	APP	DATE
REVISION HISTORY						REVISION HISTORY					



199C OSBORNE AVE, CLAYTON STH, VIC 3169
PH: (03) 9538 6200
www.runenergy.com

PROJECT:	MELBOURNE REGIONAL LANDFILL
DRAWING TITLE:	MRL ASBUILT SITE LAYOUT

DRAWING No:		MRL-GCS-001	
DRAWING TYPE:		AS BUILT	
DRAWN: ZB		CKD: RB	
DATE: 06/11/2024		APP: RB	
DESIGNED: RB		APP DATE: 06/11/2024	
SCALE: 1:3400	SHEET: 1 of 3	REV: 69	SIZE: A1

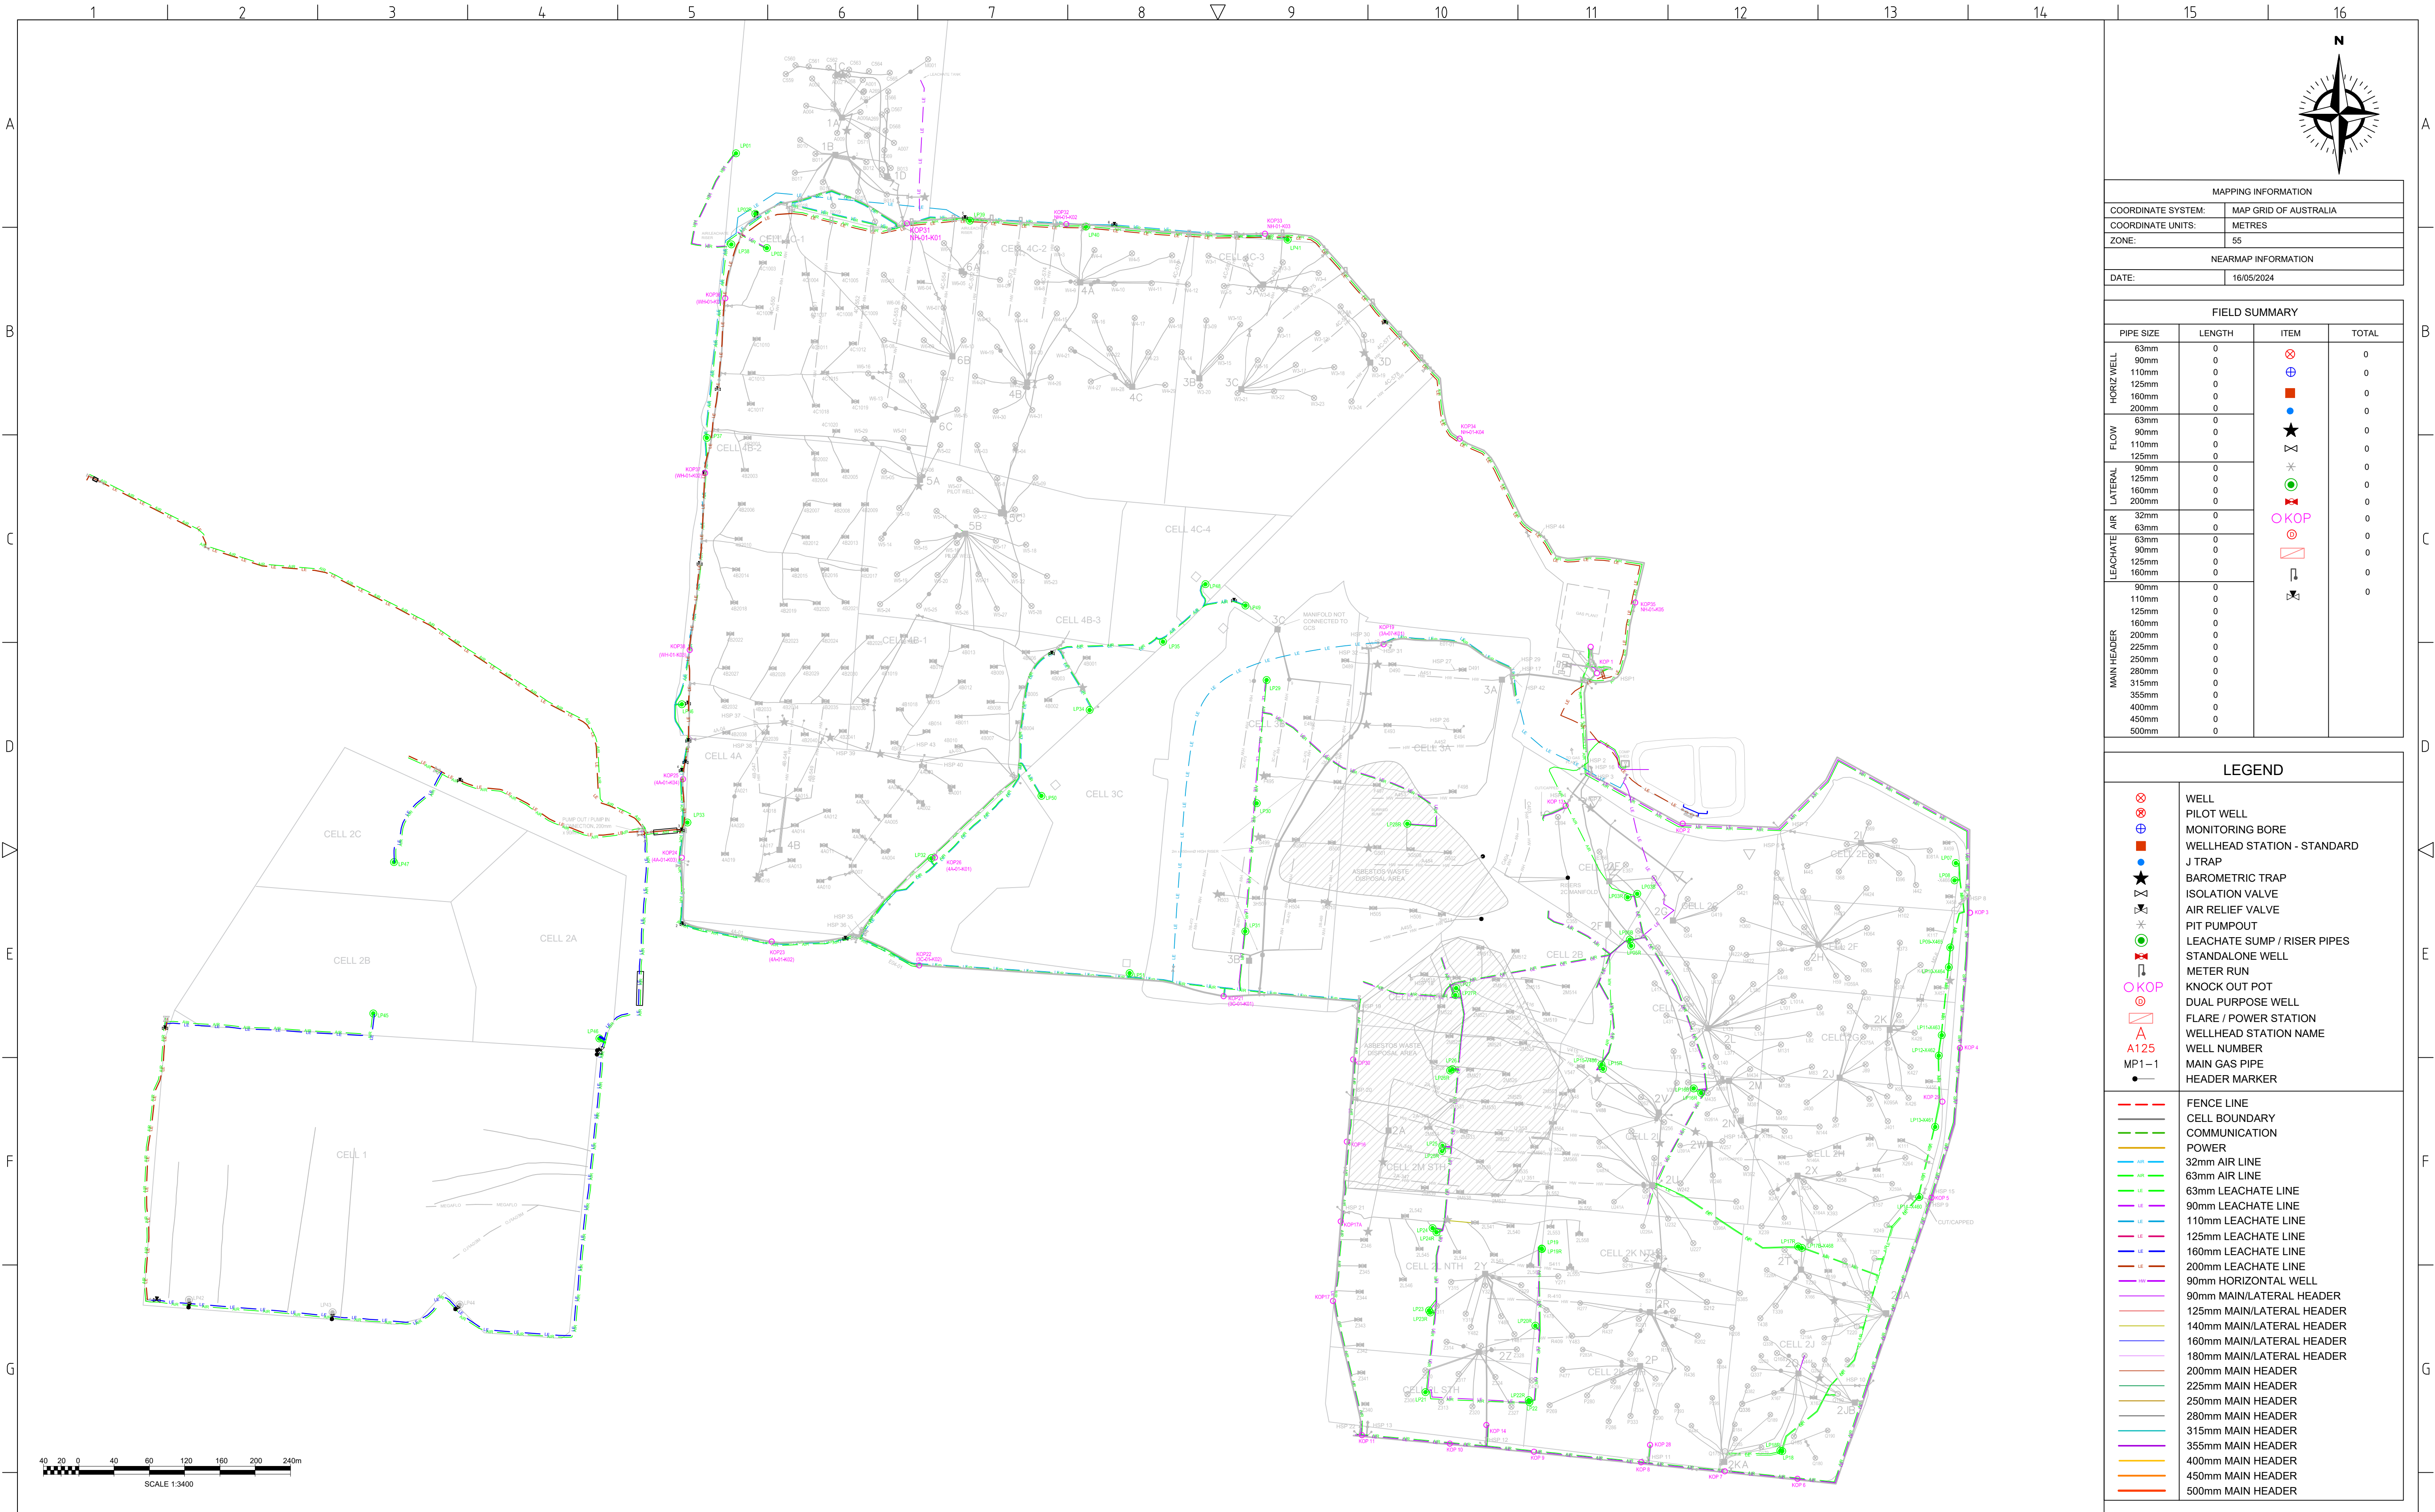

MAPPING INFORMATION	
COORDINATE SYSTEM:	MAP GRID OF AUSTRALIA
COORDINATE UNITS:	METRES
ZONE:	55
NEARMAP INFORMATION	
DATE:	16/05/2024

FIELD SUMMARY			
PIPE SIZE	LENGTH	ITEM	TOTAL
HORIZ WELL	63mm	⊗	0
	90mm	⊕	0
	110mm	⊕	0
	125mm	⊕	0
	160mm	⊕	0
FLOW	63mm	★	0
	90mm	★	0
	110mm	★	0
	125mm	★	0
	160mm	★	0
LATERAL	90mm	⊕	0
	125mm	⊕	0
	160mm	⊕	0
	200mm	⊕	0
	250mm	⊕	0
AIR	32mm	OKOP	0
	63mm	OKOP	0
	90mm	OKOP	0
	125mm	OKOP	0
	160mm	OKOP	0
LEACHATE	90mm	⊕	0
	110mm	⊕	0
	125mm	⊕	0
	160mm	⊕	0
	200mm	⊕	0
	225mm	⊕	0
	250mm	⊕	0
	280mm	⊕	0
	315mm	⊕	0
	355mm	⊕	0
MAIN HEADER	400mm	⊕	0
	450mm	⊕	0
	500mm	⊕	0
	500mm	⊕	0
	500mm	⊕	0

LEGEND	
⊗	WELL
⊕	PILOT WELL
⊕	MONITORING BORE
⊕	WELLHEAD STATION - STANDARD
⊕	J TRAP
★	BAROMETRIC TRAP
★	ISOLATION VALVE
★	AIR RELIEF VALVE
★	PIT PUMPOUT
★	LEACHATE SUMP / RISER PIPES
★	STANDALONE WELL
OKOP	METER RUN
OKOP	KNOCK OUT POT
OKOP	DUAL PURPOSE WELL
OKOP	FLARE / POWER STATION
OKOP	WELLHEAD STATION NAME
A125	WELL NUMBER
MP1-1	MAIN GAS PIPE
●	HEADER MARKER
---	FENCE LINE
---	CELL BOUNDARY
---	COMMUNICATION
---	POWER
---	32mm AIR LINE
---	63mm AIR LINE
---	63mm LEACHATE LINE
---	90mm LEACHATE LINE
---	110mm LEACHATE LINE
---	125mm LEACHATE LINE
---	160mm LEACHATE LINE
---	200mm LEACHATE LINE
---	90mm HORIZONTAL WELL
---	90mm MAIN/LATERAL HEADER
---	125mm MAIN/LATERAL HEADER
---	140mm MAIN/LATERAL HEADER
---	160mm MAIN/LATERAL HEADER
---	180mm MAIN/LATERAL HEADER
---	200mm MAIN HEADER
---	225mm MAIN HEADER
---	250mm MAIN HEADER
---	280mm MAIN HEADER
---	315mm MAIN HEADER
---	355mm MAIN HEADER
---	400mm MAIN HEADER
---	450mm MAIN HEADER
---	500mm MAIN HEADER


69	ADDED RELIEF VALVE ON LEACHATE LINE TO LP34, 35, 40, 41	ZB	RB	RB	6/11/2024	64	ADDED MISSING VALVE IN STAGE 4	ZB	RB	RB	26/07/2024
68	ADDED LP49, AIR / LEACHATE LINES	ZB	RB	RB	29/10/2024	63	ADDED 450mm MAIN HEADER IN STAGE 4	ZB	RB	RB	8/07/2024
67	450mm HEADER BETWEEN STG3, STG4 RELOCATED.	ZB	RB	RB	13/09/2024	62	ADDED GCS INSTALLATION 100 x WELLS, HEADERS	ZB	RB	RB	3/07/2024
66	ADDED 2M WELL CONNECTIONS, ASBESTOS BOUNDARY	ZB	RB	RB	5/09/2024	61	ADDED AIR, LEACHATE, SUMPS IN CELLS 1,2 AND 3	ZB	RB	RB	11/06/2024
65	ADDED HORIZONTALS IN CELL 1	ZB	RB	RB	16/08/2024	60	REROUTED STAGE 3 AIR/LEACHATE LINES TO LP28R	ZB	RB	RB	12/04/2024
REV	DESCRIPTION	BY	CKD	APP	DATE	REV	DESCRIPTION	BY	CKD	APP	DATE
REVISION HISTORY						REVISION HISTORY					



199C OSBORNE AVE, CLAYTON STH, VIC 3169
PH: (03) 9558 6200
www.runenergy.com

PROJECT:	MELBOURNE REGIONAL LANDFILL
DRAWING TITLE:	MRL-GCS_LEACHATE EXTRACTION SITE LAYOUT

DRAWING No:		MRL-GCS-001	
DRAWING TYPE:		AS BUILT	
DRAWN: ZB		CKD: RB	
DATE: 06/11/2024		APP: RB	
DESIGNED: RB		APP DATE: 06/11/2024	
SCALE: 1:3400	SHEET: 2 of 3	REV: 69	SIZE: A1
15		16	

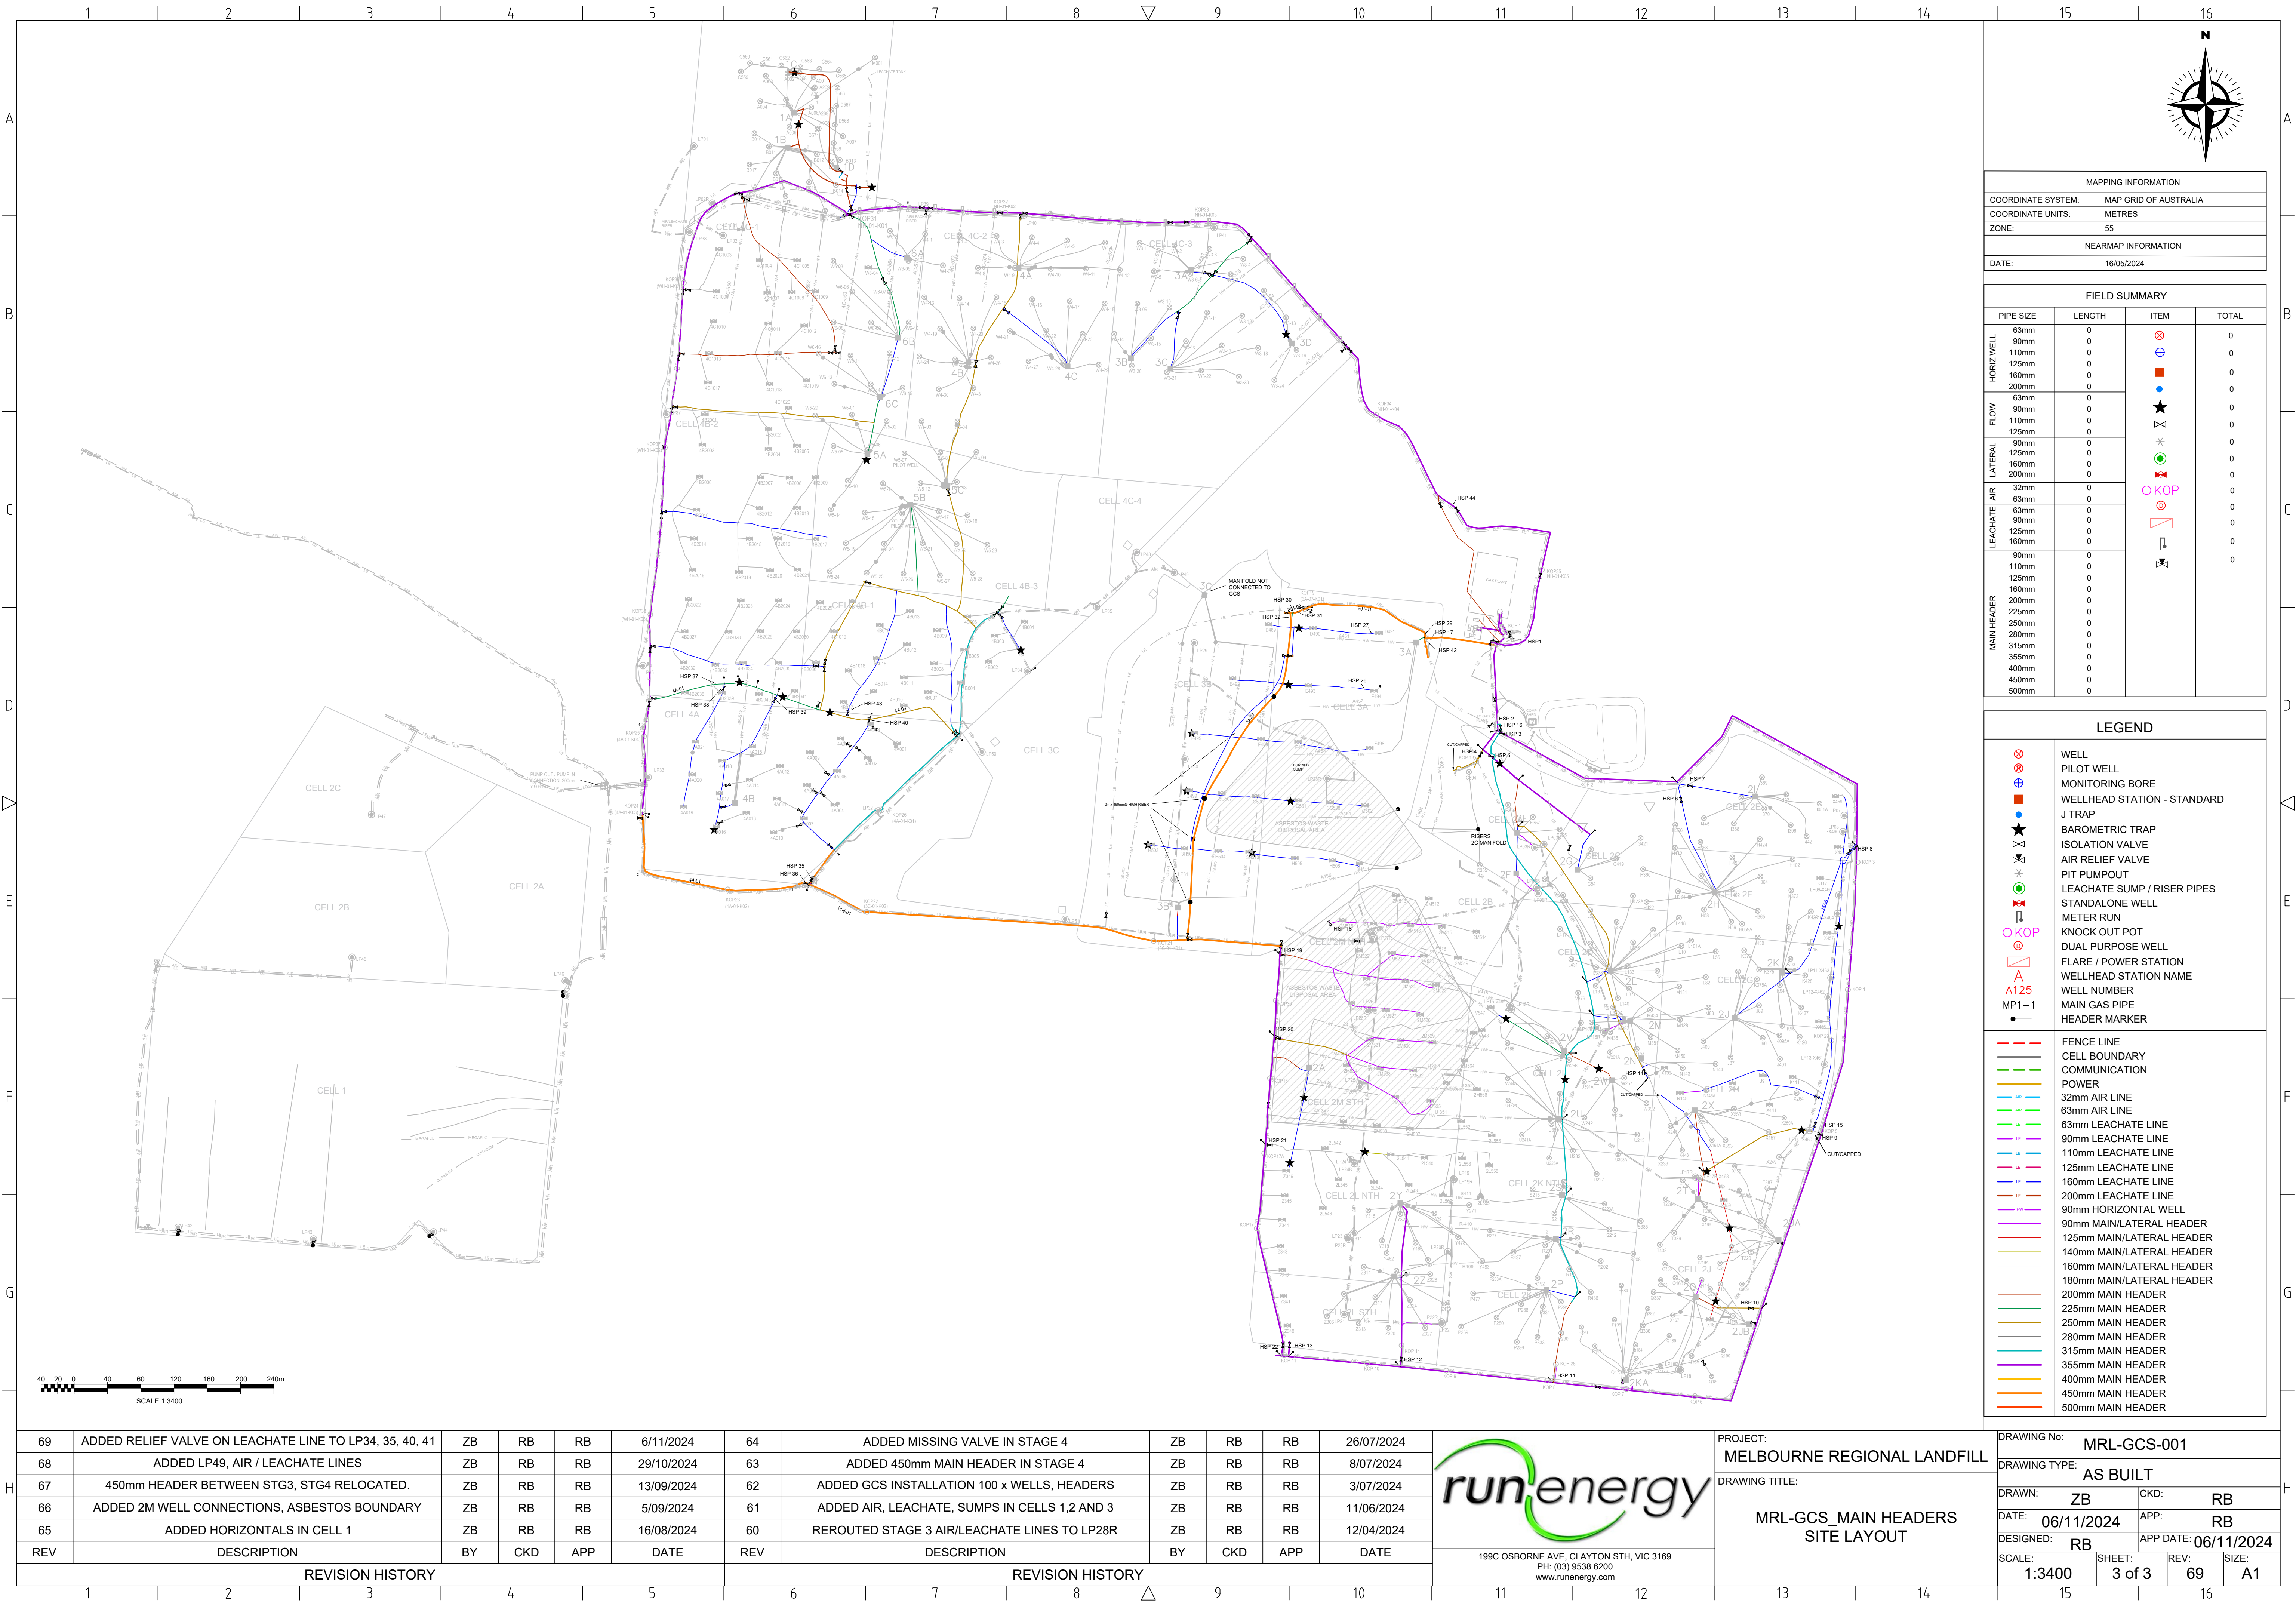

MAPPING INFORMATION	
COORDINATE SYSTEM:	MAP GRID OF AUSTRALIA
COORDINATE UNITS:	METRES
ZONE:	55
NEARMAP INFORMATION	
DATE:	16/05/2024

FIELD SUMMARY			
PIPE SIZE	LENGTH	ITEM	TOTAL
HORIZ WELL	63mm	⊗	0
	90mm	⊕	0
	110mm	⊕	0
	125mm	⊕	0
	160mm	⊕	0
FLOW	63mm	★	0
	90mm	★	0
	110mm	★	0
	125mm	★	0
	160mm	★	0
LATERAL	90mm	⊗	0
	125mm	⊗	0
	160mm	⊗	0
	200mm	⊗	0
	250mm	⊗	0
AIR	32mm	OKOP	0
	63mm	OKOP	0
	90mm	OKOP	0
	125mm	OKOP	0
	160mm	OKOP	0
LEACHATE	90mm	⊕	0
	110mm	⊕	0
	125mm	⊕	0
	160mm	⊕	0
	200mm	⊕	0
MAIN HEADER	225mm	⊕	0
	280mm	⊕	0
	315mm	⊕	0
	355mm	⊕	0
	400mm	⊕	0
	450mm	⊕	0
	500mm	⊕	0
	90mm	⊕	0
	110mm	⊕	0
	125mm	⊕	0

LEGEND	
⊗	WELL
⊕	PILOT WELL
⊕	MONITORING BORE
⊕	WELLHEAD STATION - STANDARD
⊕	J TRAP
★	BAROMETRIC TRAP
⊕	ISOLATION VALVE
⊕	AIR RELIEF VALVE
⊕	PIT PUMPOUT
⊕	LEACHATE SUMP / RISER PIPES
⊕	STANDALONE WELL
⊕	METER RUN
OKOP	KNOCK OUT POT
⊕	DUAL PURPOSE WELL
⊕	FLARE / POWER STATION
A	WELLHEAD STATION NAME
A125	WELL NUMBER
MP1-1	MAIN GAS PIPE
●	HEADER MARKER
---	FENCE LINE
---	CELL BOUNDARY
---	COMMUNICATION
---	POWER
---	32mm AIR LINE
---	63mm AIR LINE
---	63mm LEACHATE LINE
---	90mm LEACHATE LINE
---	110mm LEACHATE LINE
---	125mm LEACHATE LINE
---	160mm LEACHATE LINE
---	200mm LEACHATE LINE
---	90mm HORIZONTAL WELL
---	90mm MAIN/LATERAL HEADER
---	125mm MAIN/LATERAL HEADER
---	140mm MAIN/LATERAL HEADER
---	160mm MAIN/LATERAL HEADER
---	180mm MAIN/LATERAL HEADER
---	200mm MAIN HEADER
---	225mm MAIN HEADER
---	250mm MAIN HEADER
---	280mm MAIN HEADER
---	315mm MAIN HEADER
---	355mm MAIN HEADER
---	400mm MAIN HEADER
---	450mm MAIN HEADER
---	500mm MAIN HEADER

69	ADDED RELIEF VALVE ON LEACHATE LINE TO LP34, 35, 40, 41	ZB	RB	RB	6/11/2024	64	ADDED MISSING VALVE IN STAGE 4	ZB	RB	RB	26/07/2024
68	ADDED LP49, AIR / LEACHATE LINES	ZB	RB	RB	29/10/2024	63	ADDED 450mm MAIN HEADER IN STAGE 4	ZB	RB	RB	8/07/2024
67	450mm HEADER BETWEEN STG3, STG4 RELOCATED.	ZB	RB	RB	13/09/2024	62	ADDED GCS INSTALLATION 100 x WELLS, HEADERS	ZB	RB	RB	3/07/2024
66	ADDED 2M WELL CONNECTIONS, ASBESTOS BOUNDARY	ZB	RB	RB	5/09/2024	61	ADDED AIR, LEACHATE, SUMPS IN CELLS 1,2 AND 3	ZB	RB	RB	11/06/2024
65	ADDED HORIZONTALS IN CELL 1	ZB	RB	RB	16/08/2024	60	REROUTED STAGE 3 AIR/LEACHATE LINES TO LP28R	ZB	RB	RB	12/04/2024
REV	DESCRIPTION	BY	CKD	APP	DATE	REV	DESCRIPTION	BY	CKD	APP	DATE



199C OSBORNE AVE, CLAYTON STH, VIC 3169
PH: (03) 9558 6200
www.runenergy.com

PROJECT:	MELBOURNE REGIONAL LANDFILL
DRAWING TITLE:	MRL-GCS_MAIN HEADERS SITE LAYOUT

DRAWING No:		MRL-GCS-001	
DRAWING TYPE:		AS BUILT	
DRAWN:	ZB	CKD:	RB
DATE:	06/11/2024	APP:	RB
DESIGNED:	RB	APP DATE:	06/11/2024
SCALE:	1:3400	SHEET:	3 of 3
		REV:	69
		SIZE:	A1