


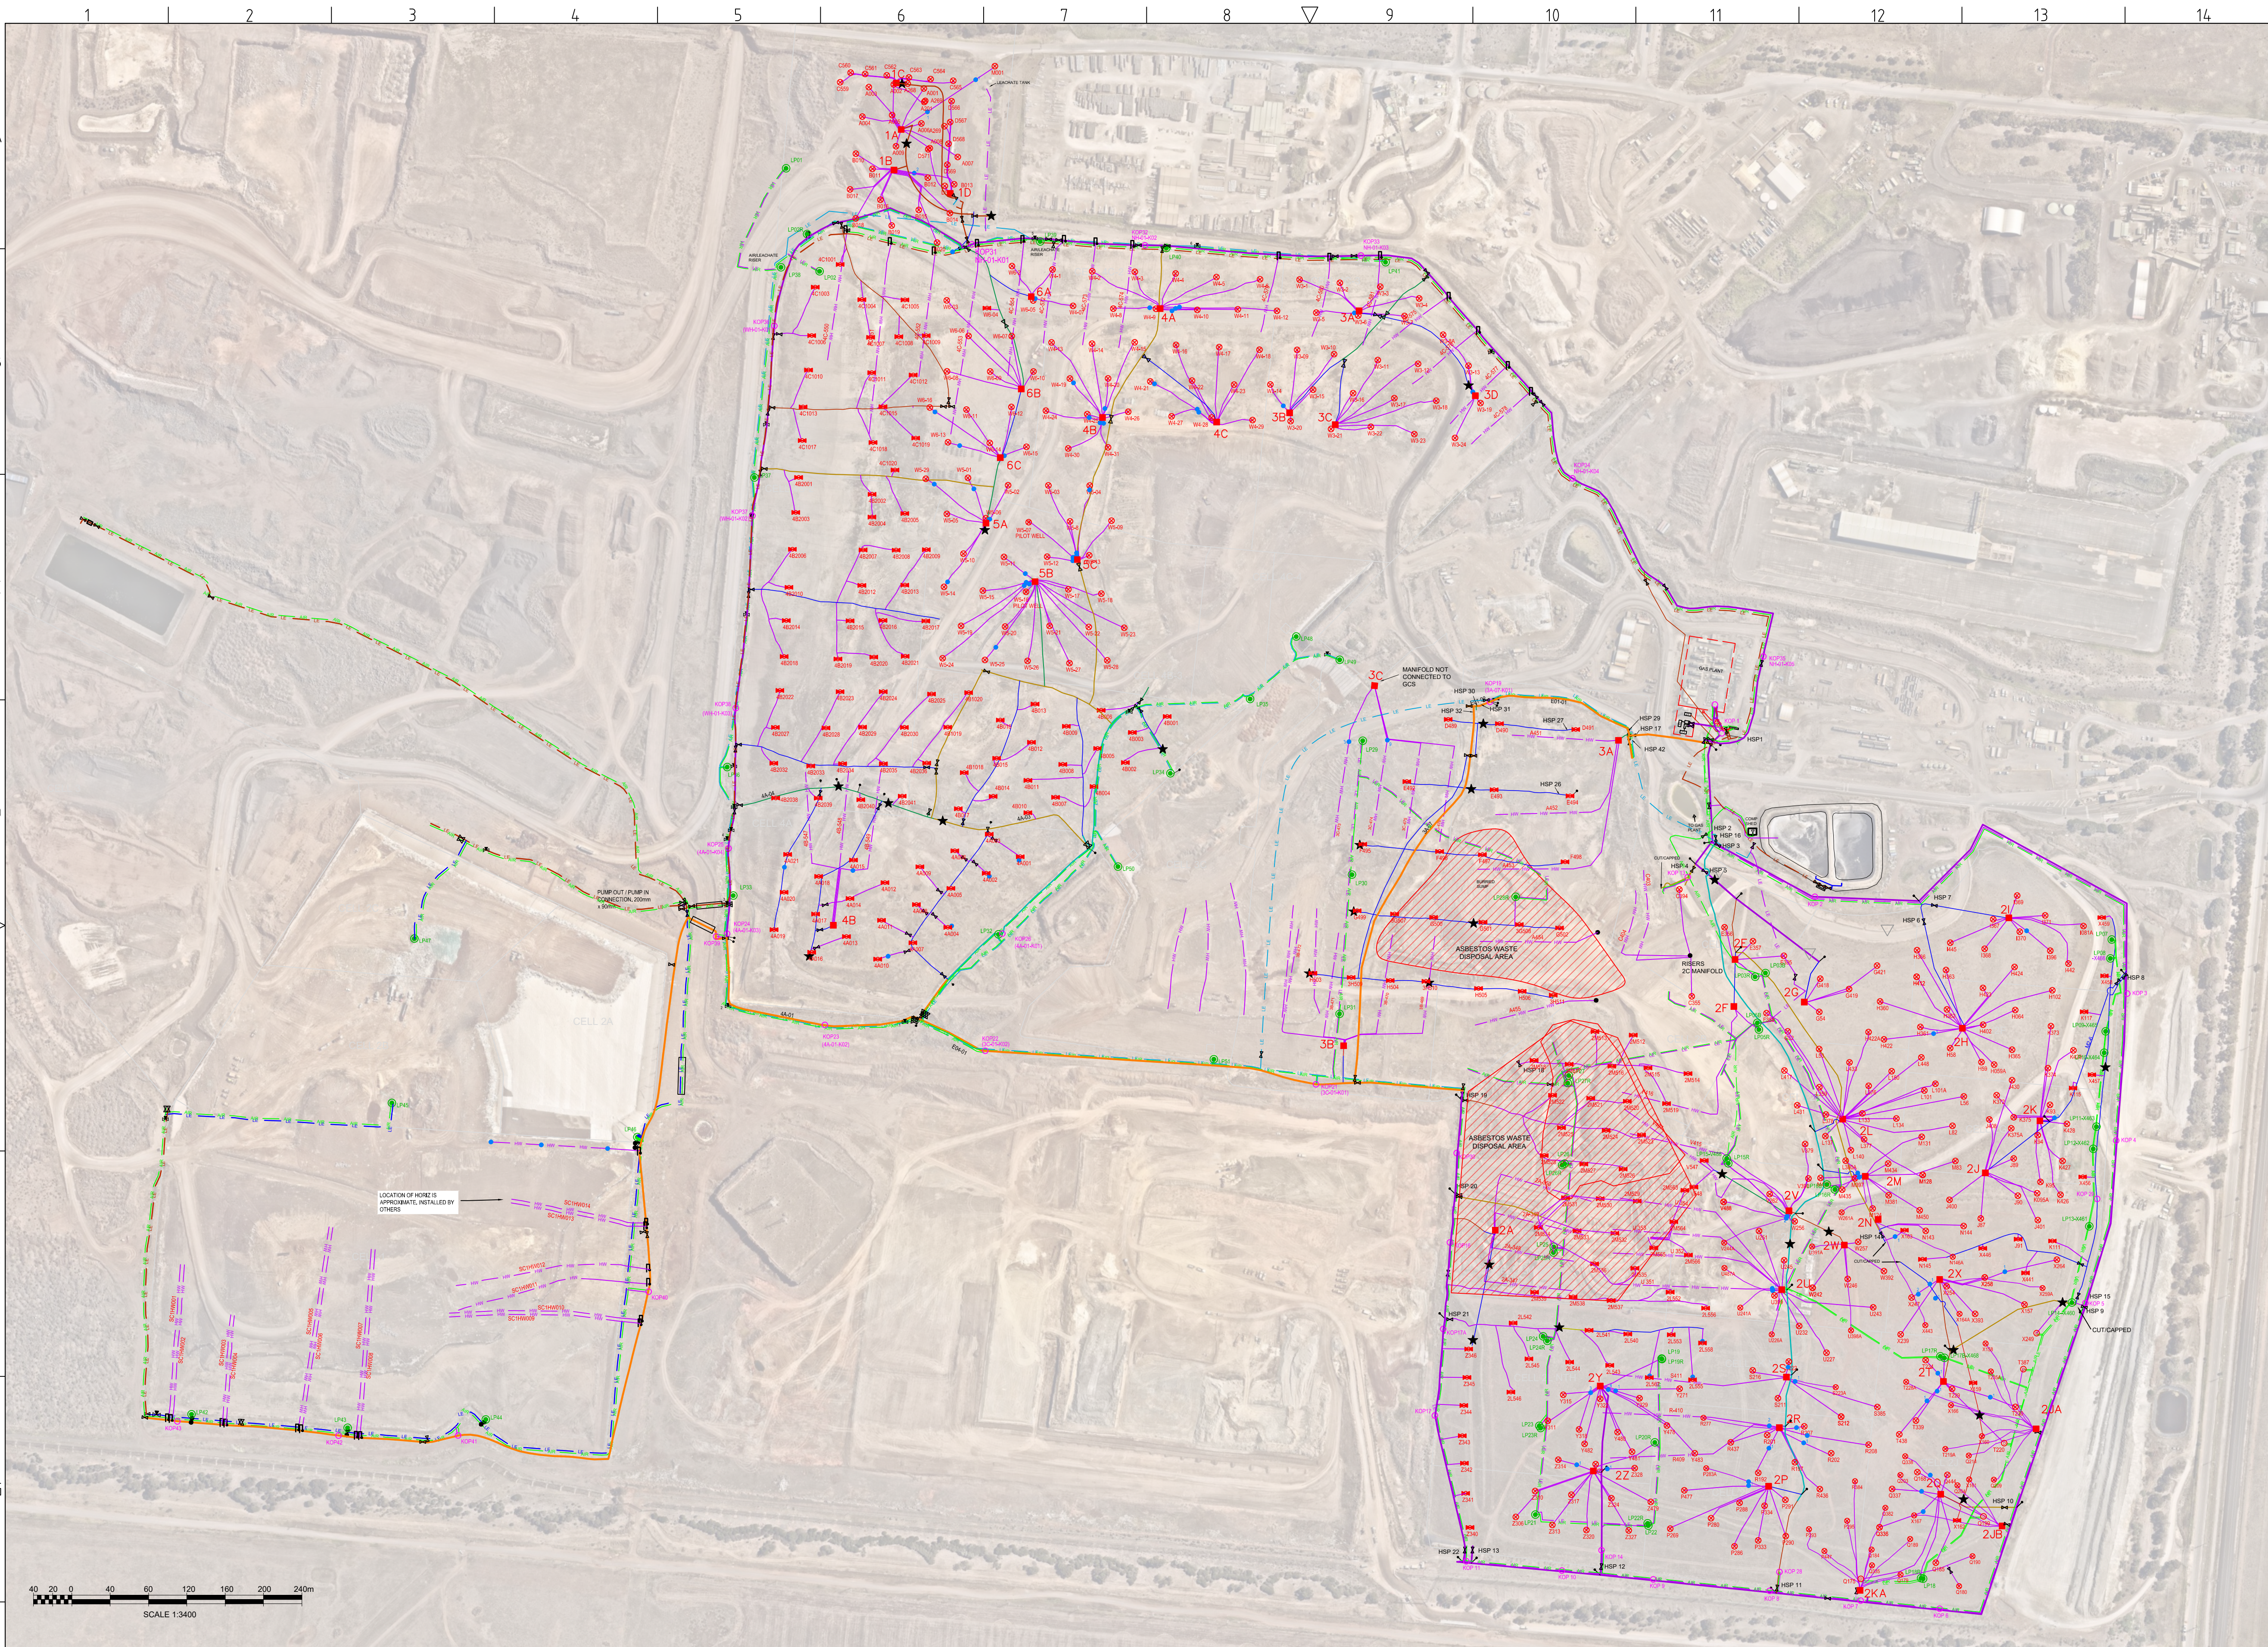

| MAPPING INFORMATION |                       |
|---------------------|-----------------------|
| COORDINATE SYSTEM:  | MAP GRID OF AUSTRALIA |
| COORDINATE UNITS:   | METRES                |
| ZONE:               | 55                    |
| NEARMAP INFORMATION |                       |
| DATE:               | 01/12/2024            |

| FIELD SUMMARY |        |      |       |
|---------------|--------|------|-------|
| PIPE SIZE     | LENGTH | ITEM | TOTAL |
| HORIZ WEL     | 63mm   | ⊗    | 0     |
|               | 90mm   | ⊕    | 0     |
|               | 110mm  | ⊗    | 0     |
|               | 125mm  | ⊕    | 0     |
|               | 160mm  | ⊗    | 0     |
| FLOW          | 200mm  | ●    | 0     |
|               | 63mm   | ★    | 0     |
|               | 90mm   | ⚡    | 0     |
|               | 110mm  | ⚡    | 0     |
|               | 125mm  | ⚡    | 0     |
| LATERAL       | 90mm   | ⚡    | 0     |
|               | 125mm  | ⚡    | 0     |
|               | 160mm  | ⚡    | 0     |
|               | 200mm  | ⚡    | 0     |
|               | 32mm   | ⚡    | 0     |
| AIR           | 63mm   | ⚡    | 0     |
|               | 90mm   | ⚡    | 0     |
|               | 110mm  | ⚡    | 0     |
|               | 160mm  | ⚡    | 0     |
|               | 200mm  | ⚡    | 0     |
| LEACHATE      | 90mm   | ⚡    | 0     |
|               | 110mm  | ⚡    | 0     |
|               | 125mm  | ⚡    | 0     |
|               | 160mm  | ⚡    | 0     |
|               | 200mm  | ⚡    | 0     |
|               | 250mm  | ⚡    | 0     |
|               | 280mm  | ⚡    | 0     |
|               | 315mm  | ⚡    | 0     |
|               | 355mm  | ⚡    | 0     |
|               | 400mm  | ⚡    | 0     |
| MAIN HEADER   | 450mm  | ⚡    | 0     |
|               | 500mm  | ⚡    | 0     |


| LEGEND |                             |
|--------|-----------------------------|
| ⊗      | WELL                        |
| ⊕      | PILOT WELL                  |
| ⊗      | MONITORING BORE             |
| ⊕      | WELLHEAD STATION - STANDARD |
| ⊗      | J TRAP                      |
| ★      | BAROMETRIC TRAP             |
| ⚡      | ISOLATION VALVE             |
| ⚡      | AIR RELIEF VALVE            |
| ⚡      | PIT PUMPOUT                 |
| ⚡      | LEACHATE SUMP / RISER PIPES |
| ⚡      | STANDALONE WELL             |
| ⚡      | METER RUN                   |
| ⚡      | KNOCK OUT POT               |
| ⚡      | DUAL PURPOSE WELL           |
| ⚡      | FLARE / POWER STATION       |
| ⚡      | WELLHEAD STATION NAME       |
| A125   | WELL NUMBER                 |
| MP1-1  | MAIN GAS PIPE               |
| ●      | HEADER MARKER               |

|     |                           |
|-----|---------------------------|
| --- | FENCE LINE                |
| --- | CELL BOUNDARY             |
| --- | COMMUNICATION             |
| --- | POWER                     |
| --- | 32mm AIR LINE             |
| --- | 63mm AIR LINE             |
| --- | 63mm LEACHATE LINE        |
| --- | 90mm LEACHATE LINE        |
| --- | 110mm LEACHATE LINE       |
| --- | 125mm LEACHATE LINE       |
| --- | 160mm LEACHATE LINE       |
| --- | 200mm LEACHATE LINE       |
| --- | 90mm HORIZONTAL WELL      |
| --- | 90mm MAIN/LATERAL HEADER  |
| --- | 125mm MAIN/LATERAL HEADER |
| --- | 140mm MAIN/LATERAL HEADER |
| --- | 160mm MAIN/LATERAL HEADER |
| --- | 180mm MAIN/LATERAL HEADER |
| --- | 200mm MAIN HEADER         |
| --- | 225mm MAIN HEADER         |
| --- | 250mm MAIN HEADER         |
| --- | 280mm MAIN HEADER         |
| --- | 315mm MAIN HEADER         |
| --- | 355mm MAIN HEADER         |
| --- | 400mm MAIN HEADER         |
| --- | 450mm MAIN HEADER         |
| --- | 500mm MAIN HEADER         |

|     |                                                         |    |     |     |            |     |                                              |    |     |     |            |
|-----|---------------------------------------------------------|----|-----|-----|------------|-----|----------------------------------------------|----|-----|-----|------------|
| 71  | ADDED HORIZONTAL WELL INSTALLATION                      | ZB | RB  | RB  | 5/03/2025  | 66  | ADDED 2M WELL CONNECTIONS, ASBESTOS BOUNDARY | ZB | RB  | RB  | 5/09/2024  |
| 70  | ADDED CELL 1 GCS INSTALLATION                           | ZB | RB  | RB  | 7/01/2025  | 65  | ADDED HORIZONTALS IN CELL 1                  | ZB | RB  | RB  | 16/08/2024 |
| 69  | ADDED RELIEF VALVE ON LEACHATE LINE TO LP34, 35, 40, 41 | ZB | RB  | RB  | 6/11/2024  | 64  | ADDED MISSING VALVE IN STAGE 4               | ZB | RB  | RB  | 26/07/2024 |
| 68  | ADDED LP49, AIR / LEACHATE LINES                        | ZB | RB  | RB  | 29/10/2024 | 63  | ADDED 450mm MAIN HEADER IN STAGE 4           | ZB | RB  | RB  | 8/07/2024  |
| 67  | 450mm HEADER BETWEEN STG3, STG4 RELOCATED.              | ZB | RB  | RB  | 13/09/2024 | 62  | ADDED GCS INSTALLATION 100 x WELLS, HEADERS  | ZB | RB  | RB  | 3/07/2024  |
| REV | DESCRIPTION                                             | BY | CKD | APP | DATE       | REV | DESCRIPTION                                  | BY | CKD | APP | DATE       |


REVISION HISTORY

REVISION HISTORY

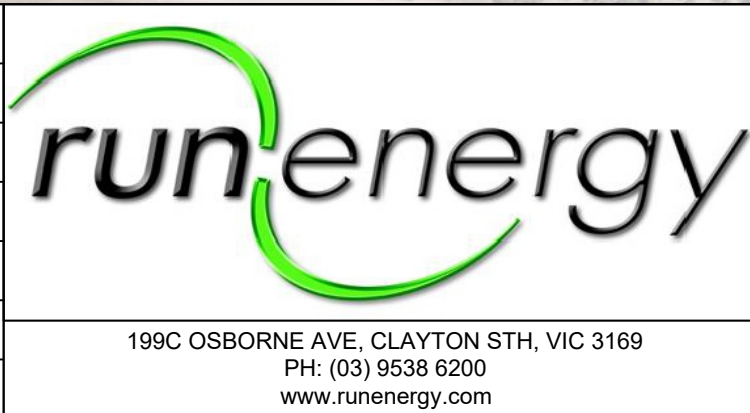

|                |                             |
|----------------|-----------------------------|
| PROJECT:       | MELBOURNE REGIONAL LANDFILL |
| DRAWING TITLE: | MRL ASBUILT SITE LAYOUT     |

|               |            |             |            |
|---------------|------------|-------------|------------|
| DRAWING No:   |            | MRL-GCS-001 |            |
| DRAWING TYPE: |            | AS BUILT    |            |
| DRAWN:        | ZB         | CKD:        | RB         |
| DATE:         | 05/03/2025 | APP:        | RB         |
| DESIGNED:     | RB         | APP DATE:   | 05/03/2025 |
| SCALE:        | 1:3400     | SHEET:      | 1 of 3     |
|               |            | REV:        | 71         |
|               |            | SIZE:       | A1         |

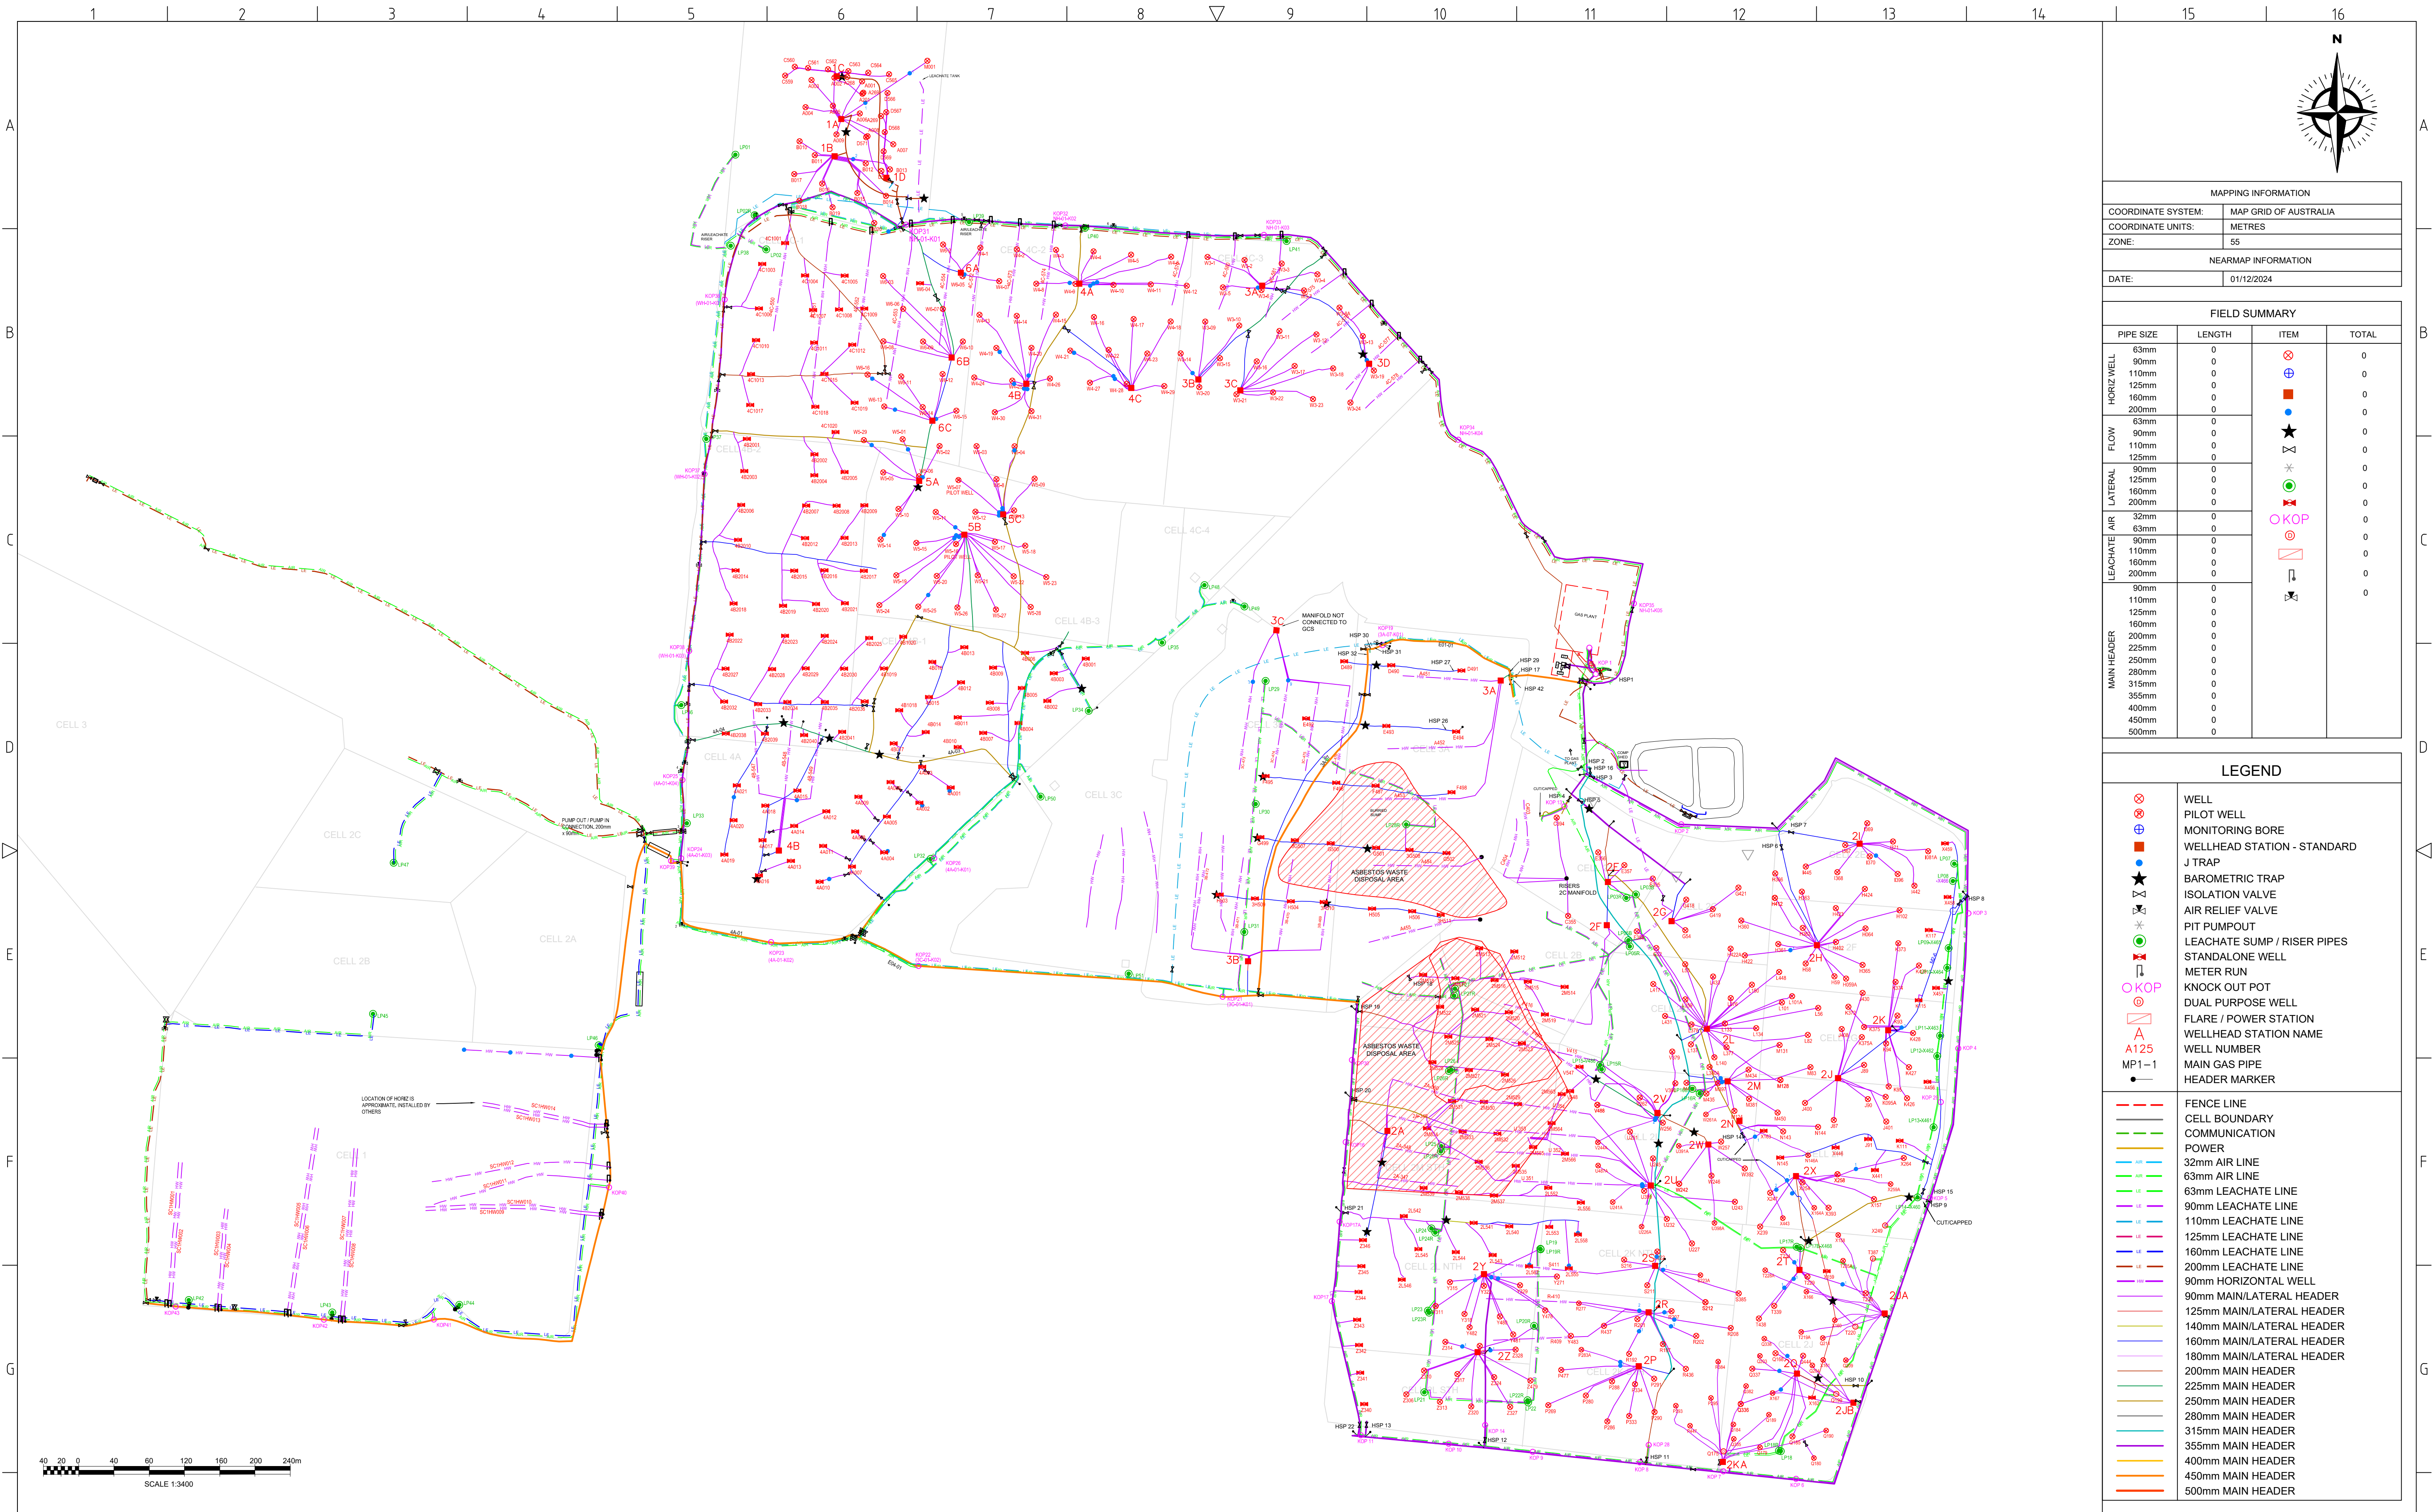

|                  |                                                         |    |     |     |            |                  |                                              |    |     |     |            |
|------------------|---------------------------------------------------------|----|-----|-----|------------|------------------|----------------------------------------------|----|-----|-----|------------|
| 71               | ADDED HORIZONTAL WELL INSTALLATION                      | ZB | RB  | RB  | 5/03/2025  | 66               | ADDED 2M WELL CONNECTIONS, ASBESTOS BOUNDARY | ZB | RB  | RB  | 5/09/2024  |
| 70               | ADDED CELL 1 GCS INSTALLATION                           | ZB | RB  | RB  | 7/01/2025  | 65               | ADDED HORIZONTALS IN CELL 1                  | ZB | RB  | RB  | 16/08/2024 |
| 69               | ADDED RELIEF VALVE ON LEACHATE LINE TO LP34, 35, 40, 41 | ZB | RB  | RB  | 6/11/2024  | 64               | ADDED MISSING VALVE IN STAGE 4               | ZB | RB  | RB  | 26/07/2024 |
| 68               | ADDED LP49, AIR / LEACHATE LINES                        | ZB | RB  | RB  | 29/10/2024 | 63               | ADDED 450mm MAIN HEADER IN STAGE 4           | ZB | RB  | RB  | 8/07/2024  |
| 67               | 450mm HEADER BETWEEN STG3, STG4 RELOCATED.              | ZB | RB  | RB  | 13/09/2024 | 62               | ADDED GCS INSTALLATION 100 x WELLS, HEADERS  | ZB | RB  | RB  | 3/07/2024  |
| REV              | DESCRIPTION                                             | BY | CKD | APP | DATE       | REV              | DESCRIPTION                                  | BY | CKD | APP | DATE       |
| REVISION HISTORY |                                                         |    |     |     |            | REVISION HISTORY |                                              |    |     |     |            |



199C OSBORNE AVE, CLAYTON STH, VIC 3169  
PH: (03) 9558 6200  
www.runenergy.com


PROJECT:  
MELBOURNE REGIONAL LANDFILL

DRAWING TITLE:  
MRL ASBUILT  
SITE LAYOUT

DRAWING No: MRL-GCS-001

DRAWING TYPE: AS BUILT

|                  |                      |
|------------------|----------------------|
| DRAWN: ZB        | CKD: RB              |
| DATE: 05/03/2025 | APP: RB              |
| DESIGNED: RB     | APP DATE: 05/03/2025 |
| SCALE: 1:3400    | SHEET: 1 of 3        |
|                  | REV: 71              |
|                  | SIZE: A1             |

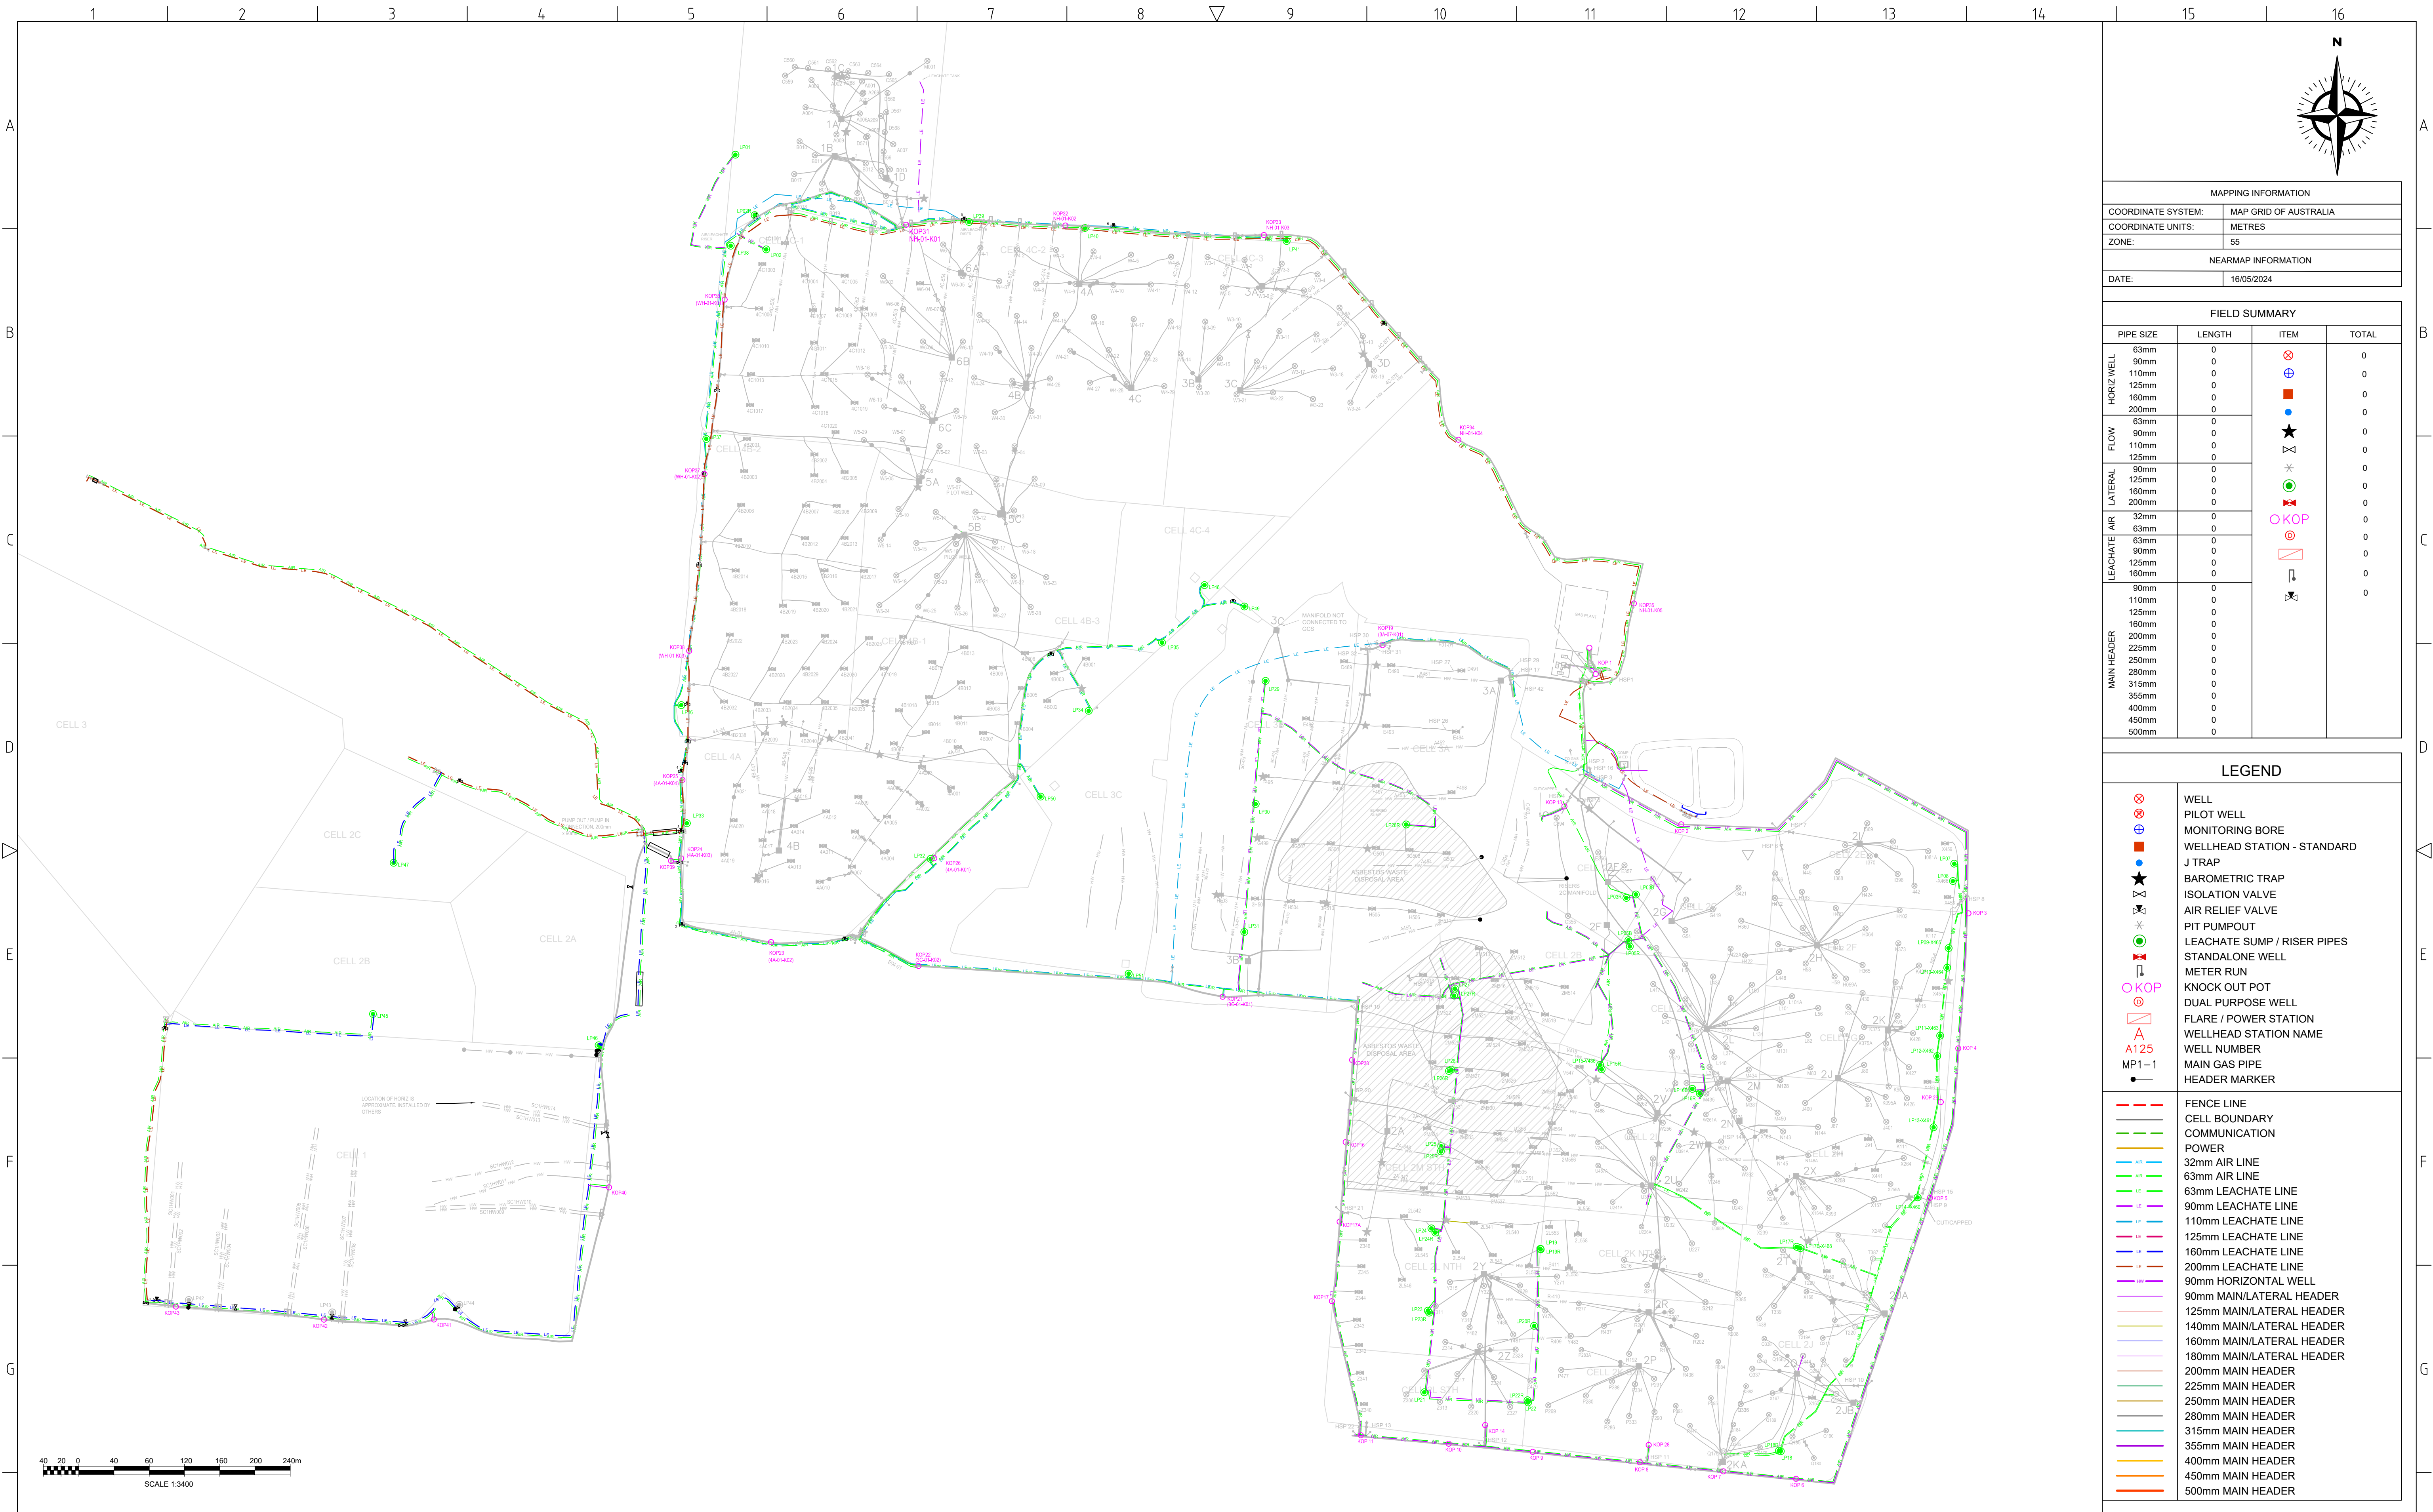



|                  |                                                         |    |     |     |            |                  |                                              |    |     |     |            |
|------------------|---------------------------------------------------------|----|-----|-----|------------|------------------|----------------------------------------------|----|-----|-----|------------|
| 71               | ADDED HORIZONTAL WELL INSTALLATION                      | ZB | RB  | RB  | 5/03/2025  | 66               | ADDED 2M WELL CONNECTIONS, ASBESTOS BOUNDARY | ZB | RB  | RB  | 5/09/2024  |
| 70               | ADDED CELL 1 GCS INSTALLATION                           | ZB |     |     | 7/01/2025  | 65               | ADDED HORIZONTALS IN CELL 1                  | ZB | RB  | RB  | 16/08/2024 |
| 69               | ADDED RELIEF VALVE ON LEACHATE LINE TO LP34, 35, 40, 41 | ZB | RB  | RB  | 6/11/2024  | 64               | ADDED MISSING VALVE IN STAGE 4               | ZB | RB  | RB  | 26/07/2024 |
| 68               | ADDED LP49, AIR / LEACHATE LINES                        | ZB | RB  | RB  | 29/10/2024 | 63               | ADDED 450mm MAIN HEADER IN STAGE 4           | ZB | RB  | RB  | 8/07/2024  |
| 67               | 450mm HEADER BETWEEN STG3, STG4 RELOCATED.              | ZB | RB  | RB  | 13/09/2024 | 62               | ADDED GCS INSTALLATION 100 x WELLS, HEADERS  | ZB | RB  | RB  | 3/07/2024  |
| REV              | DESCRIPTION                                             | BY | CKD | APP | DATE       | REV              | DESCRIPTION                                  | BY | CKD | APP | DATE       |
| REVISION HISTORY |                                                         |    |     |     |            | REVISION HISTORY |                                              |    |     |     |            |

199C OSBORNE AVE, CLAYTON STH, VIC 3169  
PH: (03) 9558 6200  
www.runenergy.com

|                |                                         |
|----------------|-----------------------------------------|
| PROJECT:       | MELBOURNE REGIONAL LANDFILL             |
| DRAWING TITLE: | MRL-GCS_LEACHATE EXTRACTION SITE LAYOUT |

|               |            |             |            |
|---------------|------------|-------------|------------|
| DRAWING No:   |            | MRL-GCS-001 |            |
| DRAWING TYPE: |            | AS BUILT    |            |
| DRAWN:        | ZB         | CKD:        | RB         |
| DATE:         | 05/03/2025 | APP:        | RB         |
| DESIGNED:     | RB         | APP DATE:   | 05/03/2025 |
| SCALE:        | 1:3400     | SHEET:      | 2 of 3     |
|               |            | REV:        | 71         |
|               |            | SIZE:       | A1         |

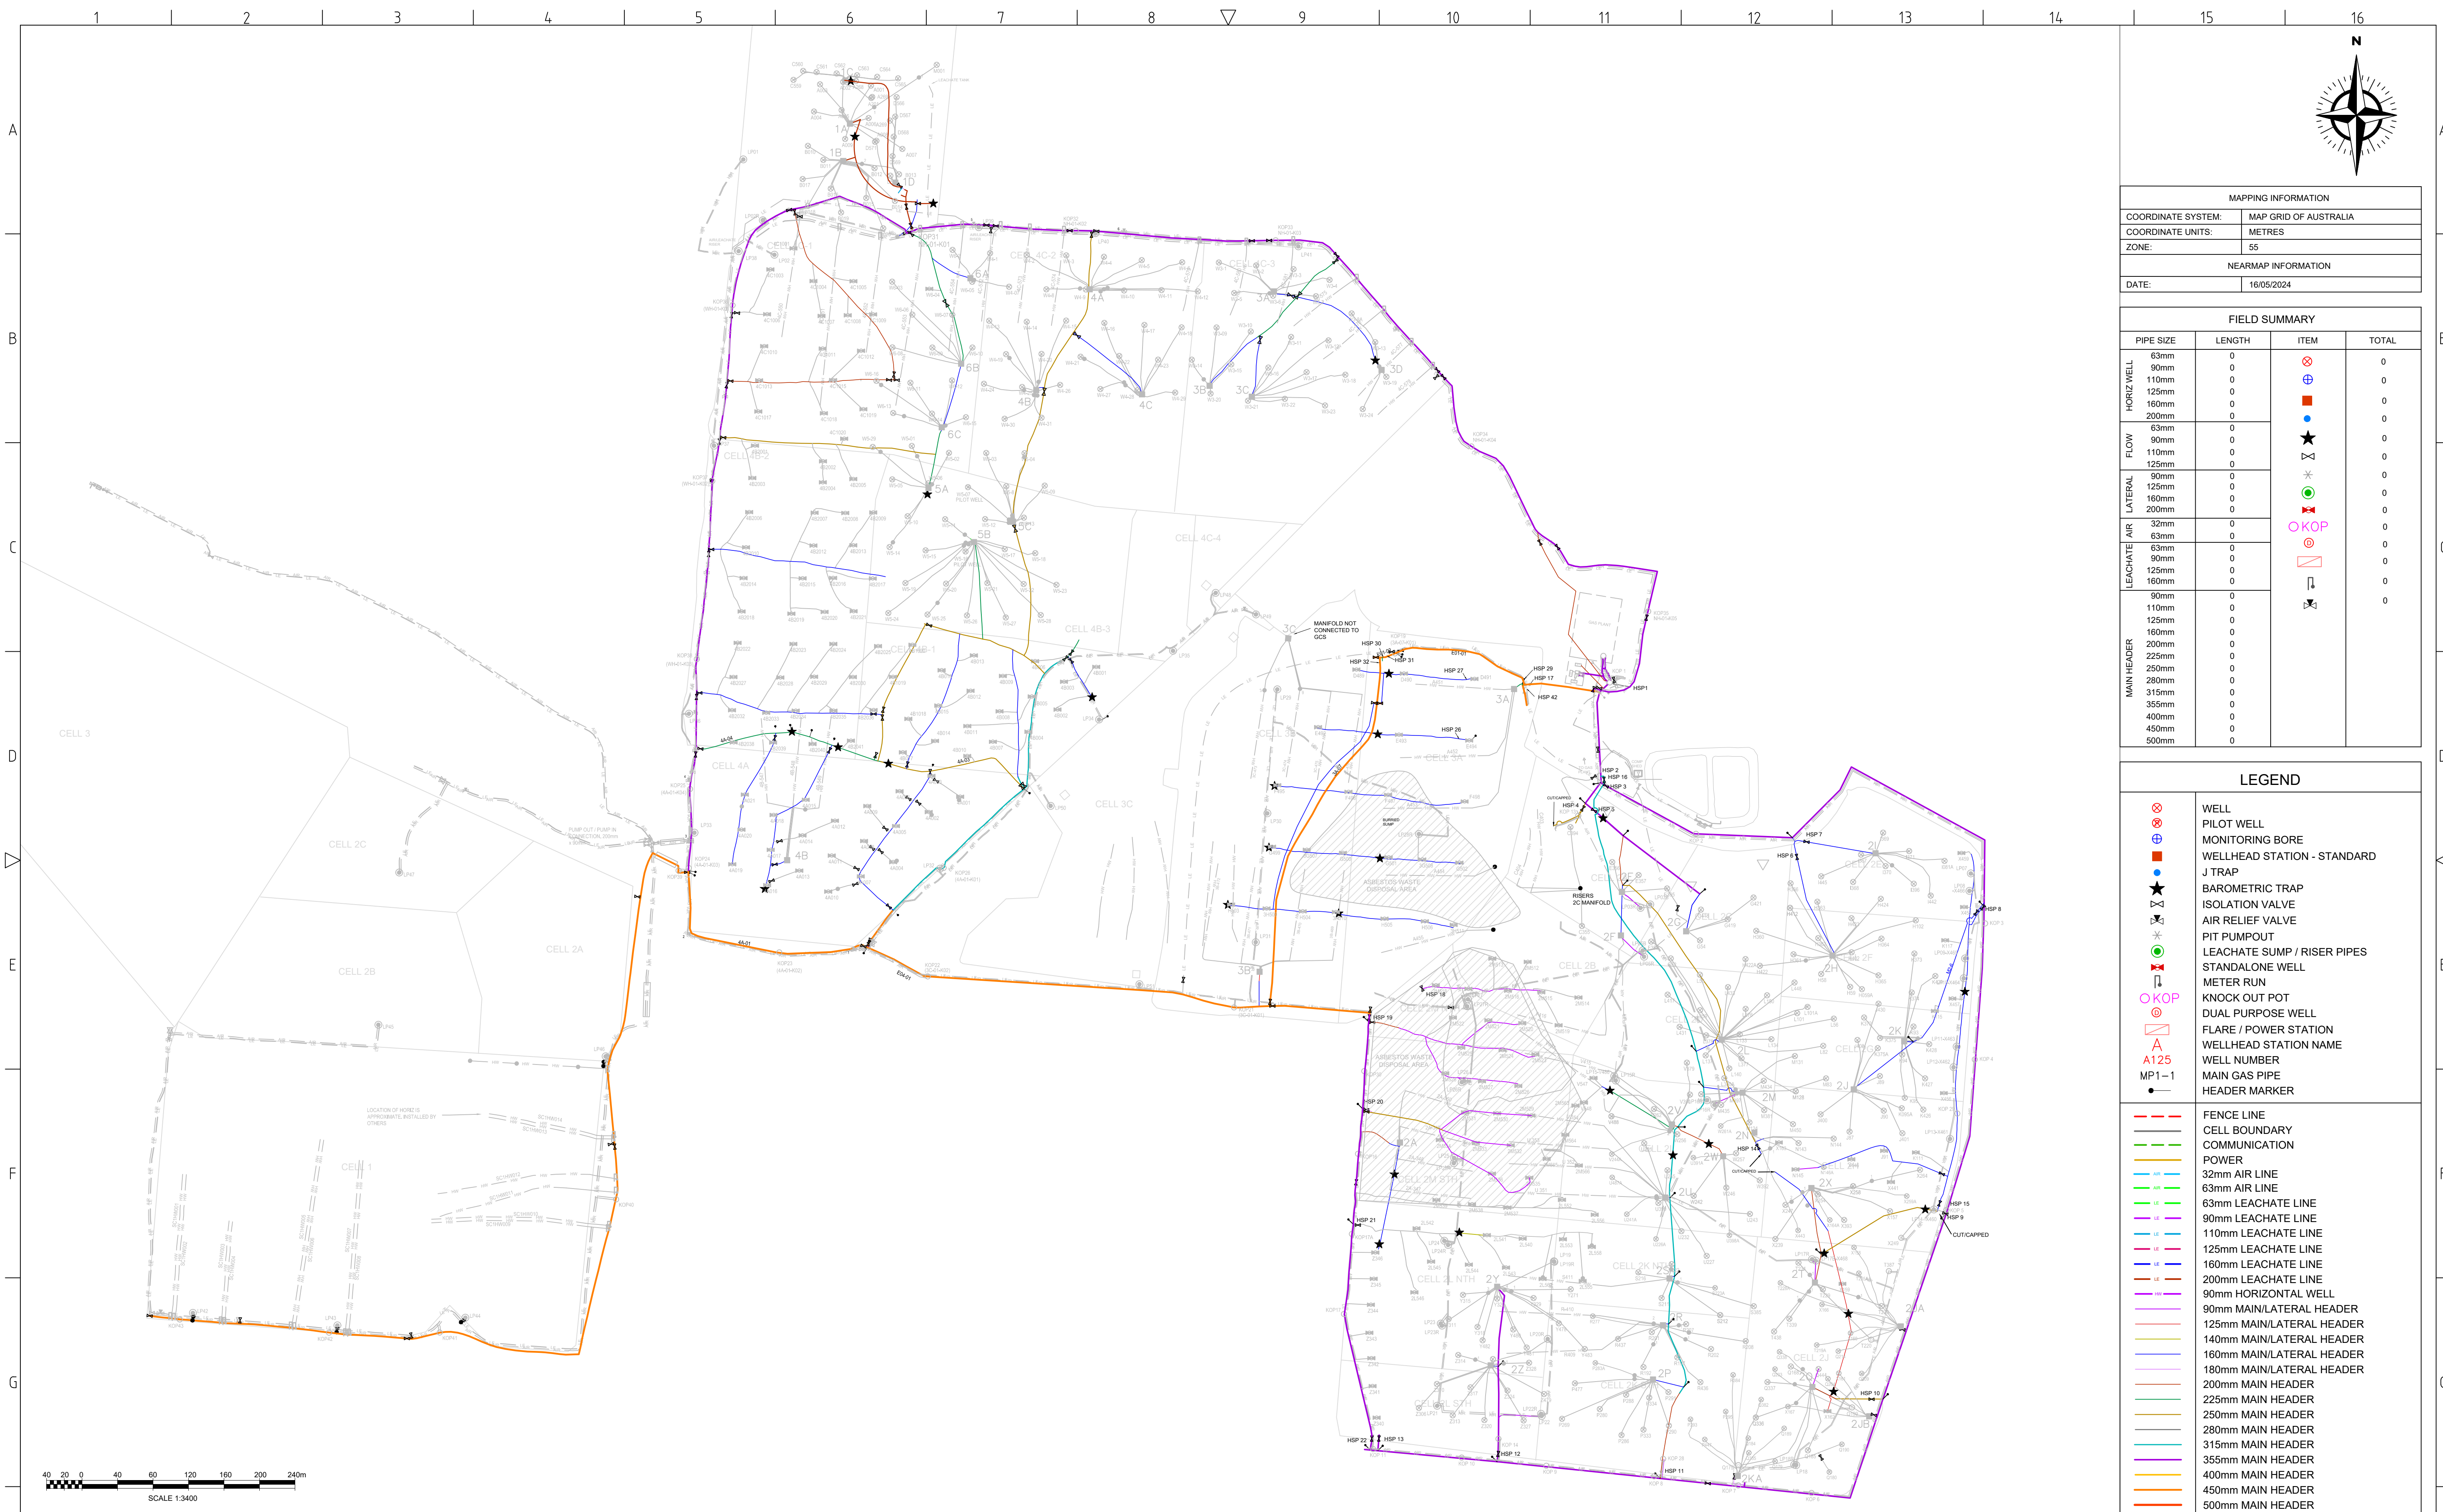
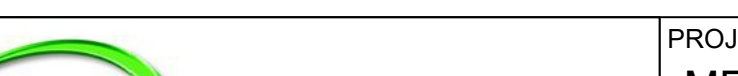
|                  |                                                         |------------------|---------------------------------------------------------|----|-----|-----|------------|-----|----------------------------------------------|----|-----|-----|------------|---------------------------------------------------------------------------------------|----------------------------------------------------------------------------------------------------------|------------------------------------------------------------------------------------|----|----------------------|--|--|--|--|
| 71               | ADDED HORIZONTAL WELL INSTALLATION                      | ZB | RB  | RB  | 5/03/2025  | 66  | ADDED 2M WELL CONNECTIONS, ASBESTOS BOUNDARY | ZB | RB  | RB  | 5/09/2024  |  | PROJECT:<br>MELBOURNE REGIONAL LANDFILL<br><br>DRAWING TITLE:<br><br>MRL-GCS_MAIN HEADERS<br>SITE LAYOUT | DRAWING No: MRL-GCS-001                                                            |    |                      |  |  |  |  |
| 70               | ADDED CELL 1 GCS INSTALLATION                           | ZB |     |     | 7/01/2025  | 65  | ADDED HORIZONTALS IN CELL 1                  | ZB | RB  | RB  | 16/08/2024 |                                                                                       |                                                                                                          | DRAWING TYPE: AS BUILT                                                             |    |                      |  |  |  |  |
| 69               | ADDED RELIEF VALVE ON LEACHATE LINE TO LP34, 35, 40, 41 | ZB | RB  | RB  | 6/11/2024  | 64  | ADDED MISSING VALVE IN STAGE 4               | ZB | RB  | RB  | 26/07/2024 |                                                                                       |                                                                                                          | DRAWN: ZB                                                                          |    | CKD: RB              |  |  |  |  |
| 68               | ADDED LP49, AIR / LEACHATE LINES                        | ZB | RB  | RB  | 29/10/2024 | 63  | ADDED 450mm MAIN HEADER IN STAGE 4           | ZB | RB  | RB  | 8/07/2024  |                                                                                       |                                                                                                          | DATE: 05/03/2025                                                                   |    | APP: RB              |  |  |  |  |
| 67               | 450mm HEADER BETWEEN STG3, STG4 RELOCATED.              | ZB | RB  | RB  | 13/09/2024 | 62  | ADDED GCS INSTALLATION 100 x WELLS, HEADERS  | ZB | RB  | RB  | 3/07/2024  |                                                                                       |                                                                                                          | DESIGNED: RB                                                                       |    | APP DATE: 05/03/2025 |  |  |  |  |
| REV              | DESCRIPTION                                             | BY | CKD | APP | DATE       | REV | DESCRIPTION                                  | BY | CKD | APP | DATE       |                                                                                       |                                                                                                          | 199C OSBORNE AVE, CLAYTON STH, VIC 3169<br>PH: (03) 9538 6200<br>www.runenergy.com |    |                      |  |  |  |  |
| REVISION HISTORY |                                                         |    |     |     |            |     | REVISION HISTORY                             |    |     |     |            |                                                                                       |                                                                                                          |                                                                                    |    |                      |  |  |  |  |
| 1                | 2                                                       | 3  | 4   | 5   | 6          | 7   | 8                                            | 9  | 10  | 11  | 12         | 13                                                                                    | 14                                                                                                       | 15                                                                                 | 16 |                      |  |  |  |  |