# As Built Drilling Log

| Job Number | Well ID | Drilling Team/Contractor |
|---|---|---|
| 10951-MRL Environmental Wells | X458 | Civil Group - Andy W |
| **Well Type** | **Responsible Person** | **Location** |
| Gas | Justin Brown | Melbourne Regional Landfill |
| **Well Completion Detail** | **Approved Drill Depth (mBGL)** | **Well Casing Diameter (mm)** |
| | 13.4 | 225 |

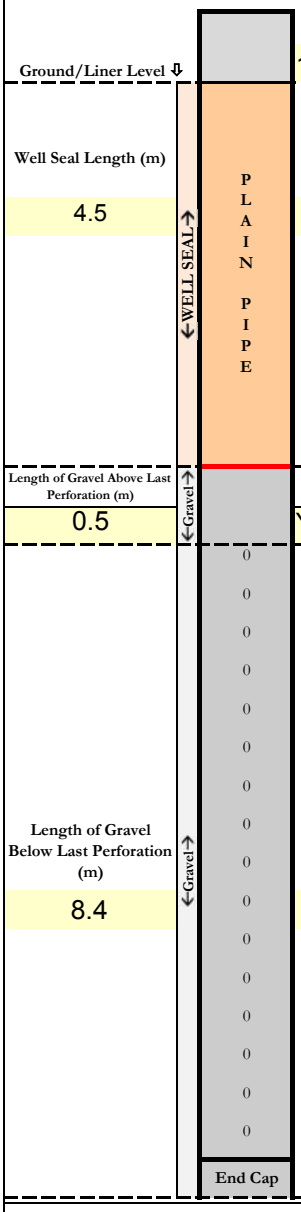


| Waste Stream and Comments |
|---|
| 0m - 1m = Damp brown soil |
| 1m - 2m = Damp soil / rubbish |
| 2m - 4m = Damp soil / rubbish |
| 4m - 6m = Damp black rubbish |
| 6m - 8m = Damp black rubbish |
| 8m - 10m = Damp black rubbish |
| 10m - 12m = Damp black rubbish |
| 12m - 13.4m = Wet black rubbish |

**Well Completion Summary**
Depths are Measurements of Metres Below Ground Level (mBGL) - Ground Level = 0

| | | | |
|---|---|---|---|
| Plain Pipe Start Depth (mBGL) | 0 | Completed Drilling Depth (mBGL) | Well Seal Type |
| Plain Pipe End Depth (mBGL) | 5 | 13.4 | Clay/Bentonite |
| Perf Pipe Start Depth (mBGL) | 5 | Completed Well Casing Depth (m) | Plastic Seal Type |
| Perf Pipe End Depth (mBGL) | 13.4 | 13.4 | Bag |
| Well Seal Start Depth (mBGL) | 0 | Well Casing Rating (PN) | End Cap Type |
| Well Seal End Depth (mBGL) | 4.5 | 16 | Butt-Welded |
| Gravel Start Depth (mBGL) | 4.5 | Location Left Clean (Yes/No) | Responsible Person Sign Off |
| Gravel End Depth (mBGL) | 13.4 | Yes | |