

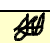
Job Number	Date Drilled		Well ID	Drilling Team/Contractor
11751-MRL LF	2019-07-27		3A-030/ 3-502	J.Hunt/ A. Williams
Well Type			Responsible Person	Location
Gas			Jaydyn Hunt	Melbourne Regional Landfi
Well Completion Detail			Approved Drill Depth (mBGL)	Well Casing Diameter (mm)
			33	225
Length of Riser (m)				
Waste Stream and Comments				
Ground/Liner Level ↓ 0-1m Dry capping material				
Well Seal Length (m) Plain Pipe Length (m)				
3 4				
1-4m Damp black rubbish				
4-7m Damp black rubbish				
7-10m Damp rubbish + cable				
10-13m Damp construction waste				
13-16m Damp construction rubbish				
Length of Gravel Above Last Perforation (m) Plastic Seal (Yes/No)				
1 yes				
16-19m Damp black rubbish + rope an wire				
Length of Gravel Below Last Perforation (m) Length of Perforated Pipe (m)				
27 27				
Only drilling to 31m as that's max depth of rig..				
End Cap				
Well Completion Summary				
Depths are Measurements of Metres Below Ground Level (mBGL) - Ground Level = 0				
Plain Pipe Start Depth (mBGL)	0	Completed Drilling Depth (mBGL)	Well Seal Type	
Plain Pipe End Depth (mBGL)	4	31	Clay/Bentonite	
Perf Pipe Start Depth (mBGL)	4	Completed Well Casing Depth (m)	Plastic Seal Type	
Perf Pipe End Depth (mBGL)	31	31	Bag	
Well Seal Start Depth (mBGL)	0	Well Casing Rating (PN)	End Cap Type	
Well Seal End Depth (mBGL)	3	16	Butt-Welded	
Gravel Start Depth (mBGL)	3	Location Left Clean (Yes/No)	Responsible Person Sign Off	
Gravel End Depth (mBGL)	31	Yes		

Photo - Take Photo of Completed Well

