

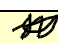
Job Number	Date Drilled		Well ID	Drilling Team/Contractor
11751-MRL LF	2019-07-26		3A-029/ 3-501	Jaydyn Hunt/ Andy William
Well Type			Responsible Person	Location
Gas			Jaydyn Hunt	Melbourne Regional Landfi
Well Completion Detail			Approved Drill Depth (mBGL)	Well Casing Diameter (mm)
			33	225
Length of Riser (m)			Waste Stream and Comments	
Ground/Liner Level ↓			0-1m Dry cap	
Well Seal Length (m)	PLAIN PIPE ↓ WELL SEAL →	Plain Pipe Length (m)	1-4m Dry rubbish + carpet	
3		4	4-7m Dry rubbish	
			7-10m Damp rubbish	
			10-13m Damp black rubbish	
			13-16m Dry black rubbish + wire an steel	
Length of Gravel Above Last Perforation (m)		Plastic Seal (Yes/No)		
1		yes	16-19m Damp black construction waste	
			19-21m Damp waste	
			21-24m Damp construction waste	
			24-28m Damp waste + wire	
Length of Gravel Below Last Perforation (m)	↓ Gravel →	Length of Perforated Pipe (m)	28-31m Damp black rubbish	
27		27	31m is completed depth as that's max depth of the r	
End Cap				
Well Completion Summary				
Depths are Measurements of Metres Below Ground Level (mBGL) - Ground Level = 0				
Plain Pipe Start Depth (mBGL)	0	Completed Drilling Depth (mBGL)	Well Seal Type	
Plain Pipe End Depth (mBGL)	4	31	Clay/Bentonite	
Perf Pipe Start Depth (mBGL)	4	Completed Well Casing Depth (m)	Plastic Seal Type	
Perf Pipe End Depth (mBGL)	31	31	Bag	
Well Seal Start Depth (mBGL)	0	Well Casing Rating (PN)	End Cap Type	
Well Seal End Depth (mBGL)	3	16	Butt-Welded	
Gravel Start Depth (mBGL)	3	Location Left Clean (Yes/No)	Responsible Person Sign Off	
Gravel End Depth (mBGL)	31	Yes		

Photo - Take Photo of Completed Well

