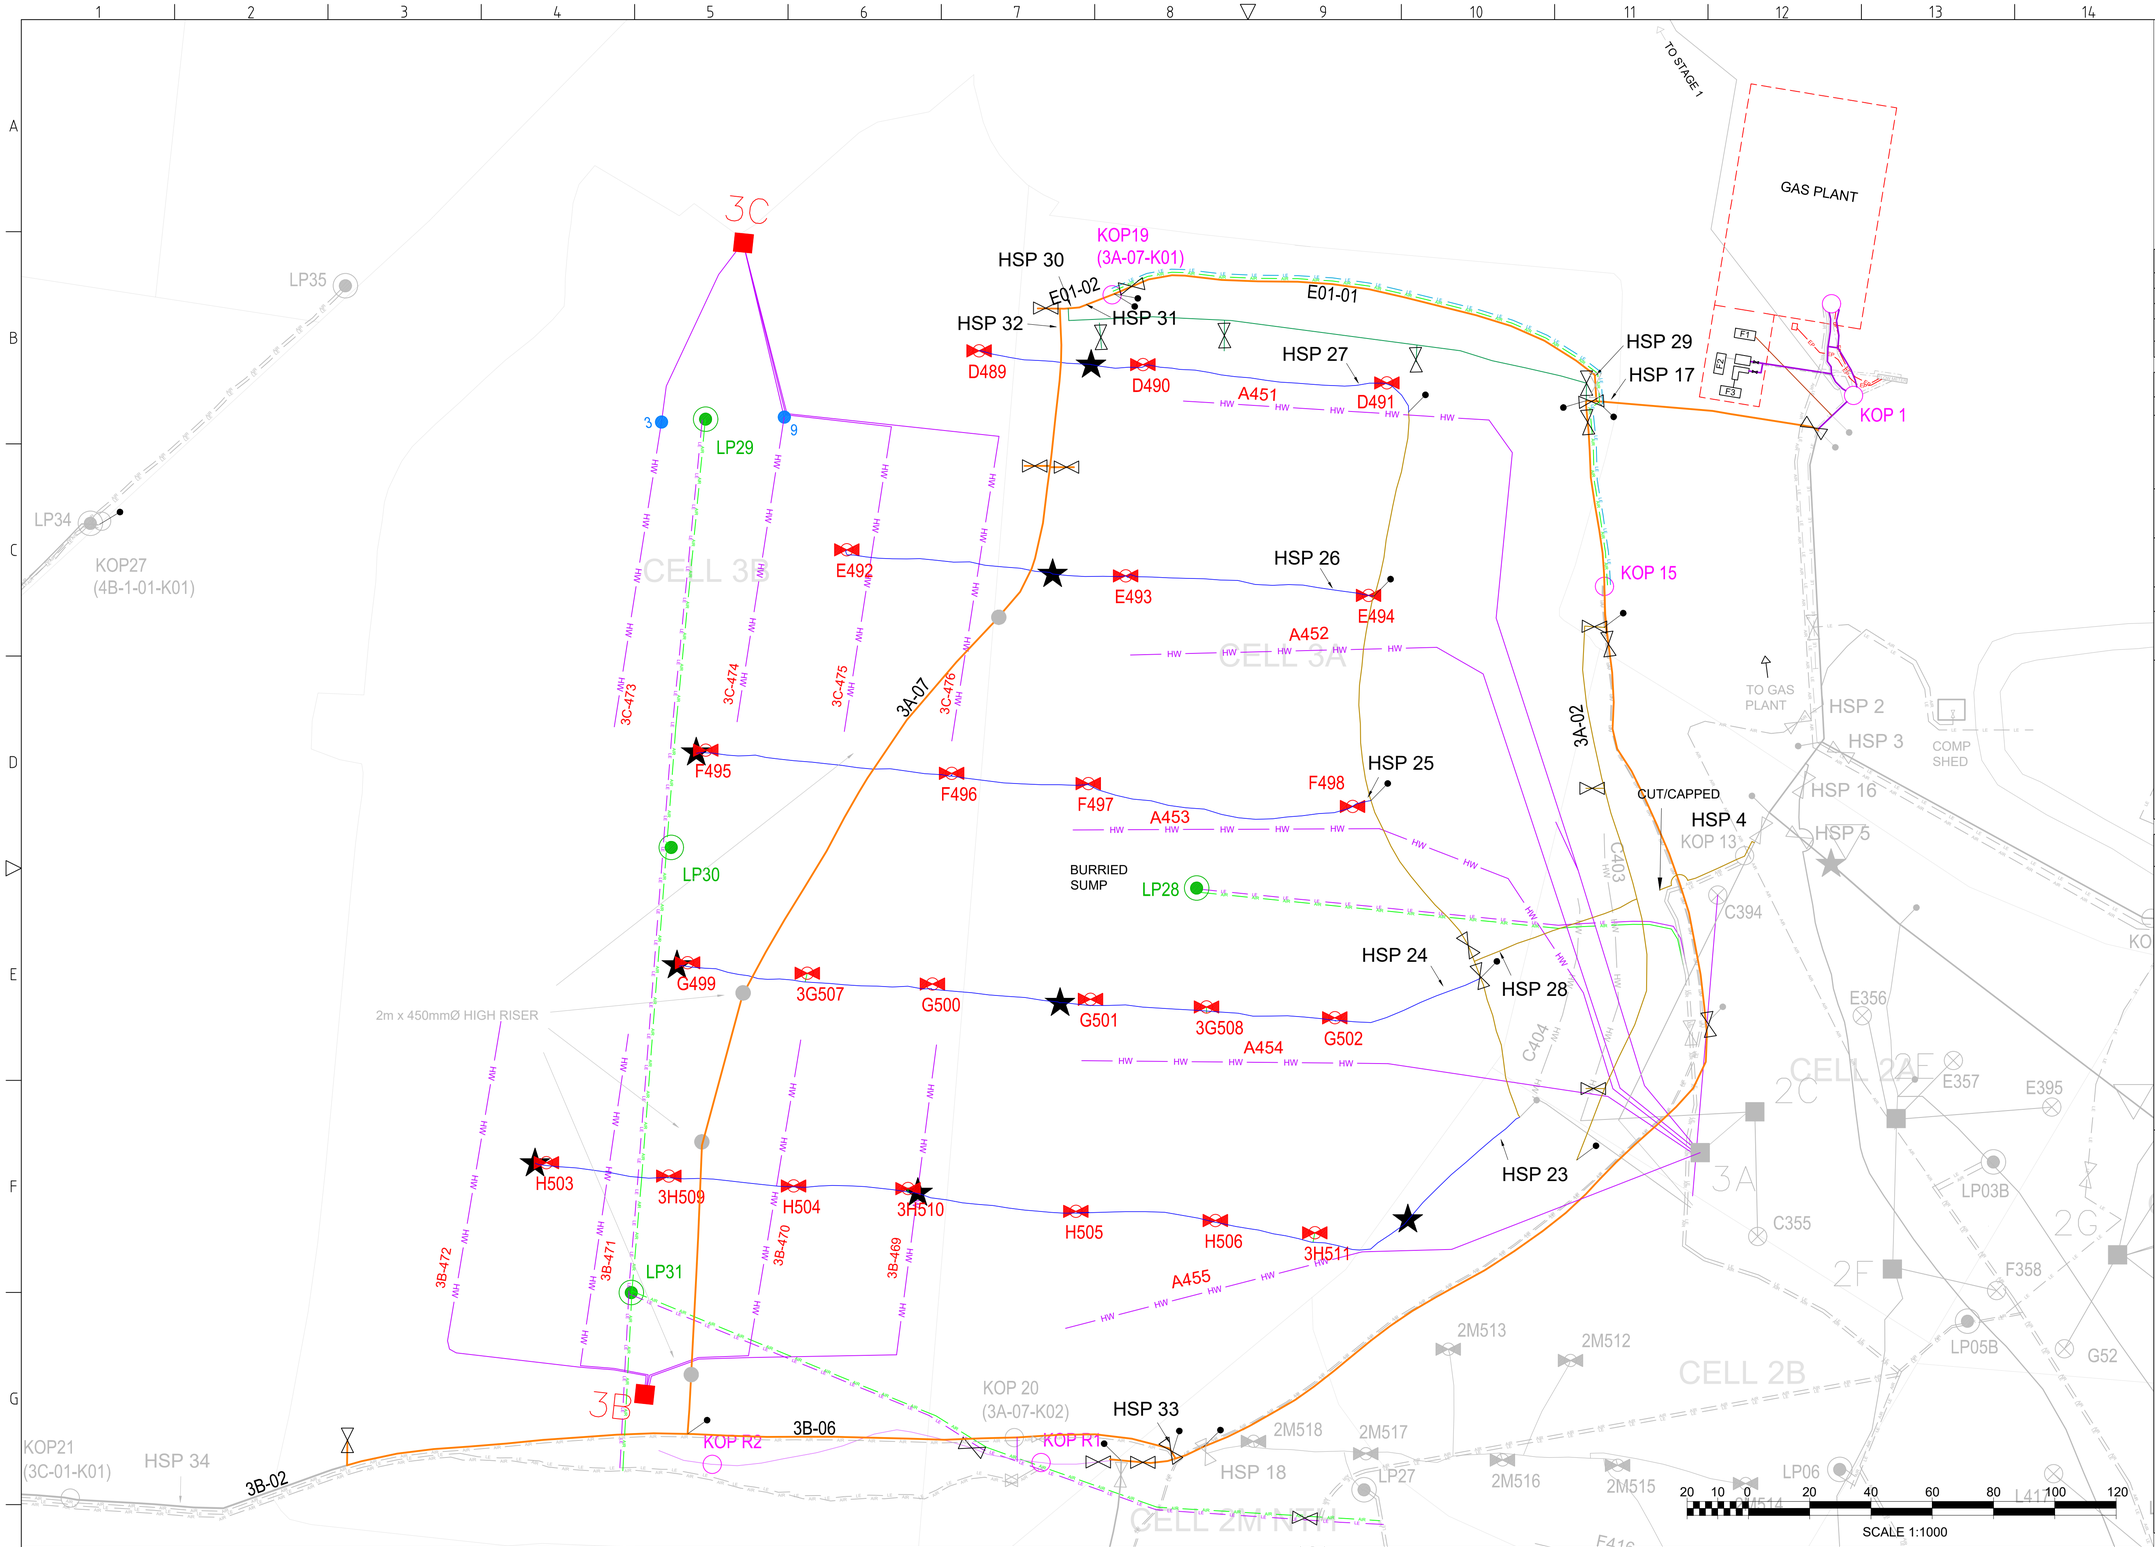

N

MAPPING INFORMATION	
Coordinate System:	Map Grid of Australia
Coordinate Units:	Metres
Zone:	55
NEARMAP INFORMATION	
Date:	04/02/2021

FIELD SUMMARY

PIPE SIZE	LENGTH	ITEM	TOTAL
HORIZ WELL 63mm	0		0
HORIZ WELL 90mm	0		0
HORIZ WELL 110mm	0		0
HORIZ WELL 125mm	0		0
HORIZ WELL 160mm	0		0
HORIZ WELL 200mm	0		0
FLOW 63mm	0		0
FLOW 90mm	0		0
FLOW 110mm	0		0
FLOW 125mm	0		0
LATERAL 90mm	0		0
LATERAL 125mm	0		0
LATERAL 160mm	0		0
LATERAL 200mm	0		0
AIR 32mm	0	KOP	0
AIR 63mm	0		0
LEACHATE 63mm	0		0
LEACHATE 90mm	0		0
LEACHATE 125mm	0		0
LEACHATE 160mm	0		0
MAIN HEADER 90mm	0		
MAIN HEADER 110mm	0		
MAIN HEADER 125mm	0		
MAIN HEADER 160mm	0		
MAIN HEADER 200mm	0		
MAIN HEADER 225mm	0		
MAIN HEADER 250mm	0		
MAIN HEADER 280mm	0		
MAIN HEADER 315mm	0		
MAIN HEADER 355mm	0		
MAIN HEADER 400mm	0		
MAIN HEADER 450mm	0		
MAIN HEADER 500mm	0		

LEGEND

- WELL
- MONITORING BORE
- WELLHEAD STATION - STANDARD
- J TRAP
- BAROMETRIC TRAP
- ISOLATION VALVE
- PIT PUMPOUT
- LEACHATE SUMP / RISER PIPES
- STANDALONE WELL
- KOP — KNOCK OUT POT
- DUAL PURPOSE WELL
- FLARE / POWER STATION
- A — WELLHEAD STATION NAME
- A125 — WELL NUMBER
- MP1-1 — MAIN GAS PIPE
- HEADER MARKER
- FENCE LINE
- CELL BOUNDARY
- COMMUNICATION
- POWER
- AIR — 32mm AIR LINE
- AIR — 63mm AIR LINE
- LE — 63mm LEACHATE LINE
- LE — 90mm LEACHATE LINE
- LE — 110mm LEACHATE LINE
- LE — 125mm LEACHATE LINE
- LE — 160mm LEACHATE LINE
- HW — 90mm HORIZONTAL WELL
- 90mm MAIN/LATERAL HEADER
- 125mm MAIN/LATERAL HEADER
- 140mm MAIN/LATERAL HEADER
- 160mm MAIN/LATERAL HEADER
- 180mm MAIN/LATERAL HEADER
- 200mm MAIN HEADER
- 225mm MAIN HEADER
- 250mm MAIN HEADER
- 280mm MAIN HEADER
- 315mm MAIN HEADER
- 355mm MAIN HEADER
- 400mm MAIN HEADER
- 450mm MAIN HEADER
- 500mm MAIN HEADER

REV	DESCRIPTION	BY	CKD	APP	DATE
34	STAGE 2 GCS INSTALLATION	ZB	RC	RC	5/02/2020

REVISION HISTORY

REV	DESCRIPTION	BY	CKD	APP	DATE
33	STAGE 4 GCS INSTALLATION	ZB	RC	RC	4/02/2020
32	ADDED HEADER MARKERS AND PIPE INTERSECTIONS	ZB	RC	RC	
31	GCS MODIFICATION. HEADER LINE INSTALLATION	ZB	RC	RC	
30	AIR/LEACHATE INSTALLATION. CELL 4C	ZB	RC	RC	3/07/2020
29	AIR/LEACHATE INSTALLATION. LP36/LP37	ZB	RC	RC	20/05/2020

REVISION HISTORY

runenergy

199C OSBORNE AVE, CLAYTON STH, VIC 3169
PH: (03) 9538 6200
www.runenergy.com

PROJECT: MELBOURNE REGIONAL LANDFILL

DRAWING TITLE: MRL ASBUILT STAGE 3 SITE LAYOUT

DRAWING No:	MRL-GCS-004
DRAWING TYPE:	ASBUILT
DRAWN: ZB	CKD: RC
DATE: 05/02/2021	APP: RC
DESIGNED: RC	APP DATE: 05/02/2021
SCALE: 1:1000	SHEET: 1 of 4
REV: 34	SIZE: A1