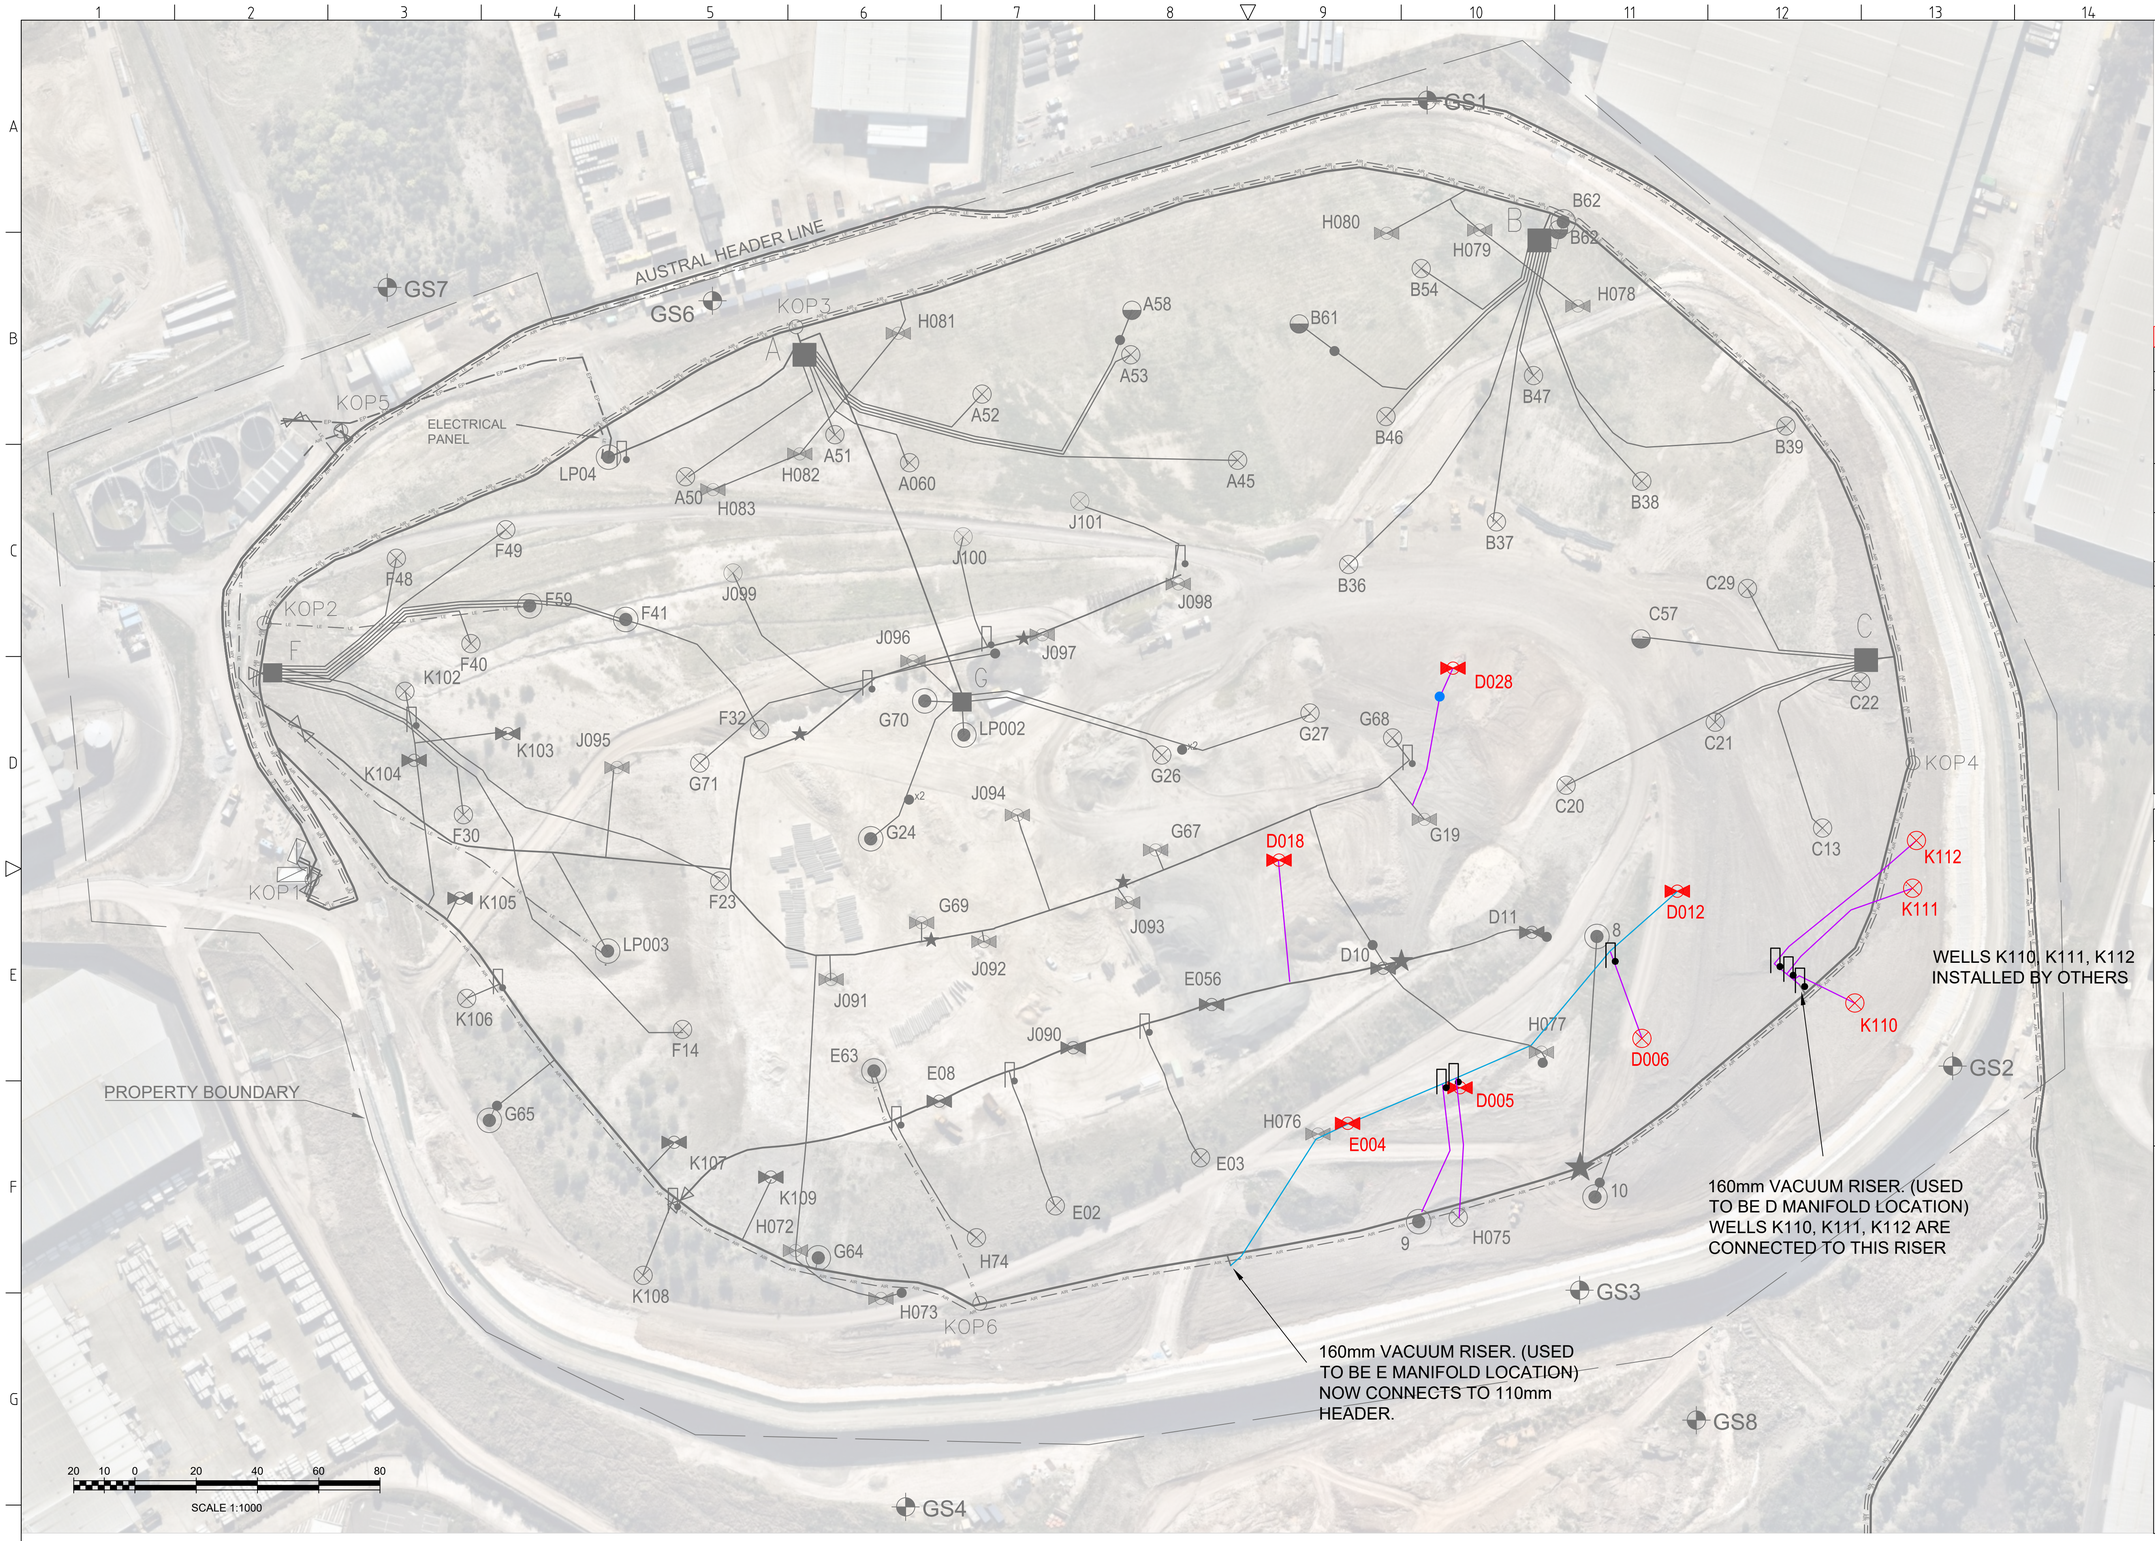

NEARMAP IMAGE FROM AUG 21, 2022

MAP GRID	MGA 56

FIELD SUMMARY

PIPE SIZE		LENGTH	ITEM	TOTAL
HORIZ WELL	63mm	0		0
	90mm	0		
	110mm	0		0
	125mm	0		
	160mm	0		0
	200mm	0		0
FLOW	63mm	0		
	90mm	340		0
	110mm	0		0
	125mm	0		
LATERAL	90mm	0		0
	125mm	0		0
	160mm	0		0
	200mm	0		0
AIR	32mm	0	KOP	0
	63mm	0		0
LEACHATE	63mm	0		0
	90mm	0		0
	125mm	0		0
	160mm	0		0
MAIN HEADER	90mm	0		0
	110mm	200		
	125mm	0		6
	160mm	0		
	200mm	0		
	225mm	0		
	250mm	0		
	280mm	0		
	315mm	0		
	355mm	0		
	400mm	0		
	450mm	0		
	500mm	0		

LEGEND

	WELL
	MONITORING BORE
	WELLHEAD STATION - STANDARD
	J TRAP
	BAROMETRIC TRAP
	ISOLATION VALVE
	PIT PUMPOUT
	LEACHATE SUMP / RISER PIPES
	STANDALONE WELL
KOP	KNOCKOUT POT
	DUAL PURPOSE WELL
	FLARE/POWER STATION
A	WELLHEAD STATION NAME
A125	WELL NUMBER
MP1–1	MAIN GAS PIPE
	GAS MONITORING BORE
	LEACHATE RISER
	METER RUN
	FENCE LINE
	CELL BOUNDARY
	COMMUNICATION
EP	POWER
	63mm FLOW LINE
AIR	32mm AIR LINE
AIR	63mm AIR LINE
LE	63mm LEACHATE LINE
LE	90mm LEACHATE LINE
LE	125mm LEACHATE LINE
LE	160mm LEACHATE LINE
HW	90mm HORIZONTAL WELL
	90mm MAIN LATERAL HEADER
	110mm MAIN/LATERAL HEADER
	125mm MAIN/LATERAL HEADER
	160mm MAIN HEADER
	200mm MAIN HEADER
	225mm MAIN HEADER
	250mm MAIN HEADER
	280mm MAIN HEADER
	315mm MAIN HEADER
	355mm MAIN HEADER
	400mm MAIN HEADER
	450mm MAIN HEADER
	500mm MAIN HEADER

REVISION HISTORY

REV	DESCRIPTION	BY	CKD	APP	DATE
16	ADDED GCS INSTALLATION, 110mm HEADER LINE	ZB	RC	RC	14/12/2023
15	GCS INSTALLATION, ADDED 8 WELLS / FLOW LINES.	ZB	RC	RC	23/12/2022
14	ADDED GCS INSTALLATION. REMOVED WELL STATIONS D, E	ZB	RC	RC	14/12/2022
13	ADDED LP04, 90mm FLOW LINE, LEACHATE DISCHARGE, DATA	ZB	RB	RB	05/09/2022
12	GCS INSTALLATION AUSTRAL HEADER LINE	ZB	RB	RB	24/12/2020

REVISION HISTORY

REV	DESCRIPTION	BY	CKD	APP	DATE
11	90MM LEACHATE LINE INSTALLED FROM LP003 TO TANKS	ZB	RC	RC	19/10/2020
10	SOUTHERN MAIN HEADER RELOCATED.	ZB	RC	RC	17/11/2020
9	REVISED RING MAIN HEADER LOCATION	ZB	AD	AD	17/09/2020
8	ADDED AUSTRAL HEADER LINE	ZB	AD	AD	25/08/2020
7	REVISED WELL ID LP001. CHANGED TO LP003	ZB	AD	AD	17/08/2020

runenergy
199C OSBORNE AVE, CLAYTON STH, VIC 3169
PH: (03) 9538 6200
www.runenergy.com

PROJECT: ERSKINE PARK LANDFILL GAS PROJECT

DRAWING TITLE: GAS COLLECTION SYSTEM SITE LAYOUT

DRAWING No: 019-AB-001

DRAWING TYPE: AS BUILT

DRAWN: ZB		CKD: RC	
DATE: 14/02/2023		APP: RC	
DESIGNED: RC		APP DATE: 14/02/2023	
SCALE: 1:1000	SHEET: 1 of 1	REV: 16	SIZE: A1