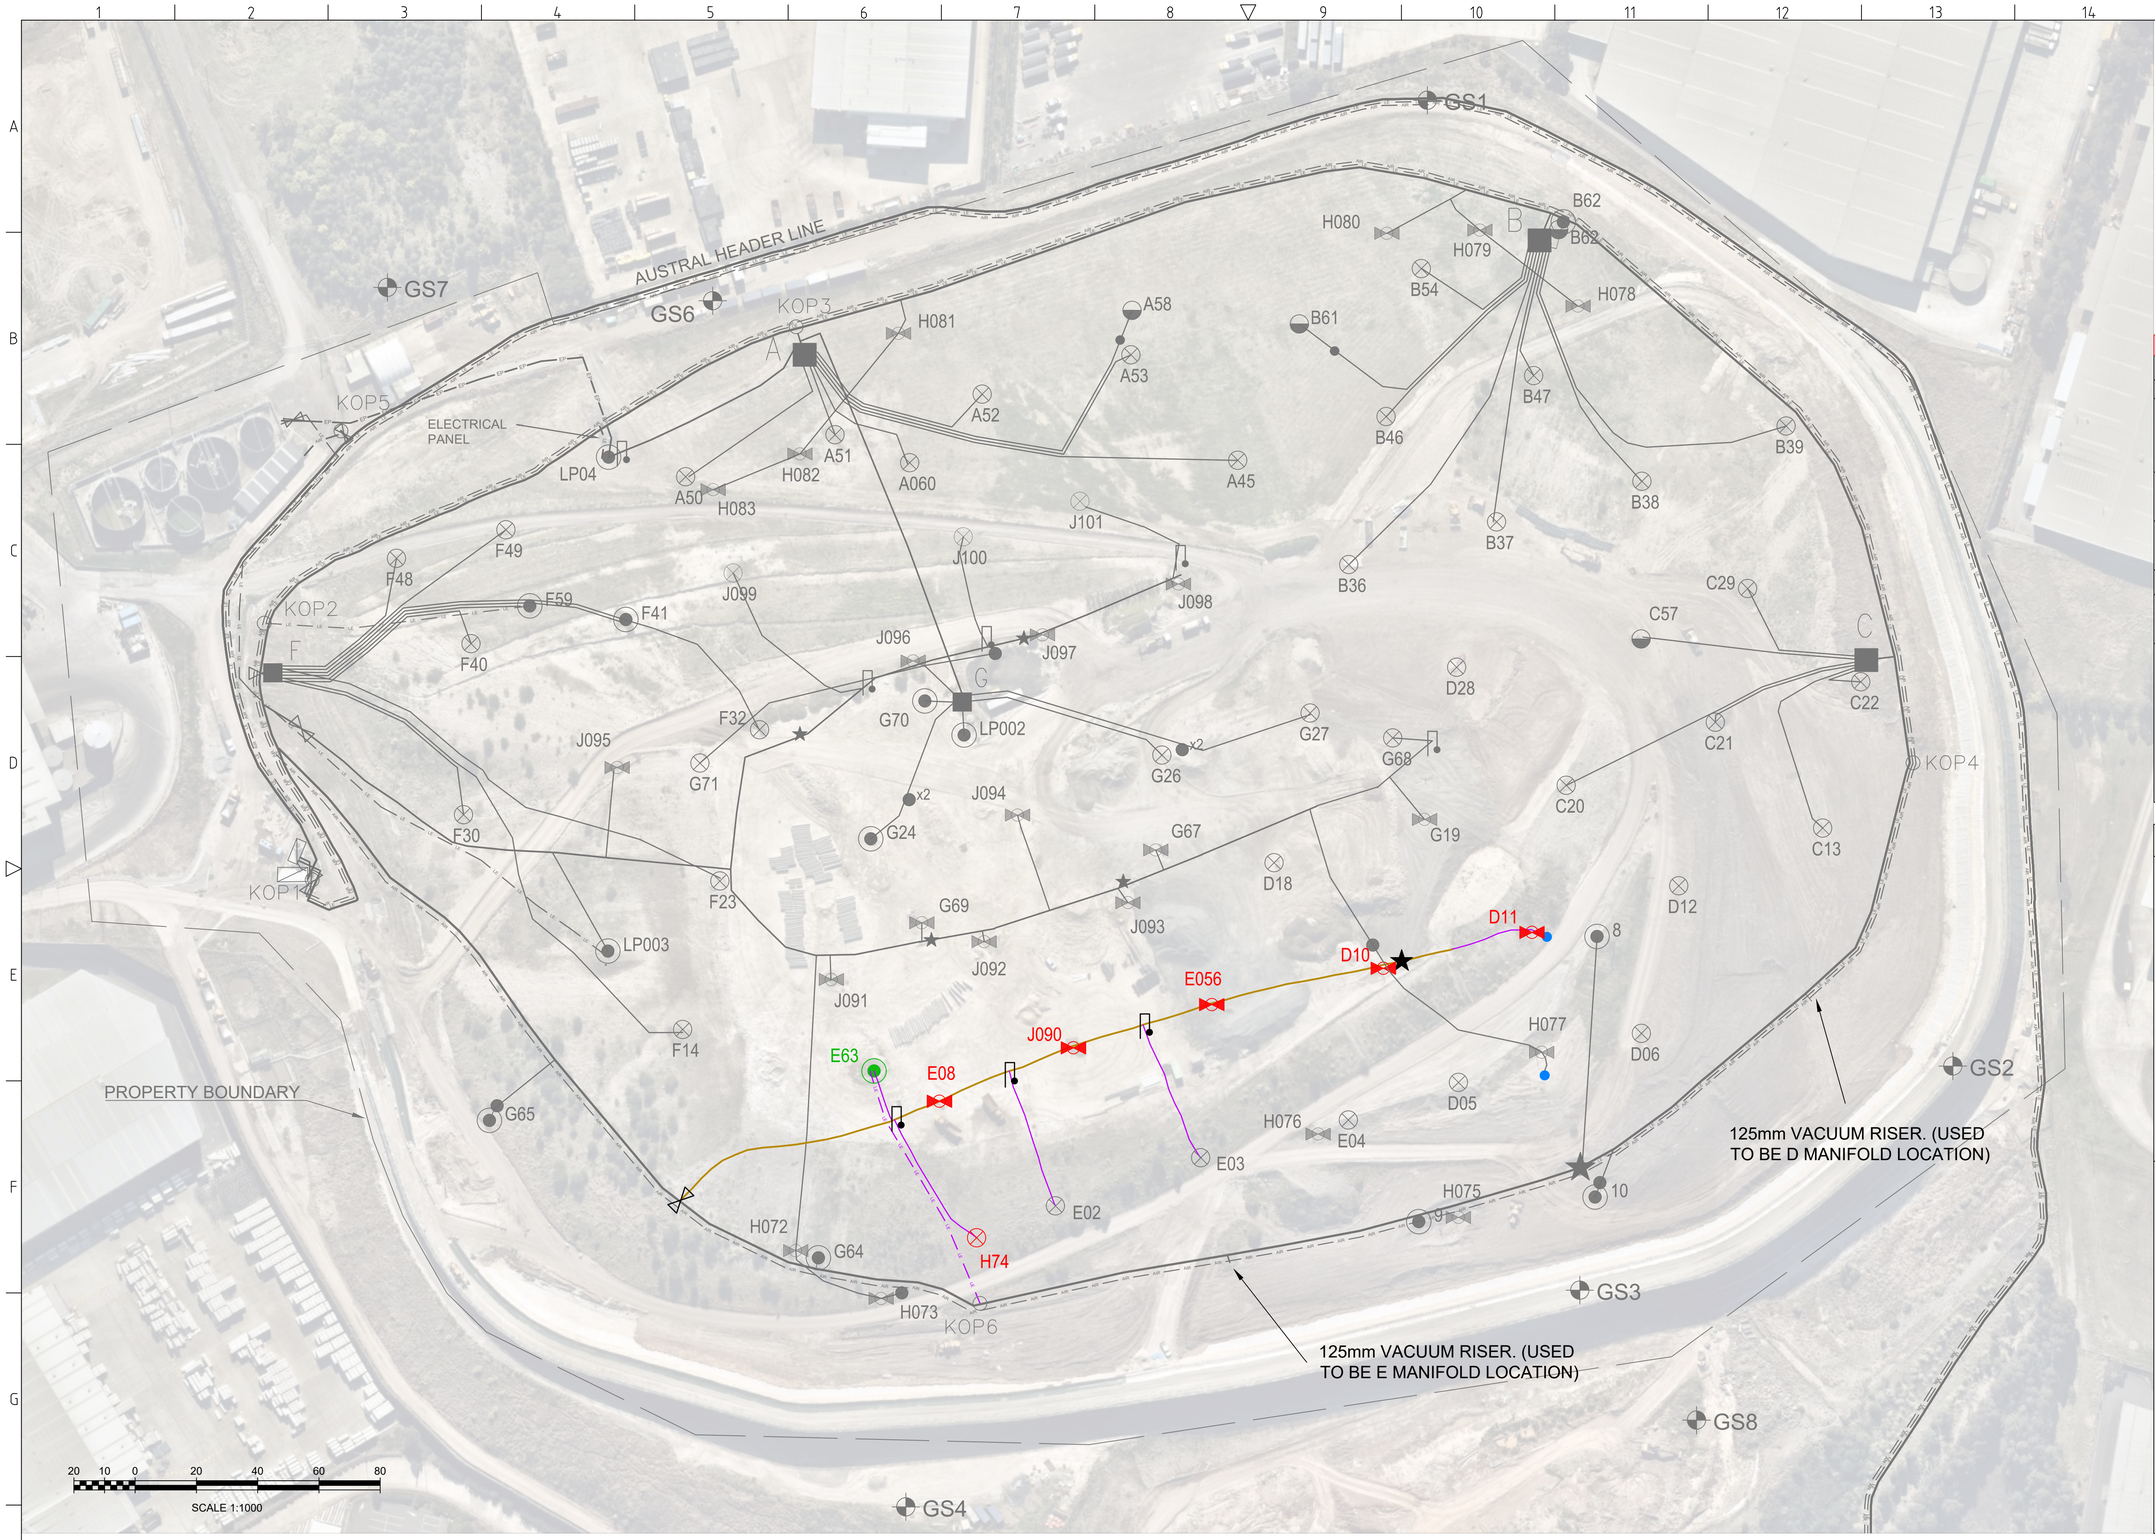

NEARMAP IMAGE FROM AUG 21, 2022

MAP GRID	MGA 56

FIELD SUMMARY

	PIPE SIZE	LENGTH	ITEM	TOTAL
HORIZ WELL	63mm	0	⊗	0
	90mm	0	⊕	0
	110mm	0	■	0
	125mm	0	●	2
	160mm	0	★	1
	200mm	0	⋈	1
FLOW	63mm	0	✳	0
	90mm	195	◉	0
	110mm	0	⋈	0
	125mm	0	OKOP	0
LATERAL	90mm	0	◎	0
	125mm	0	▱	0
	160mm	0	◒	0
	200mm	0	✳	0
AIR	32mm	0	⎍	3
	63mm	0		
LEACHATE	63mm	0		
	90mm	85		
	125mm	0		
	160mm	0		
MAIN HEADER	90mm	0		
	110mm	0		
	125mm	0		
	160mm	0		
	200mm	0		
	225mm	0		
	250mm	350		
	280mm	0		
	315mm	0		
	355mm	0		
	400mm	0		
	450mm	0		
	500mm	0		

LEGEND

⊗	WELL
⊕	MONITORING BORE
■	WELLHEAD STATION - STANDARD
●	J TRAP
★	BAROMETRIC TRAP
⋈	ISOLATION VALVE
✳	PIT PUMPOUT
◉	LEACHATE SUMP / RISER PIPES
▱	STANDALONE WELL
OKOP	KNOCKOUT POT
◎	DUAL PURPOSE WELL
◒	FLARE/POWER STATION
A	WELLHEAD STATION NAME
A125	WELL NUMBER
MP1-1	MAIN GAS PIPE
✳	GAS MONITORING BORE
◒	LEACHATE RISER
⎍	METER RUN
	FENCE LINE
	CELL BOUNDARY
	COMMUNICATION
EP	POWER
	63mm FLOW LINE
AIR	32mm AIR LINE
AIR	63mm AIR LINE
LE	63mm LEACHATE LINE
LE	90mm LEACHATE LINE
LE	125mm LEACHATE LINE
LE	160mm LEACHATE LINE
HW	90mm HORIZONTAL WELL
	90mm MAIN LATERAL HEADER
	125mm MAIN/LATERAL HEADER
	160mm MAIN HEADER
	200mm MAIN HEADER
	225mm MAIN HEADER
	250mm MAIN HEADER
	280mm MAIN HEADER
	315mm MAIN HEADER
	355mm MAIN HEADER
	400mm MAIN HEADER
	450mm MAIN HEADER
	500mm MAIN HEADER

REVISION HISTORY

REV	DESCRIPTION	BY	CKD	APP	DATE
14	ADDED GCS INSTALLATION. REMOVED WELL STATIONS D, E	ZB	RC	RC	14/12/2022
13	ADDED LP04, 90mm FLOW LINE, LEACHATE DISCHARGE, DATA	ZB	RB	RB	05/09/2022
12	GCS INSTALLATION AUSTRAL HEADER LINE	ZB	RB	RB	24/12/2020

REVISION HISTORY

REV	DESCRIPTION	BY	CKD	APP	DATE
11	90MM LEACHATE LINE INSTALLED FROM LP003 TO TANKS	ZB	RC	RC	19/10/2020
10	SOUTHERN MAIN HEADER RELOCATED.	ZB	RC	RC	17/11/2020
9	REVISED RING MAIN HEADER LOCATION	ZB	AD	AD	17/09/2020
8	ADDED AUSTRAL HEADER LINE	ZB	AD	AD	25/08/2020
7	REVISED WELL ID LP001. CHANGED TO LP003	ZB	AD	AD	17/08/2020

runenergy
199C OSBORNE AVE, CLAYTON STH, VIC 3169
PH: (03) 9538 6200
www.runenergy.com

PROJECT: ERSKINE PARK LANDFILL GAS PROJECT

DRAWING TITLE: GAS COLLECTION SYSTEM SITE LAYOUT

DRAWING No:	019-AB-001		
DRAWING TYPE:	JOB AS BUILT		
DRAWN: ZB	CKD: RC		
DATE: 14/12/2022	APP: RC		
DESIGNED: RC	APP DATE: 14/12/2022		
SCALE: 1:1000	SHEET: 1 of 1	REV: 14	SIZE: A1